



Kellergeschoss

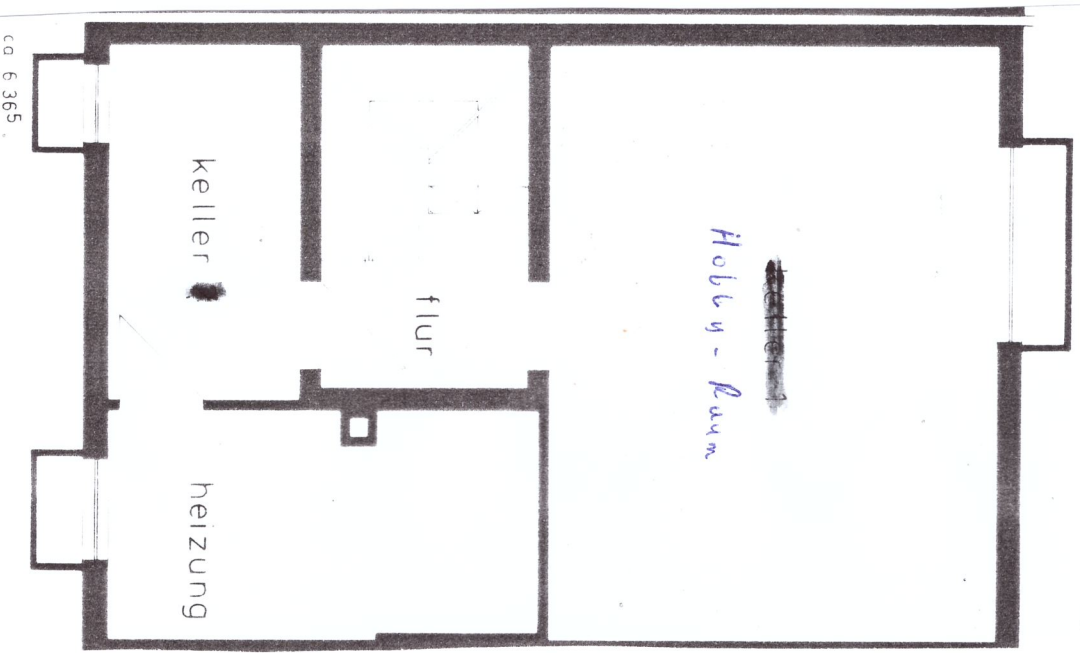


ca 6 365

EG

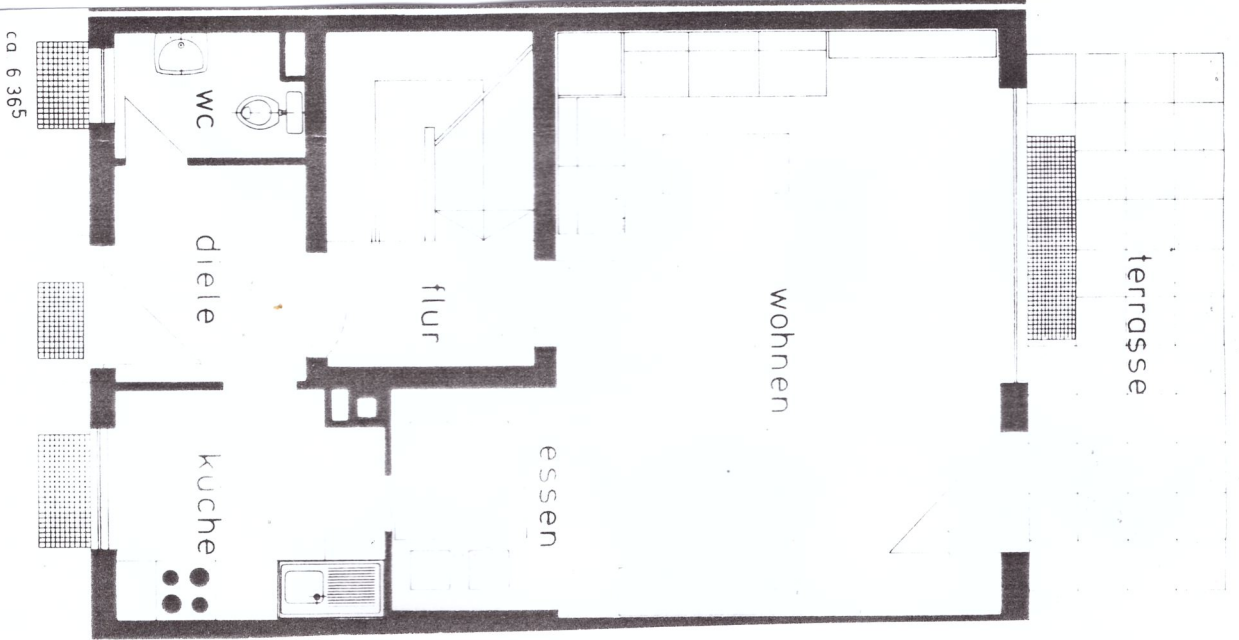


ca 6 365

06

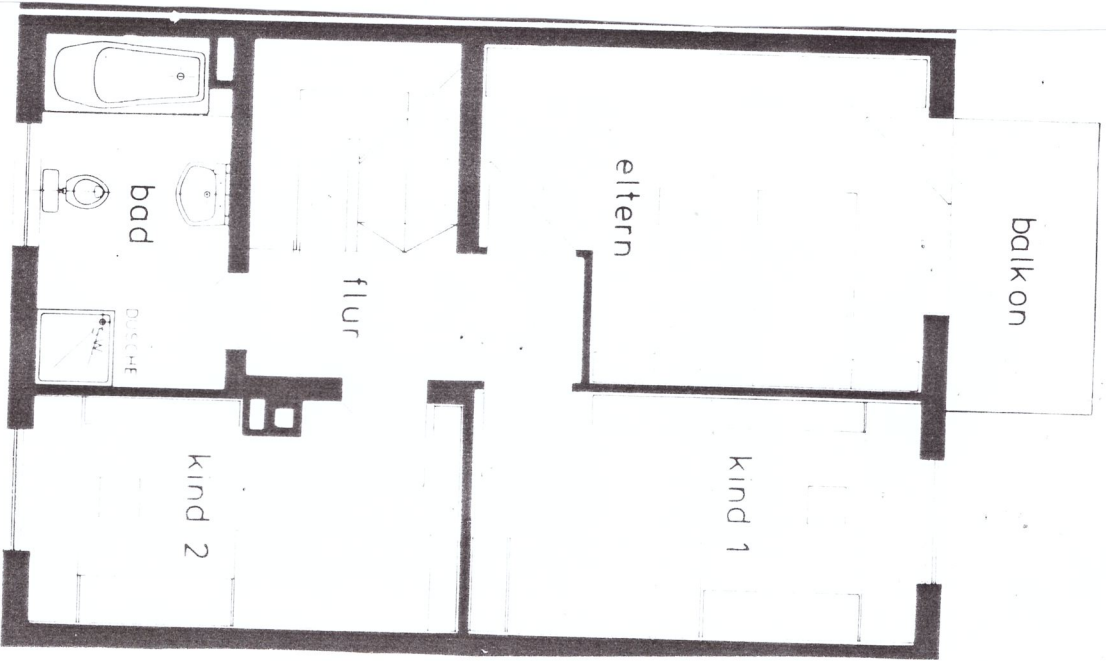

ca 6 365

06

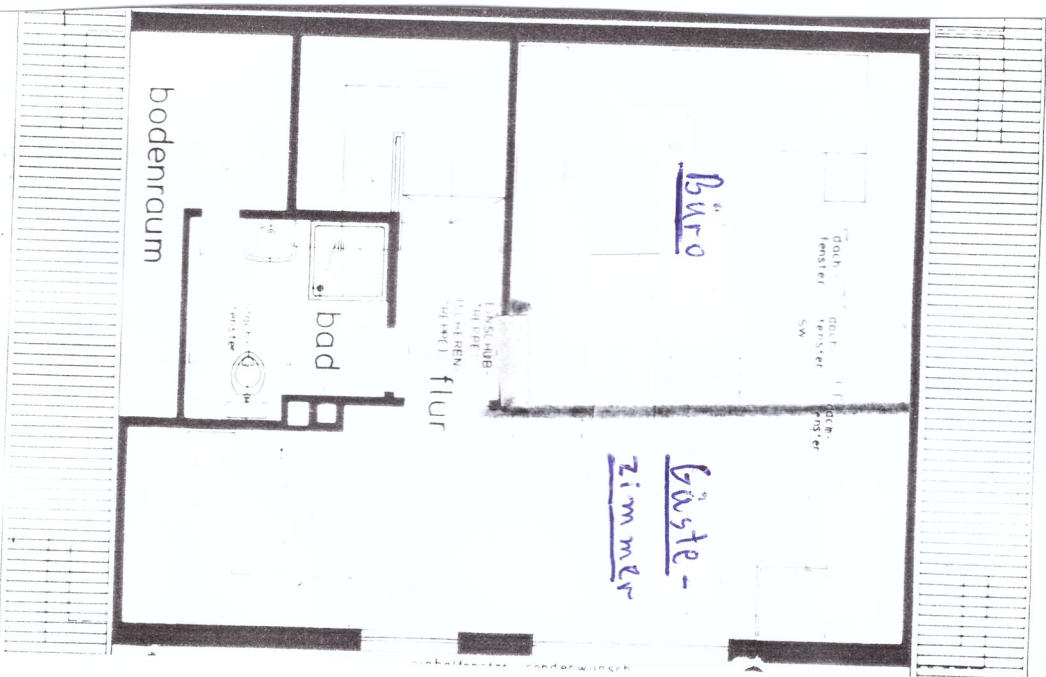

ca 6 425