


200 20 m

4.05	4.05	2.25	2.20	2.00	4.45
4.05		2.25	2.20	3.00	3.43


2.00	1.80	3.50
1.80	1.25	
	1.80	

3.25	3.50	2.20	3.80	3.00
		1.45		
				3.00

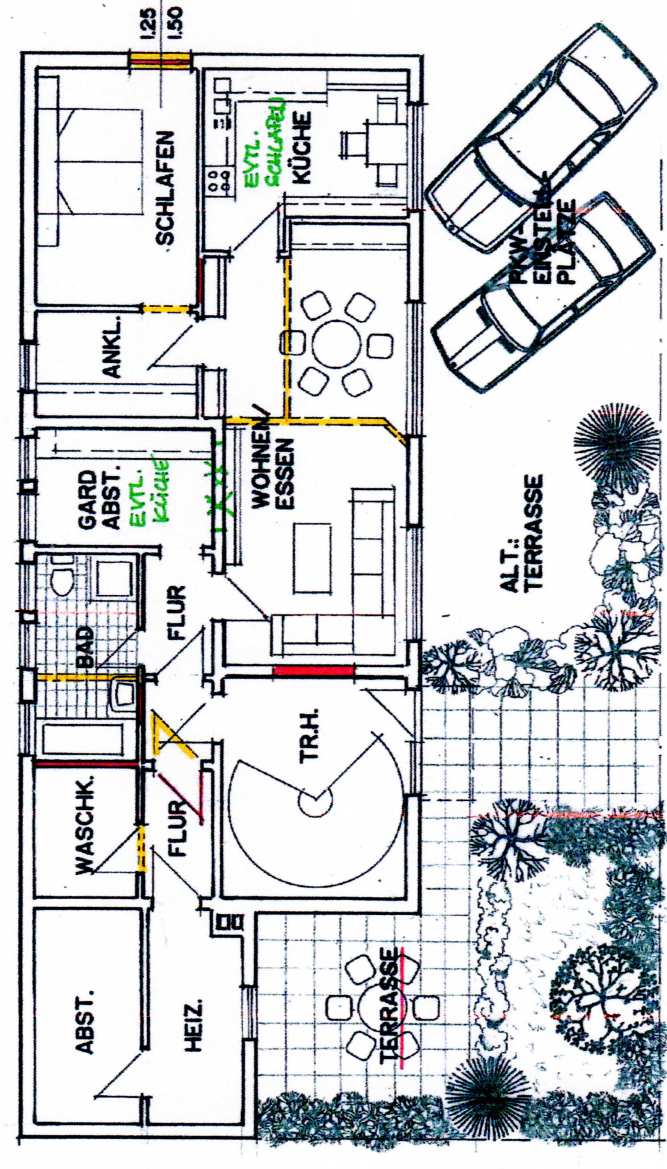

4.10	4.00	3.68	2.76
------	------	------	------


ERDGESCHOSS

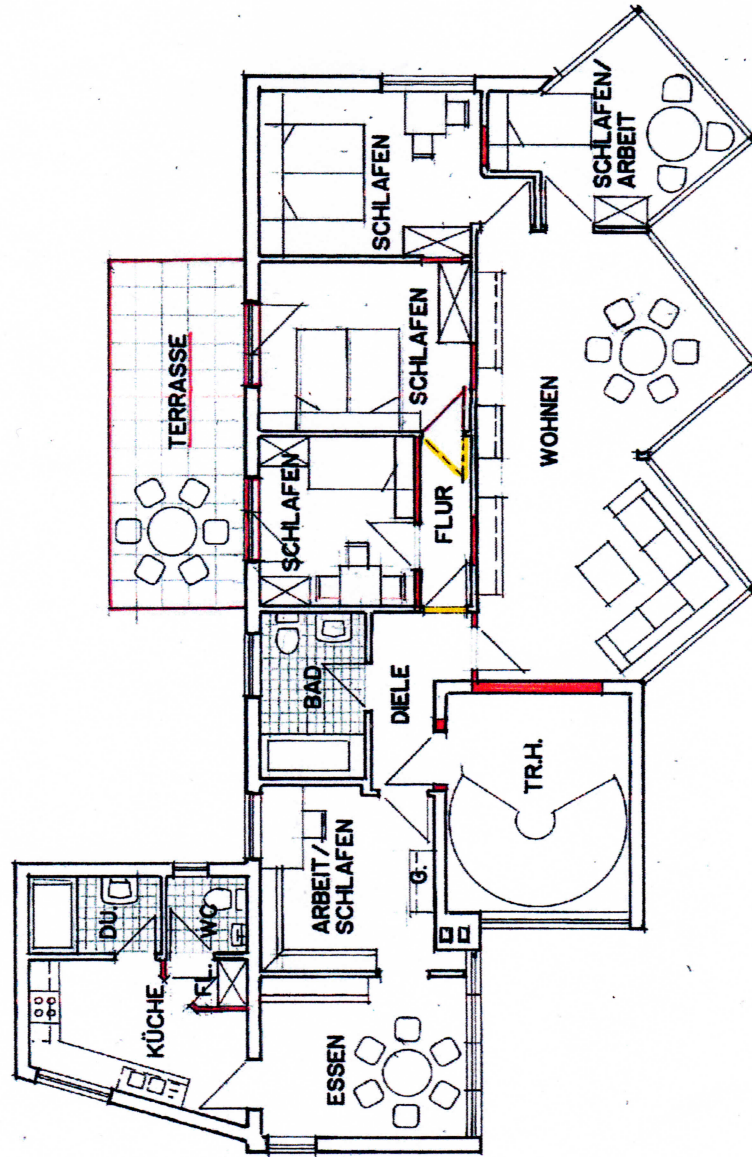

OBERGESCHOSS

4.05	4.05	2.25	2.20	2.00	4.45
4.05		2.25	2.20	3.00	3.43

1.80	2.00
1.25	1.80
3.50	

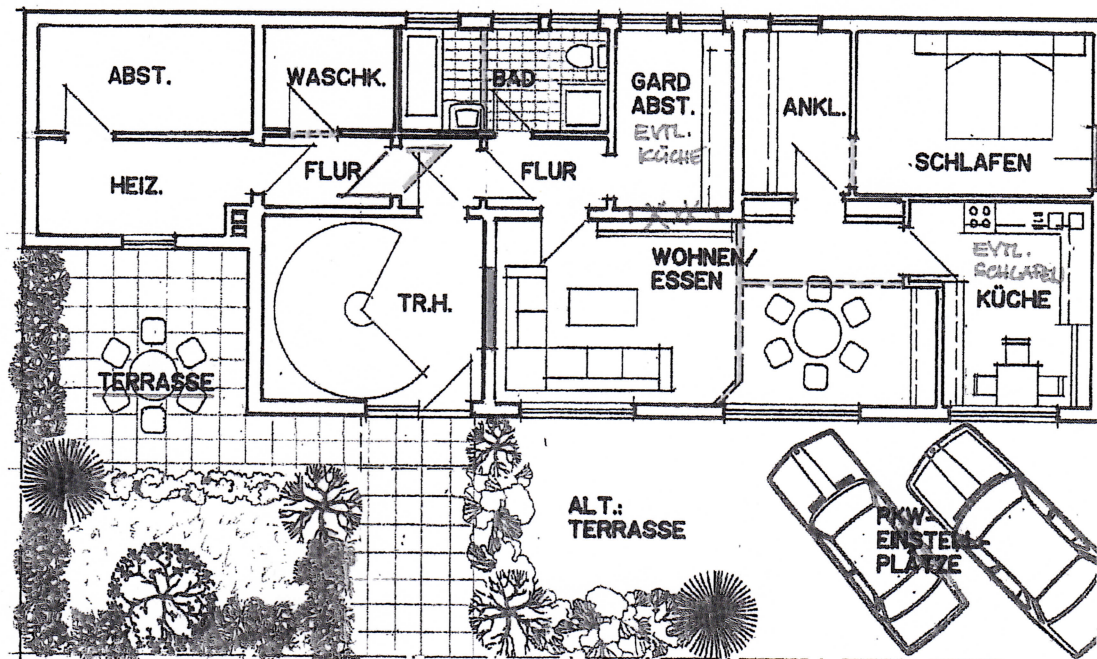

4.10	4.00	3.68	2.76
------	------	------	------

ERDGESCHOSS