


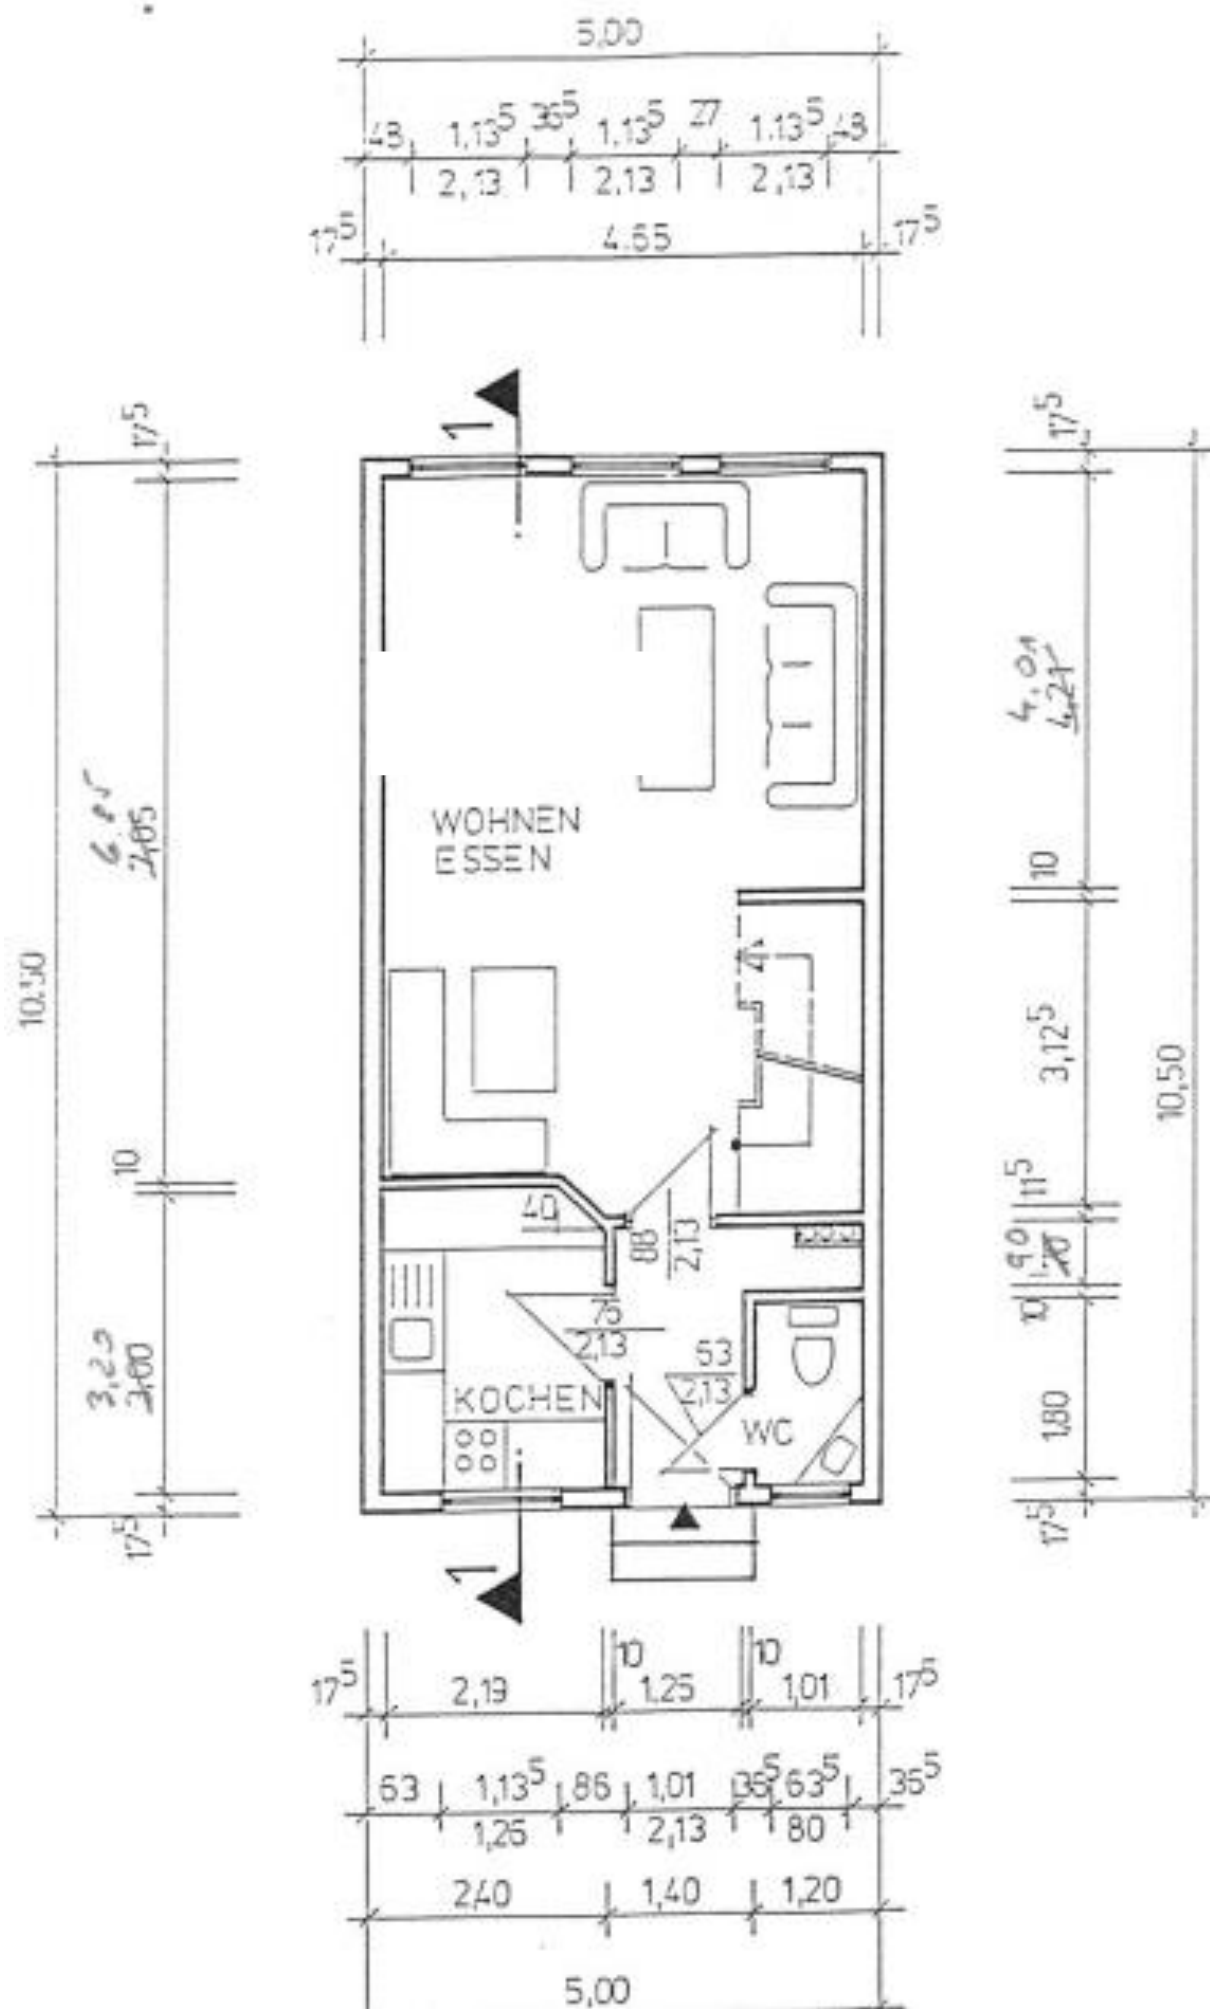

Erdgeschoß