


22.52 3.30 1.90 1.19 6.52 4.50

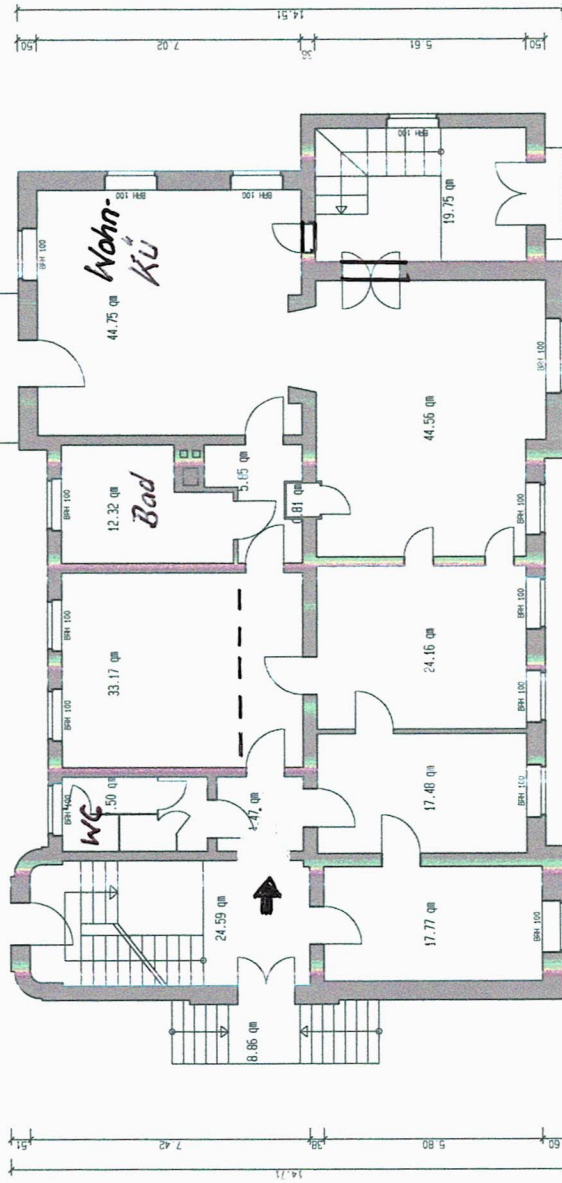

Königsstein
Bahnhofstr. 32
Hedypast.
ca. 293 qm