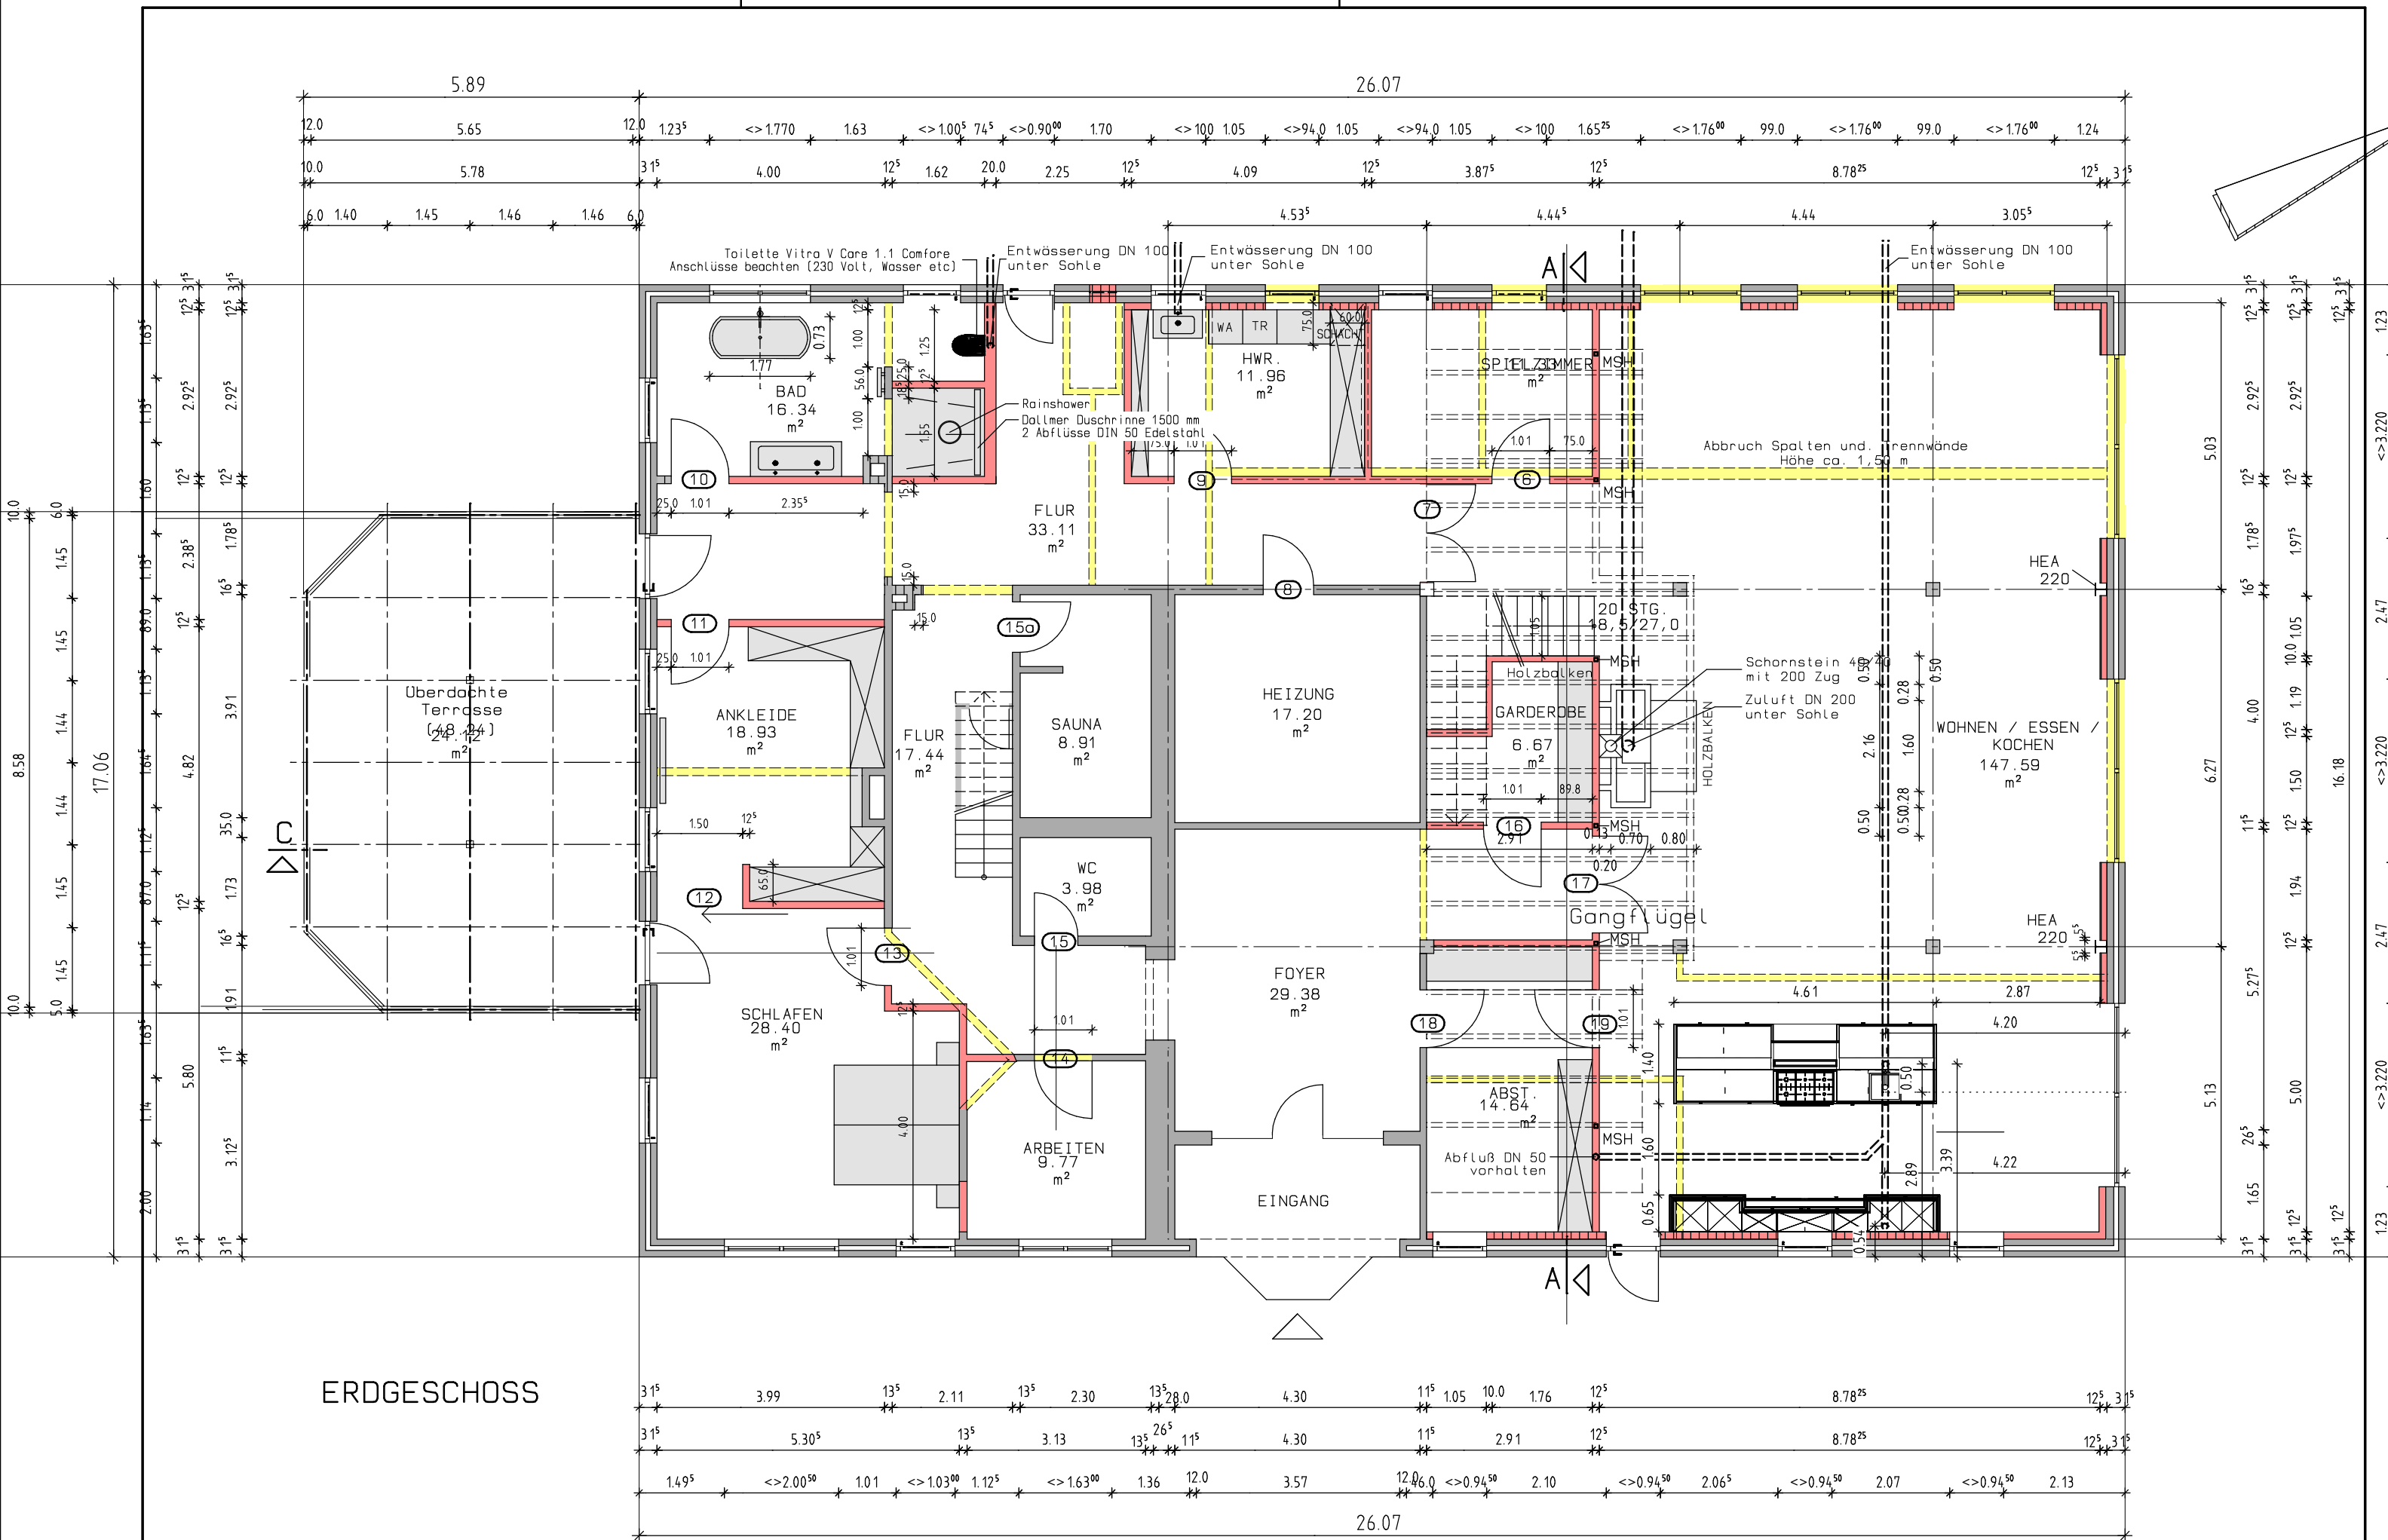



$$H/B = 297.0 / 420.0 \text{ (} 0.12\text{m}^2 \text{)}$$

Allplan