


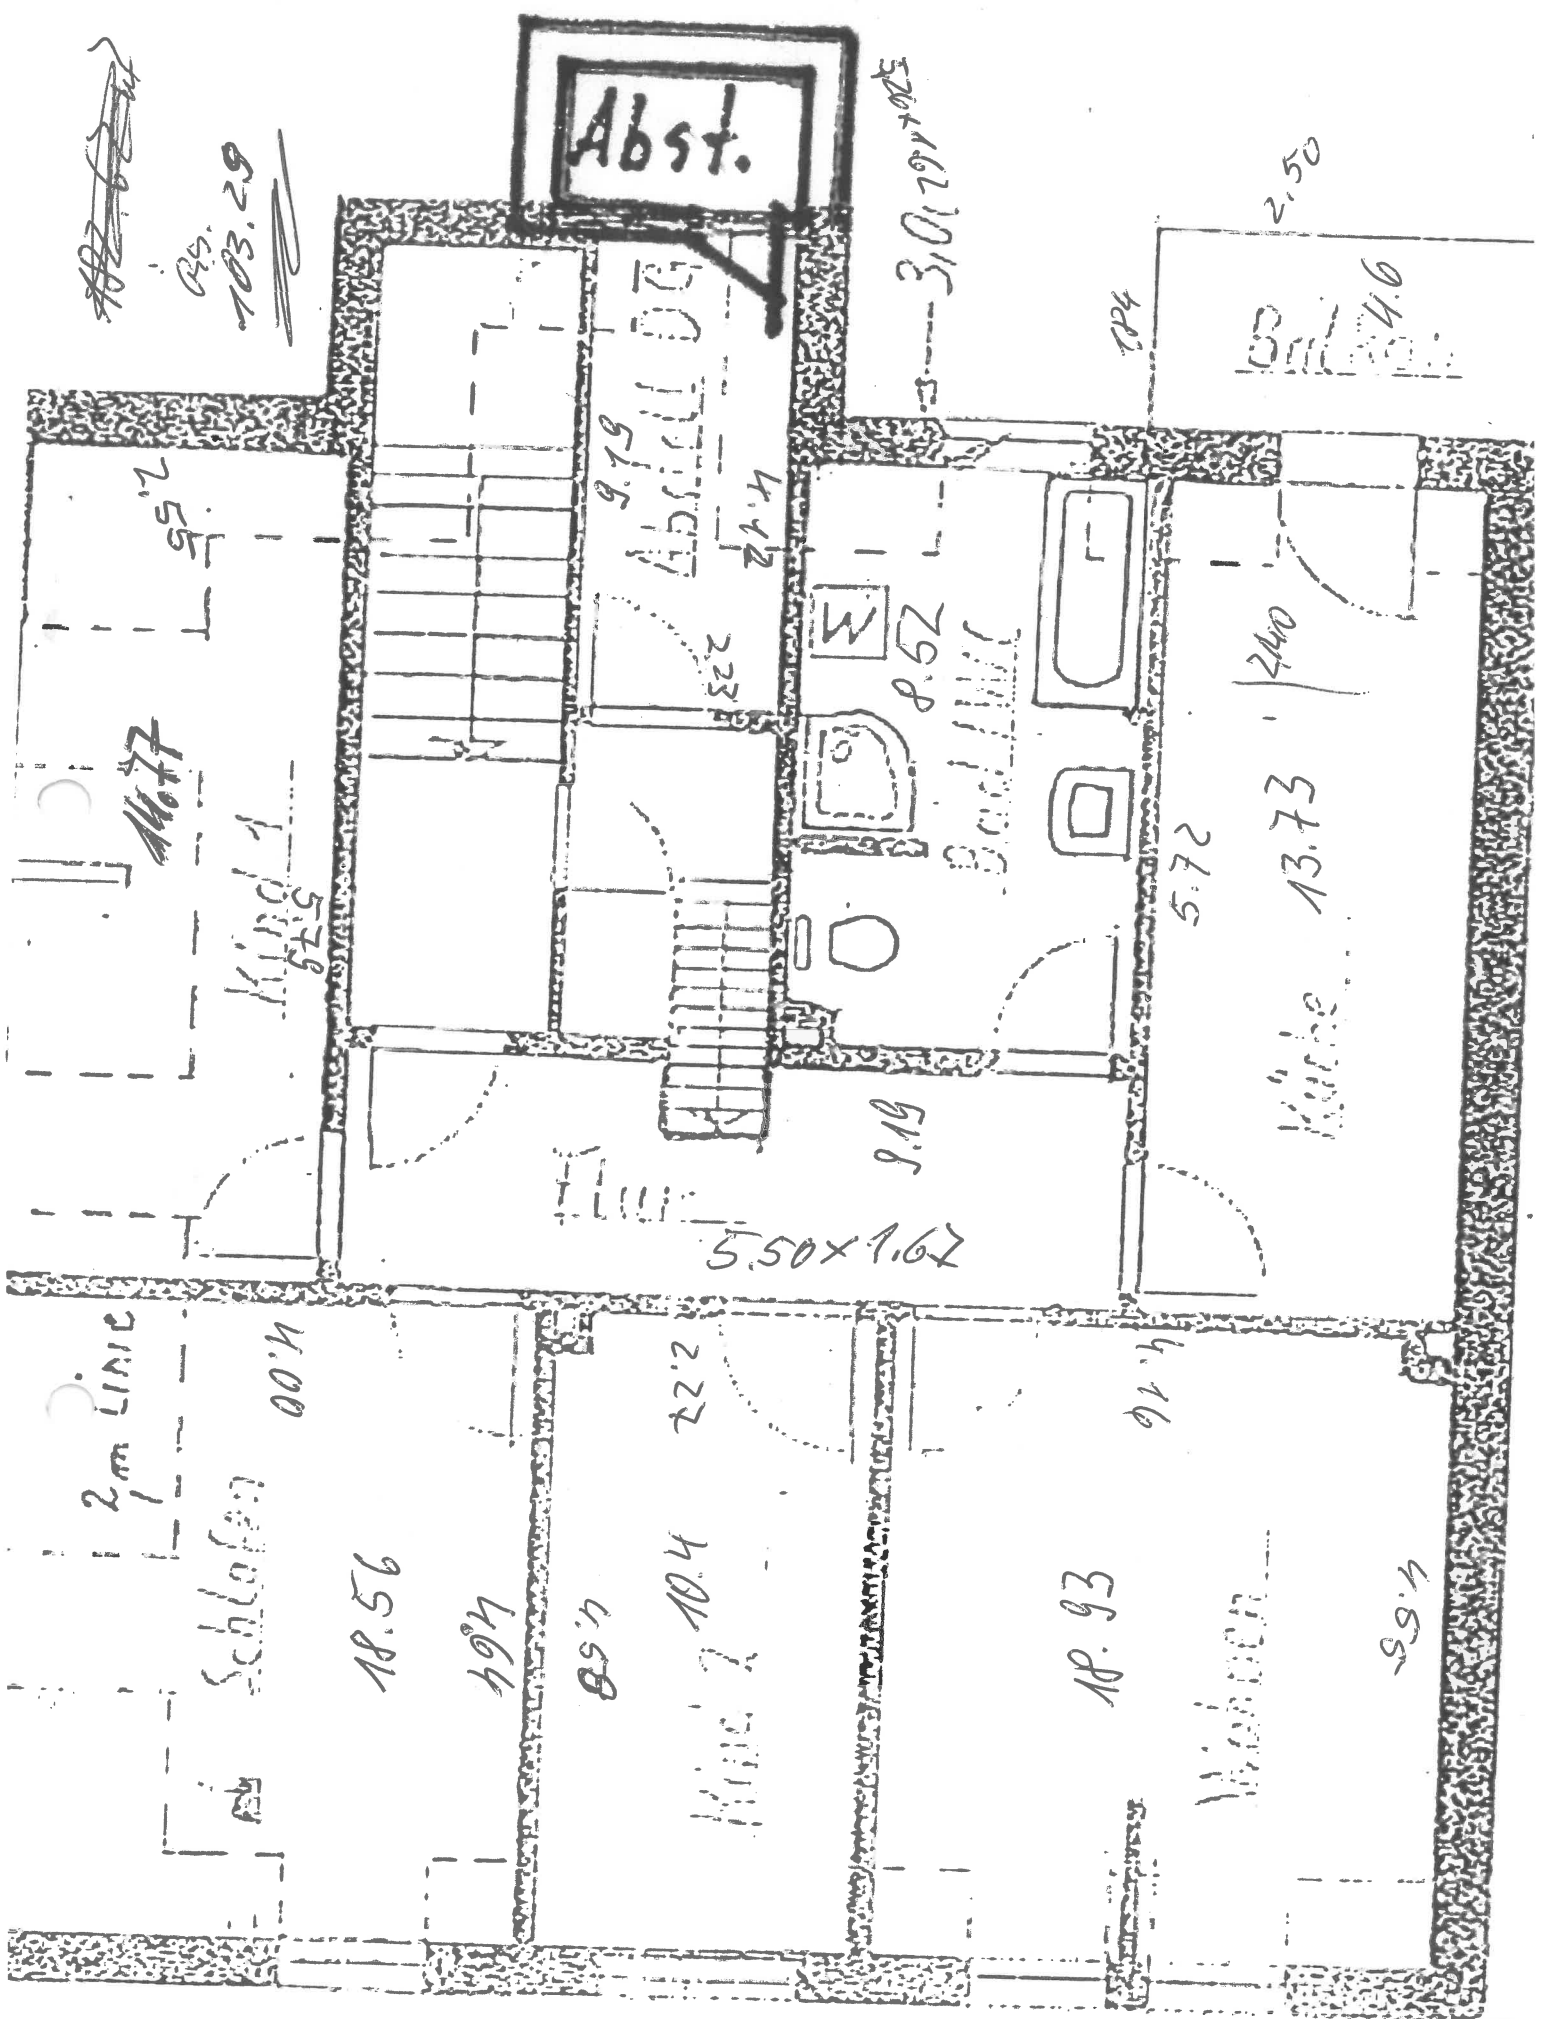

11.47