


A
Entlüft.

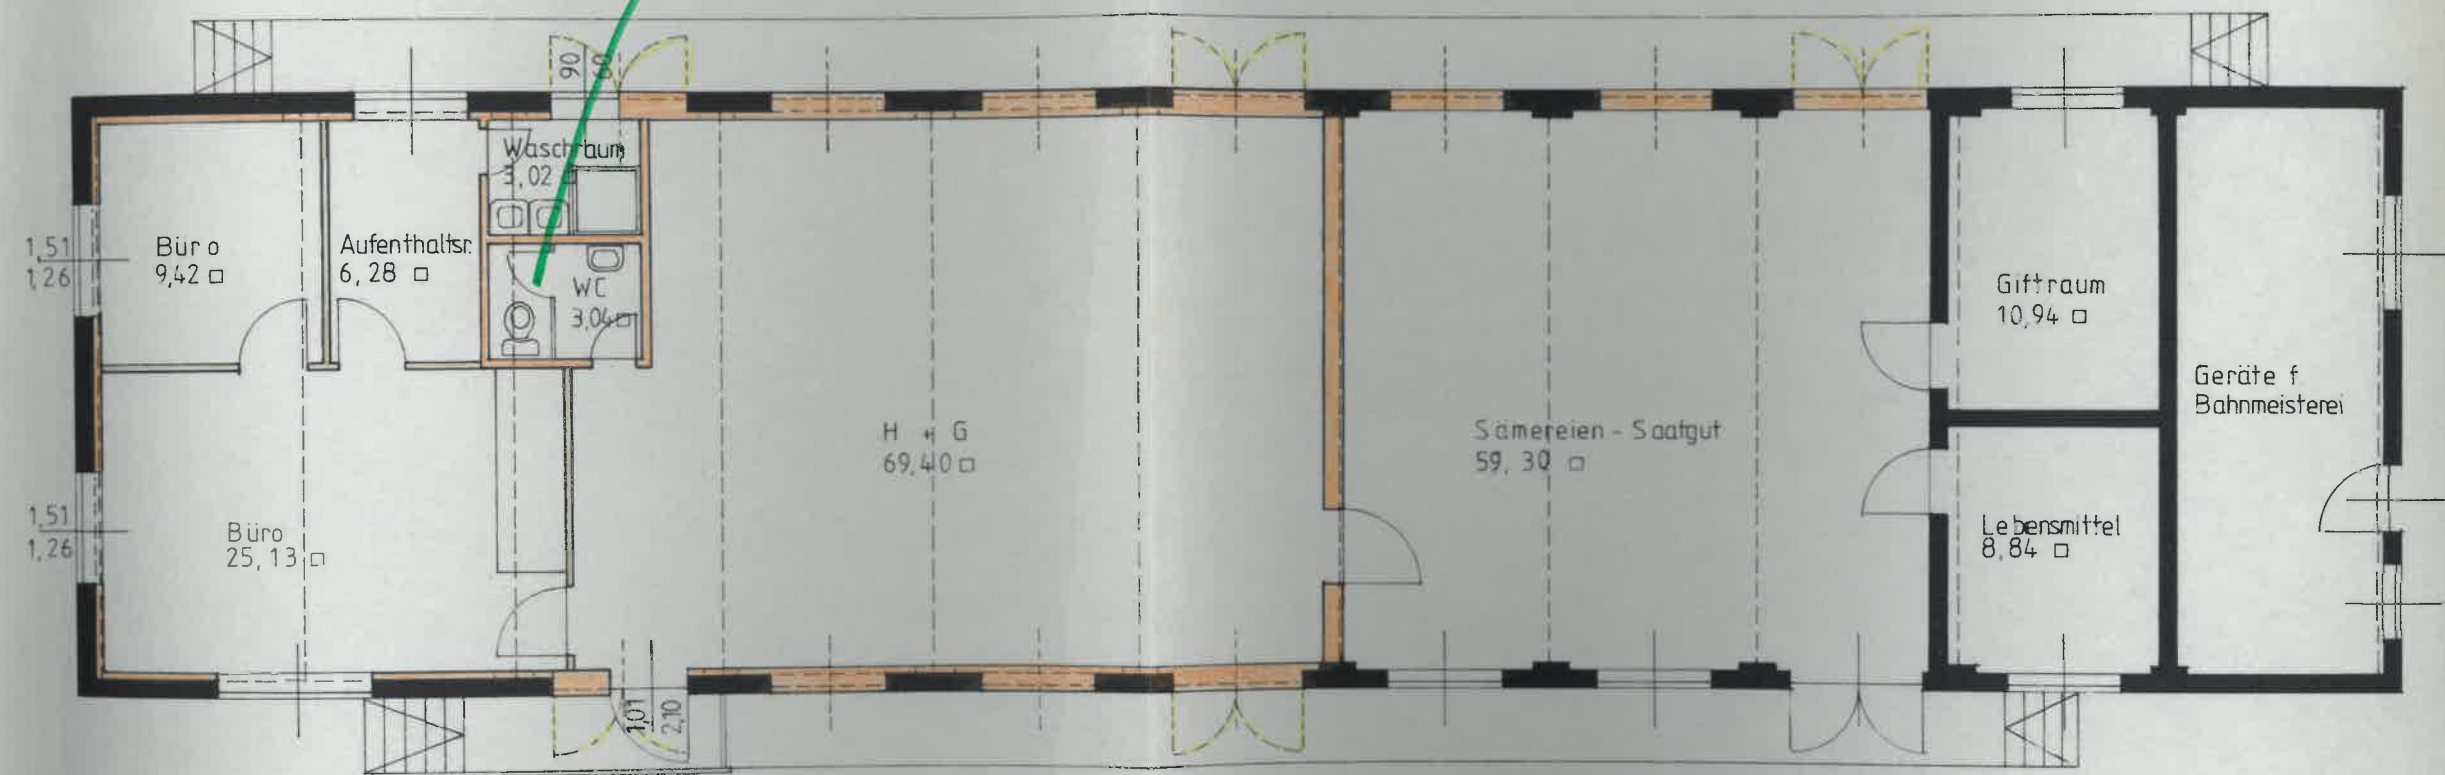

GRUNDRISS