


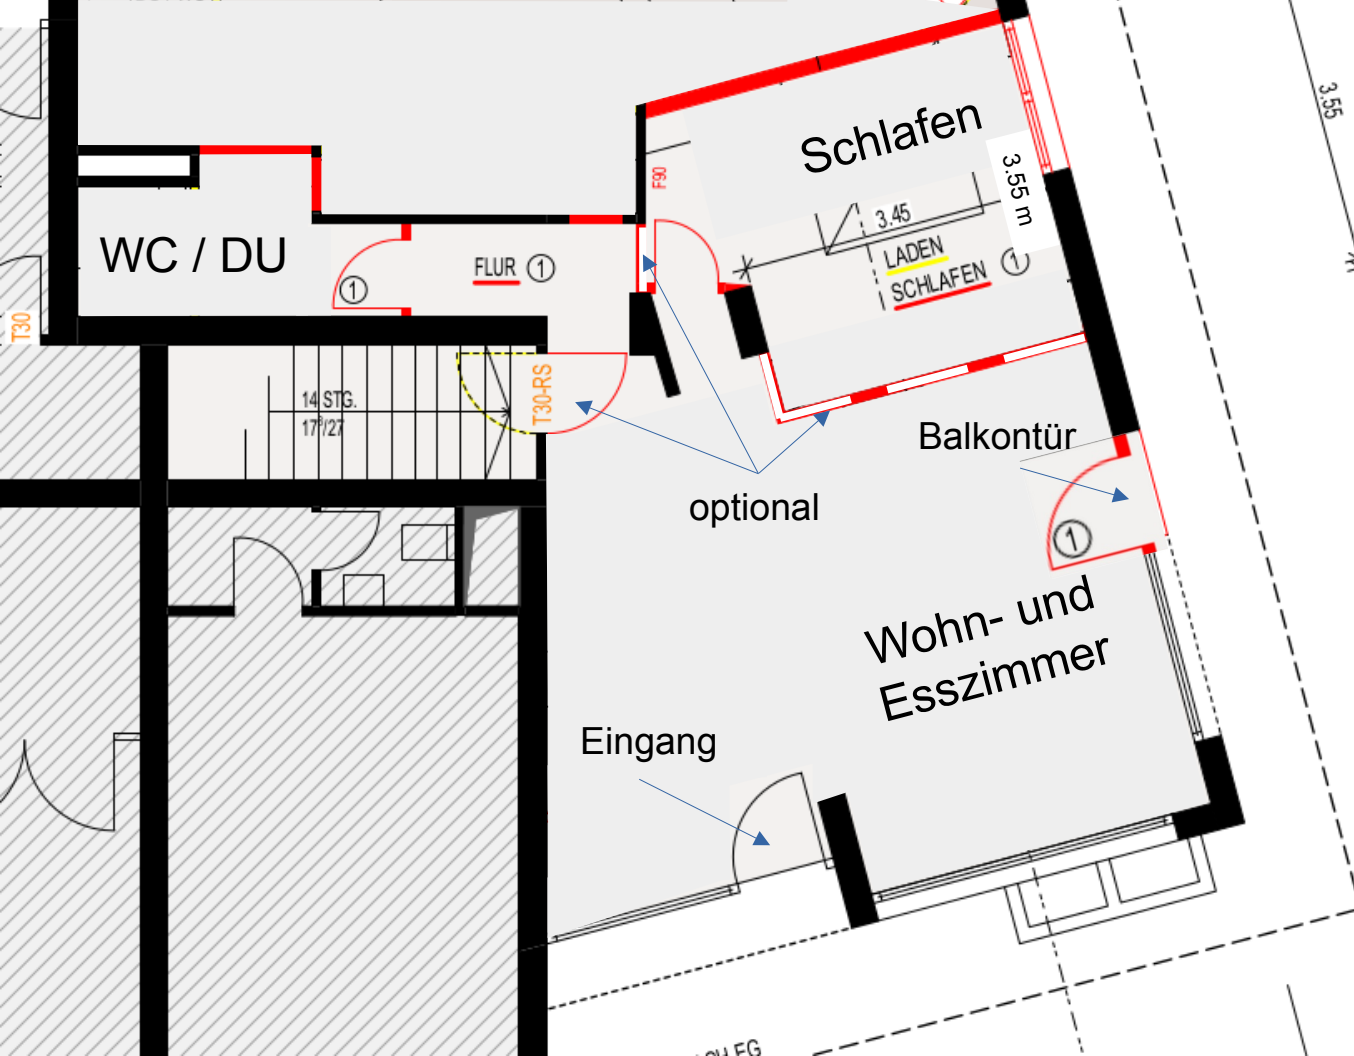

EG

Büro / Laden	40	m ²
Büro?	14,5	m ²
WC	3	m ²
Flur	4,5	m ²
	62	m²

