


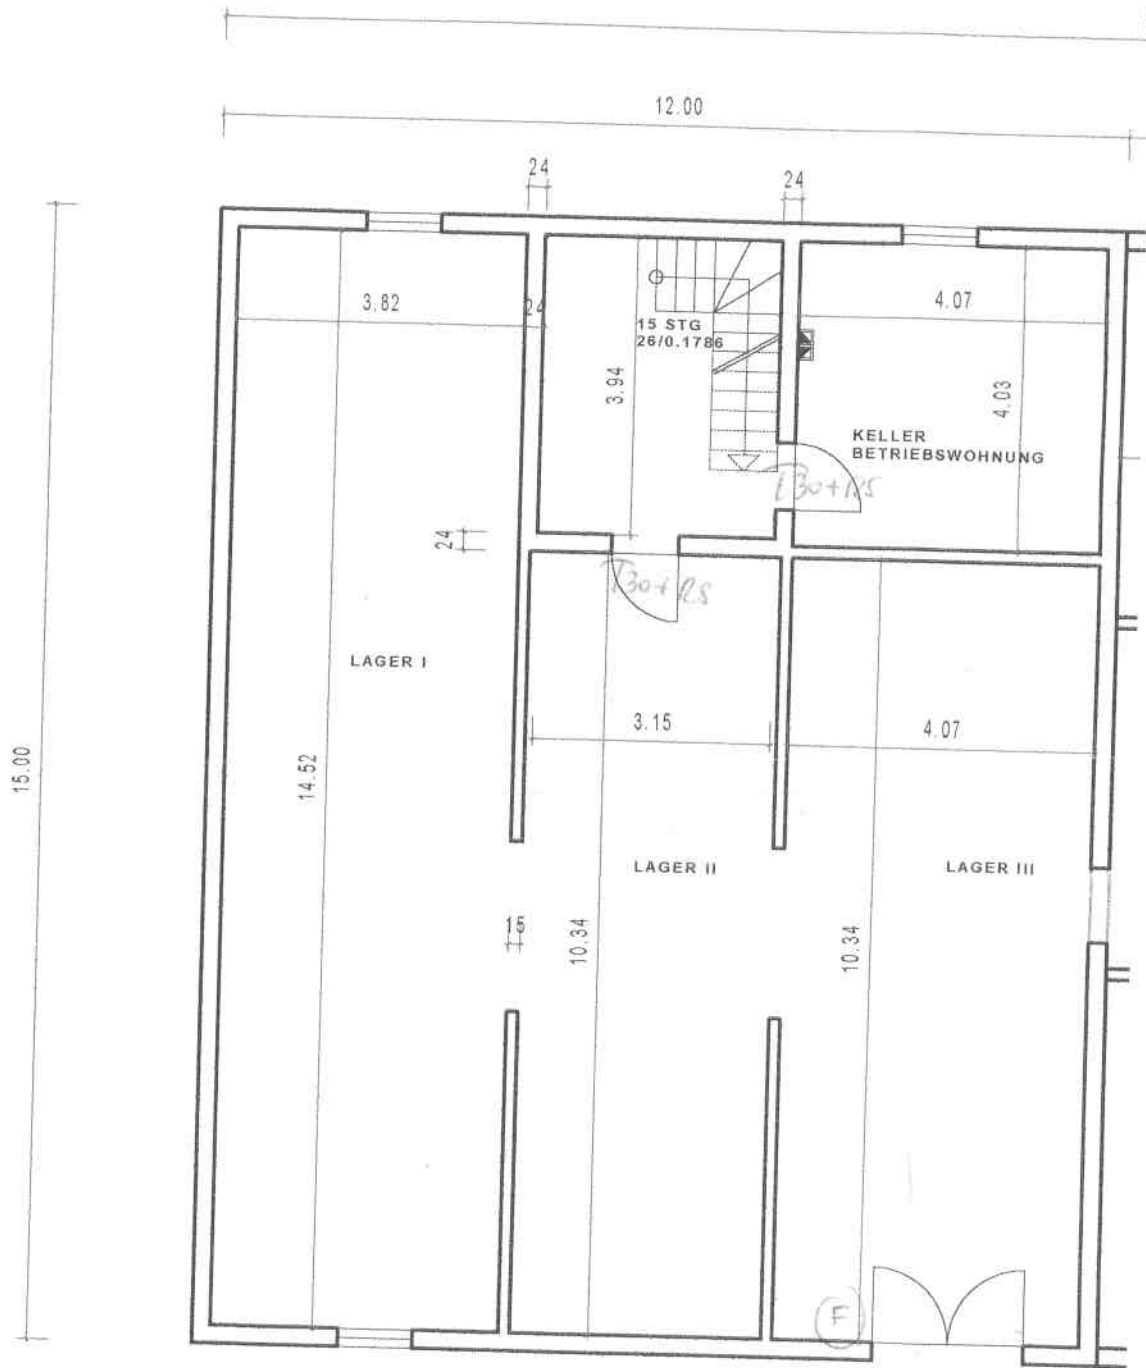

KELLERGESCHO