



3

UNTERGESCHOSS komplett ausgebaut


UNTERGESCHOSS

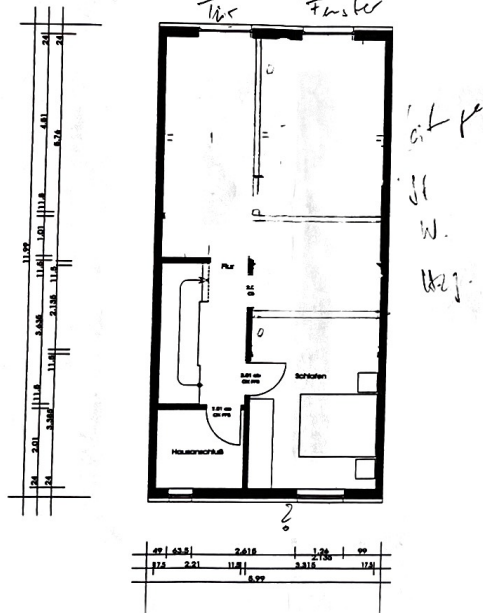

ERDGESCHOSS

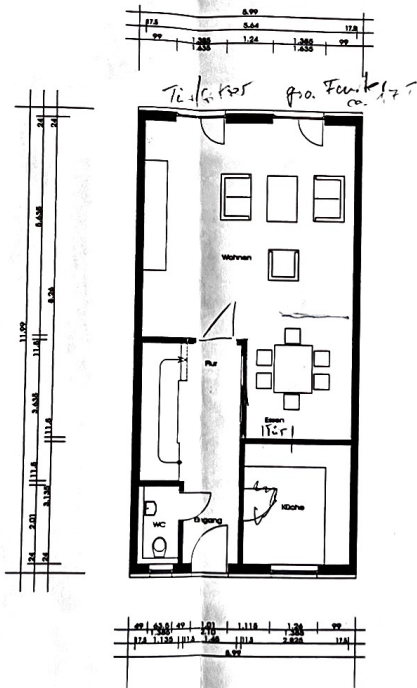

OBERGESCHOSS

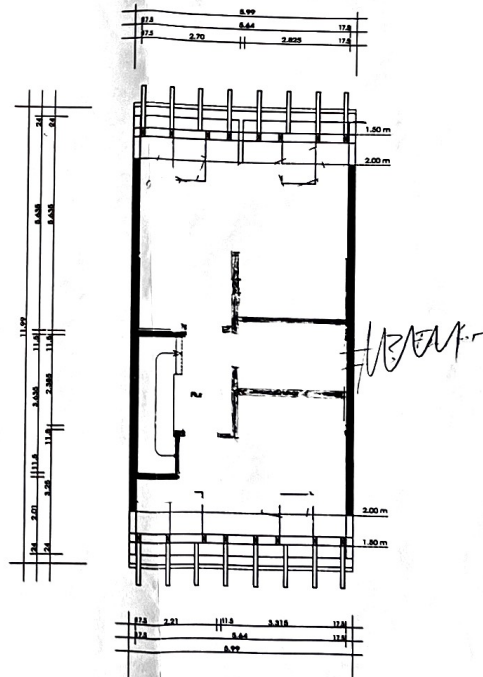

18. M. 10
J. M. 2

411,000,-
15,000,-
2,000,-
424,000,-