

DOPPELHAUS IN ERDMANNHAUSEN


Schrenk, Tulpenstr. 9

S

DG

JY. 18

13.00

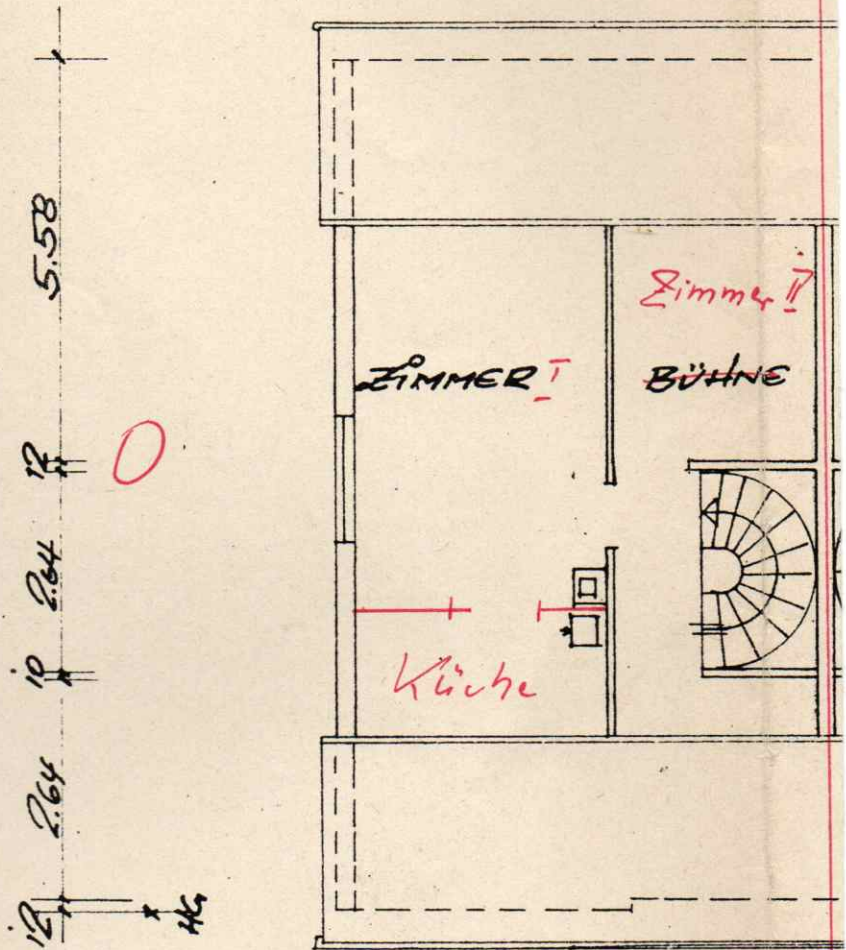

1.2



2.4 3.34 1.8 2.70 2.4
 3.805 5.3

N