




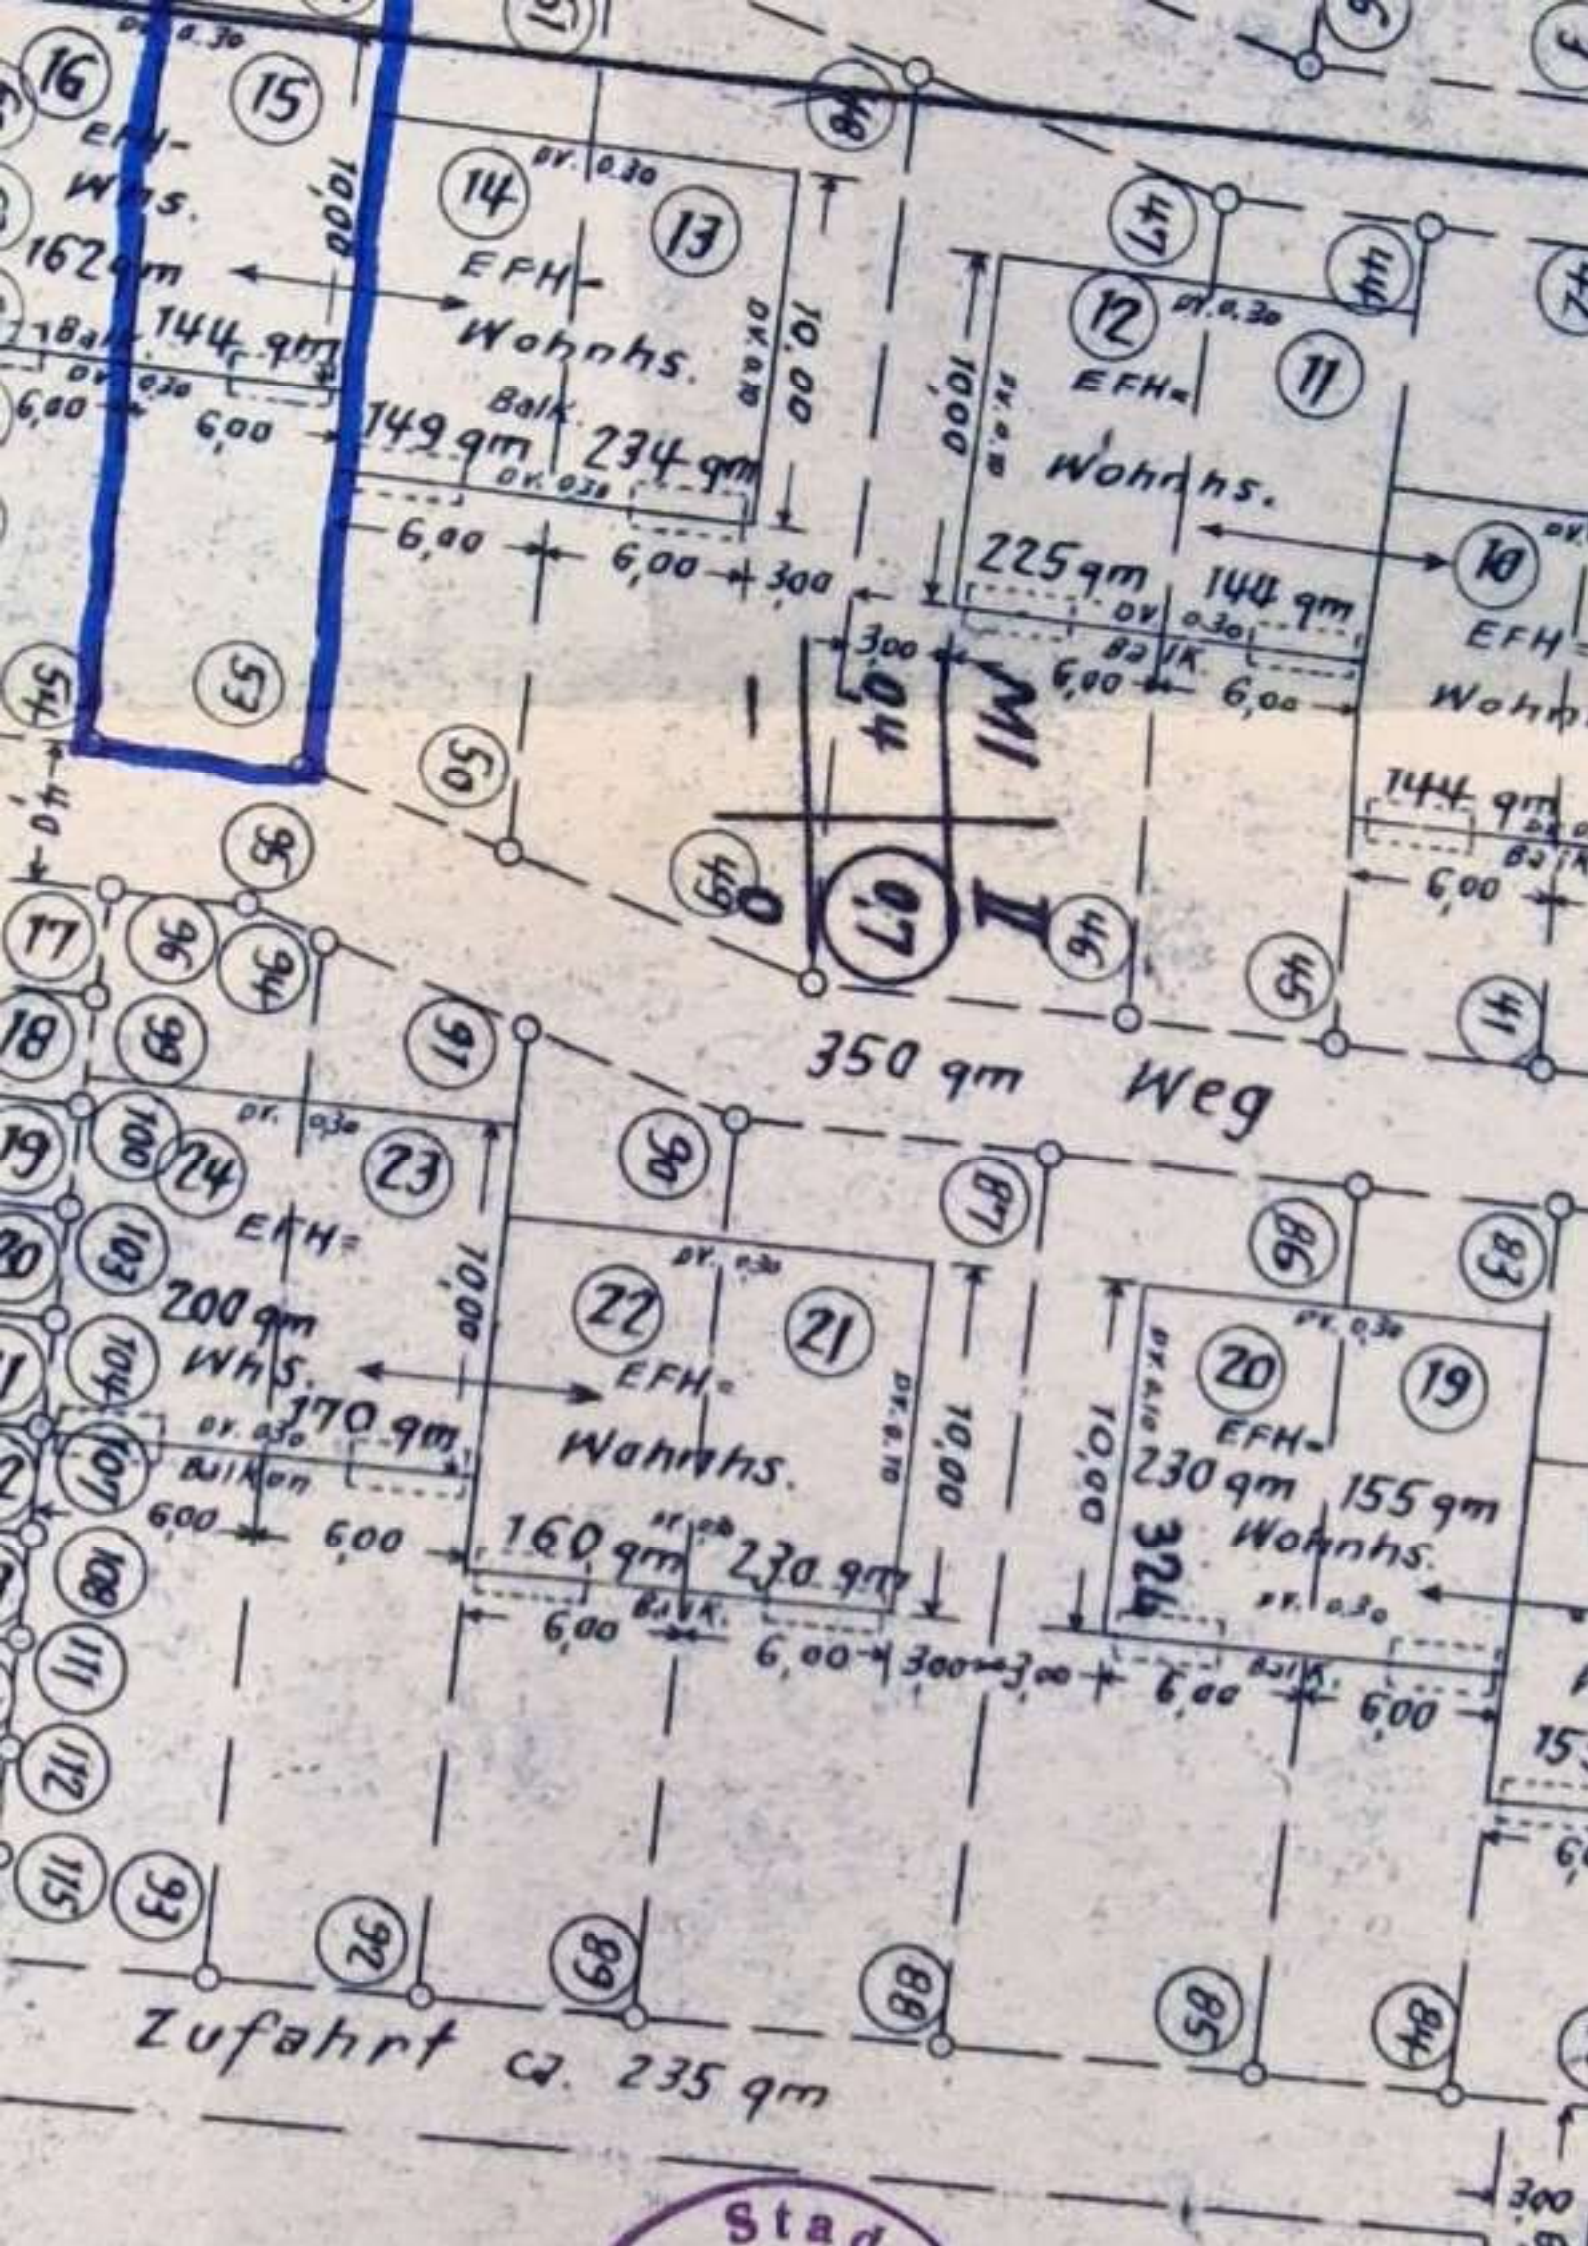

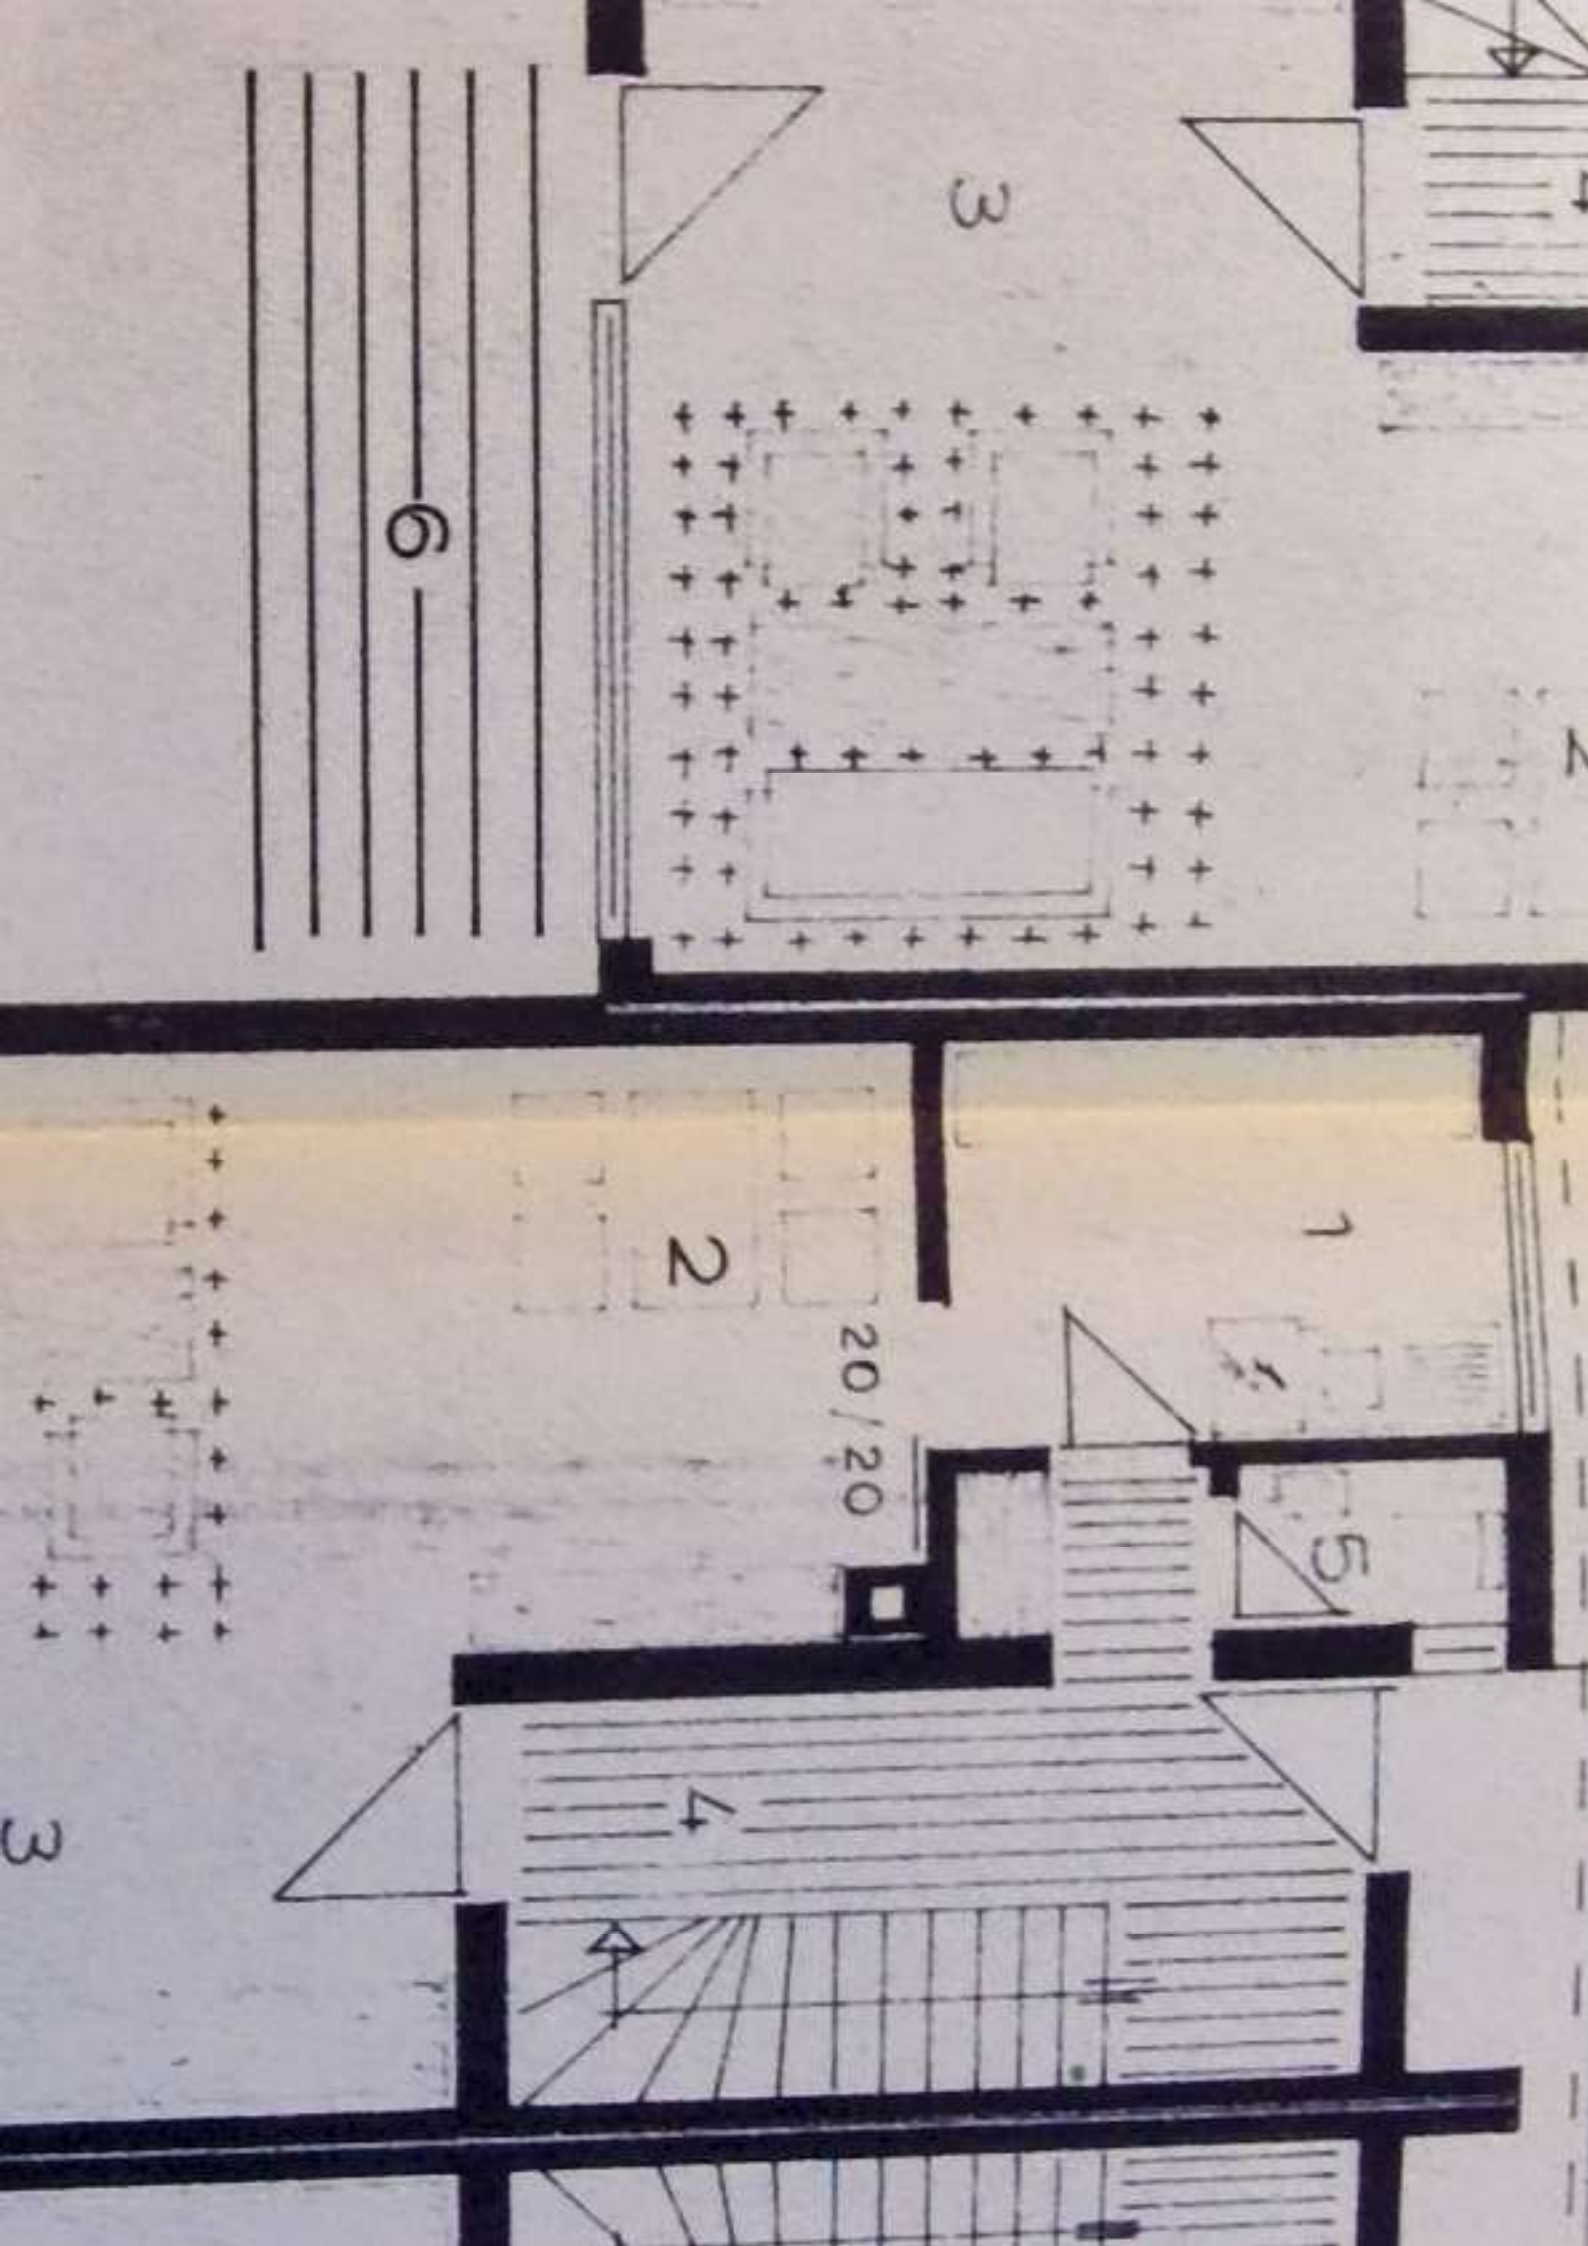

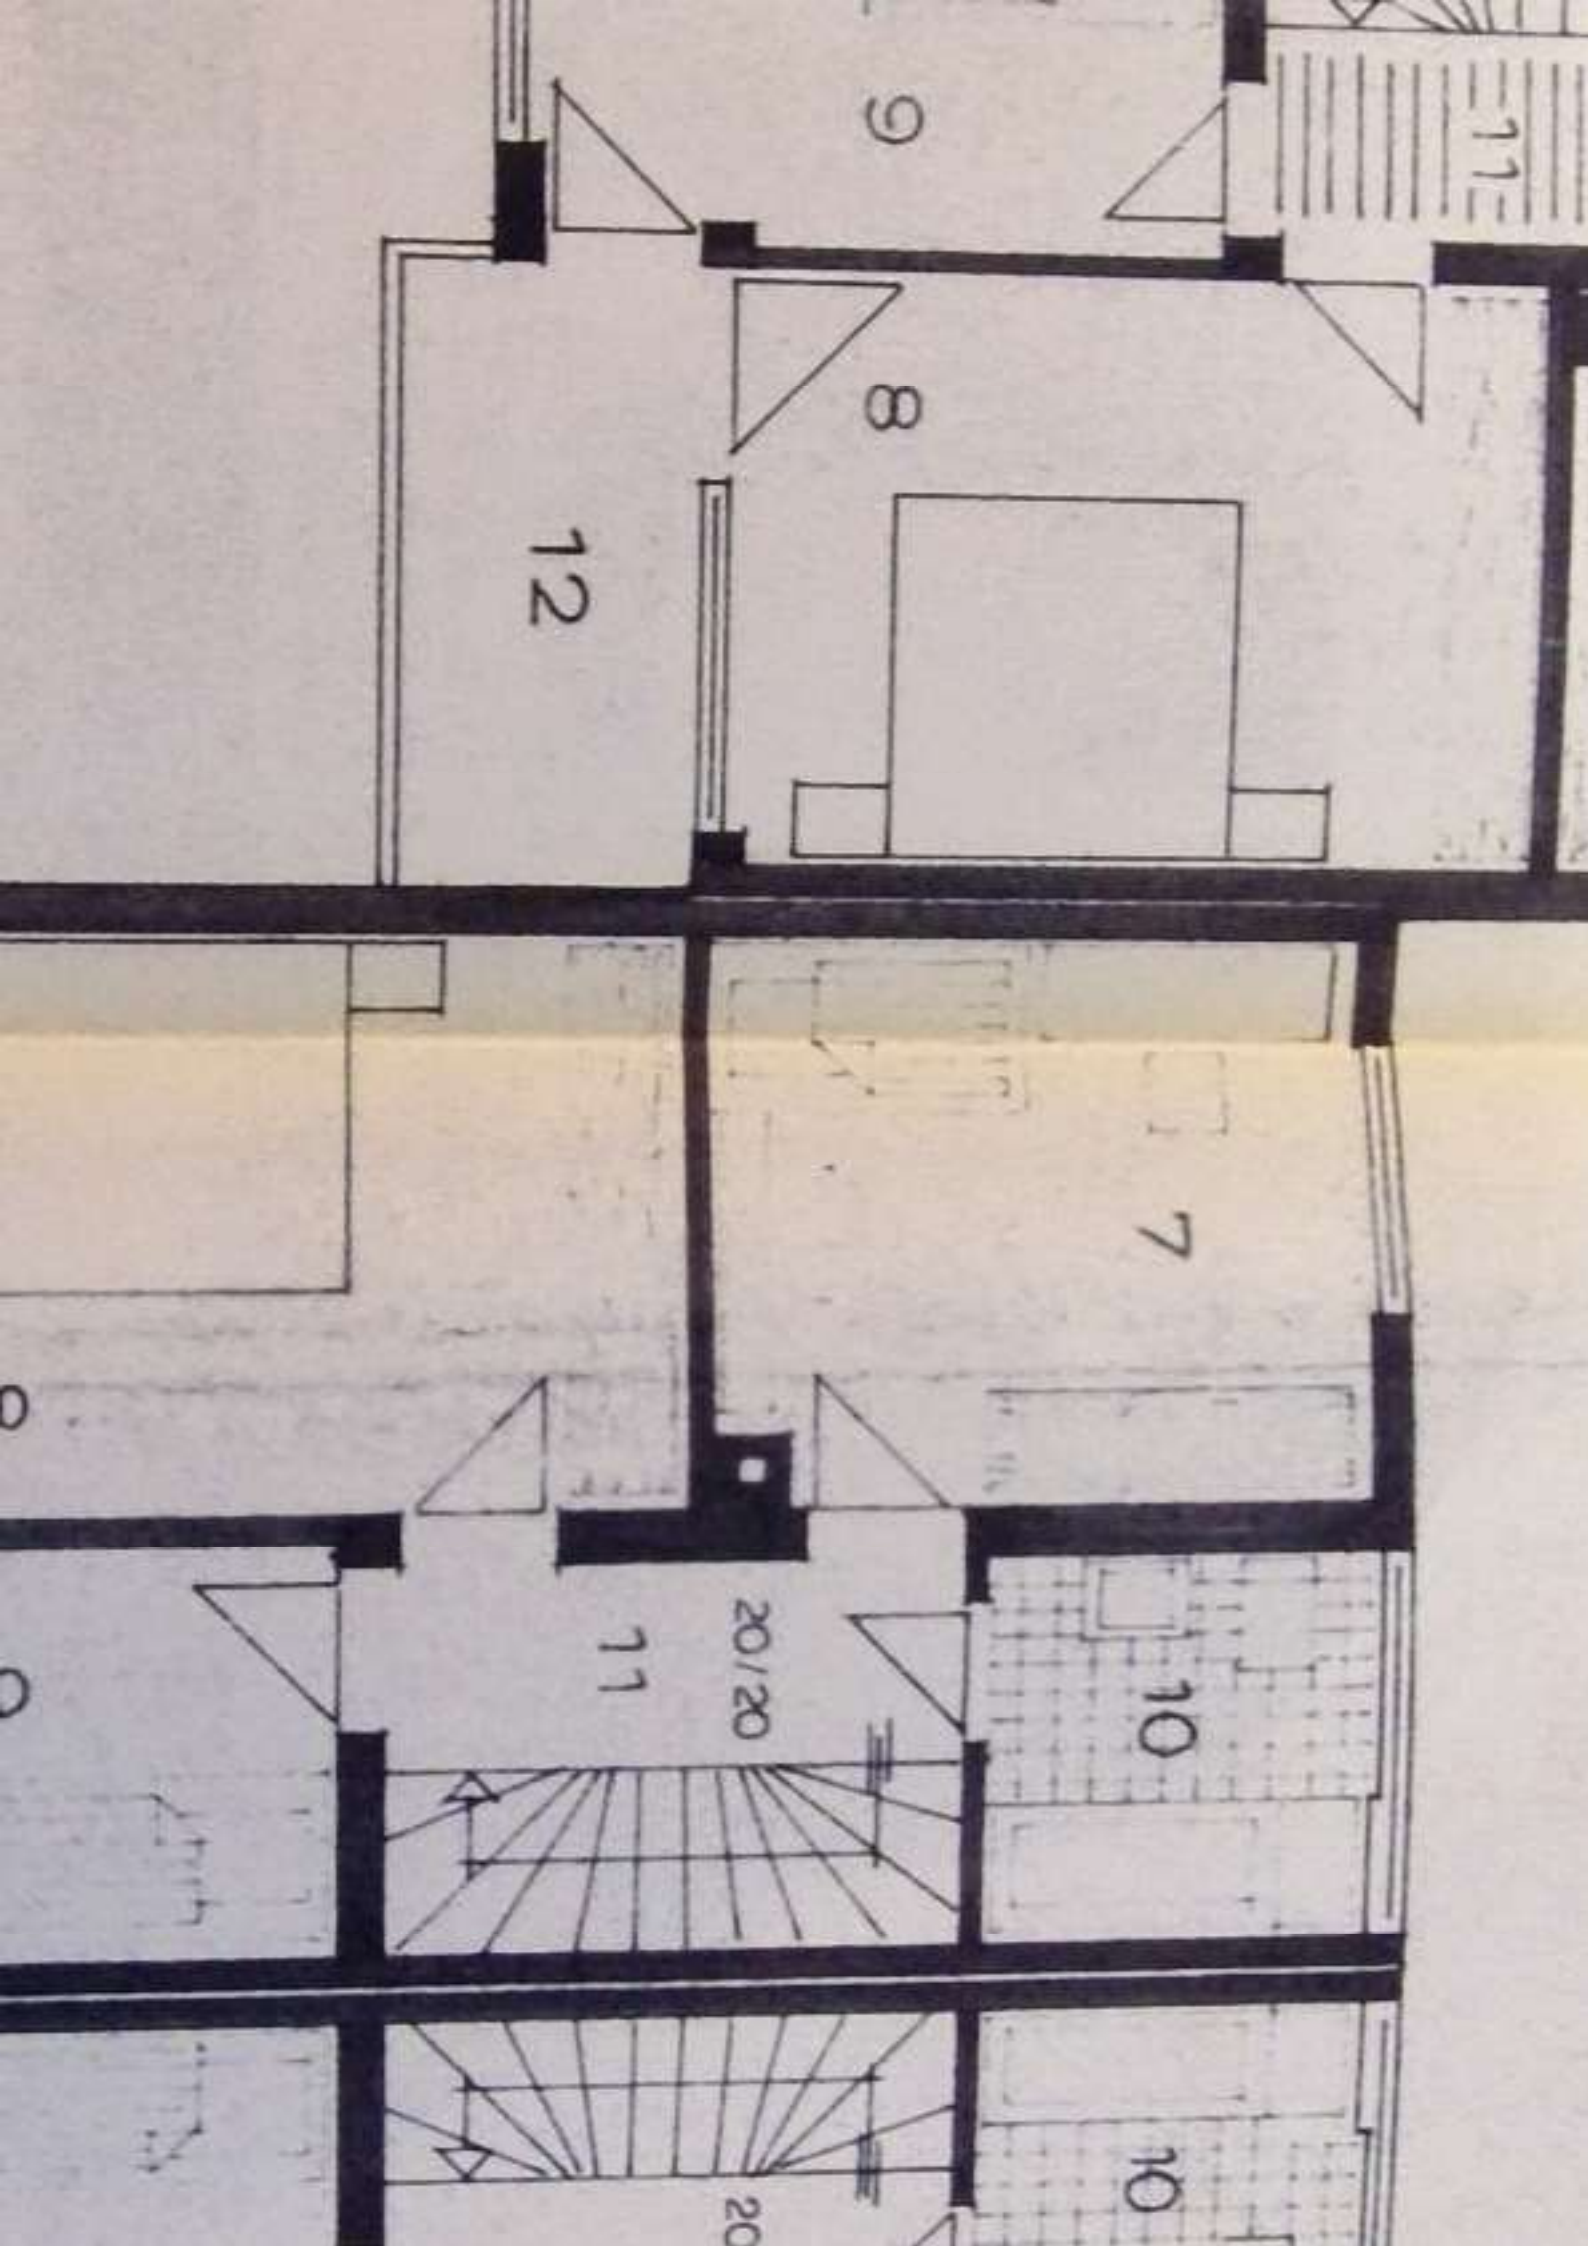

GAST

20/20

WC

PT

FUR

WC

PT

FUR

PT.


DG

OG

30 D.V.

248.20

EG ~~347.20~~

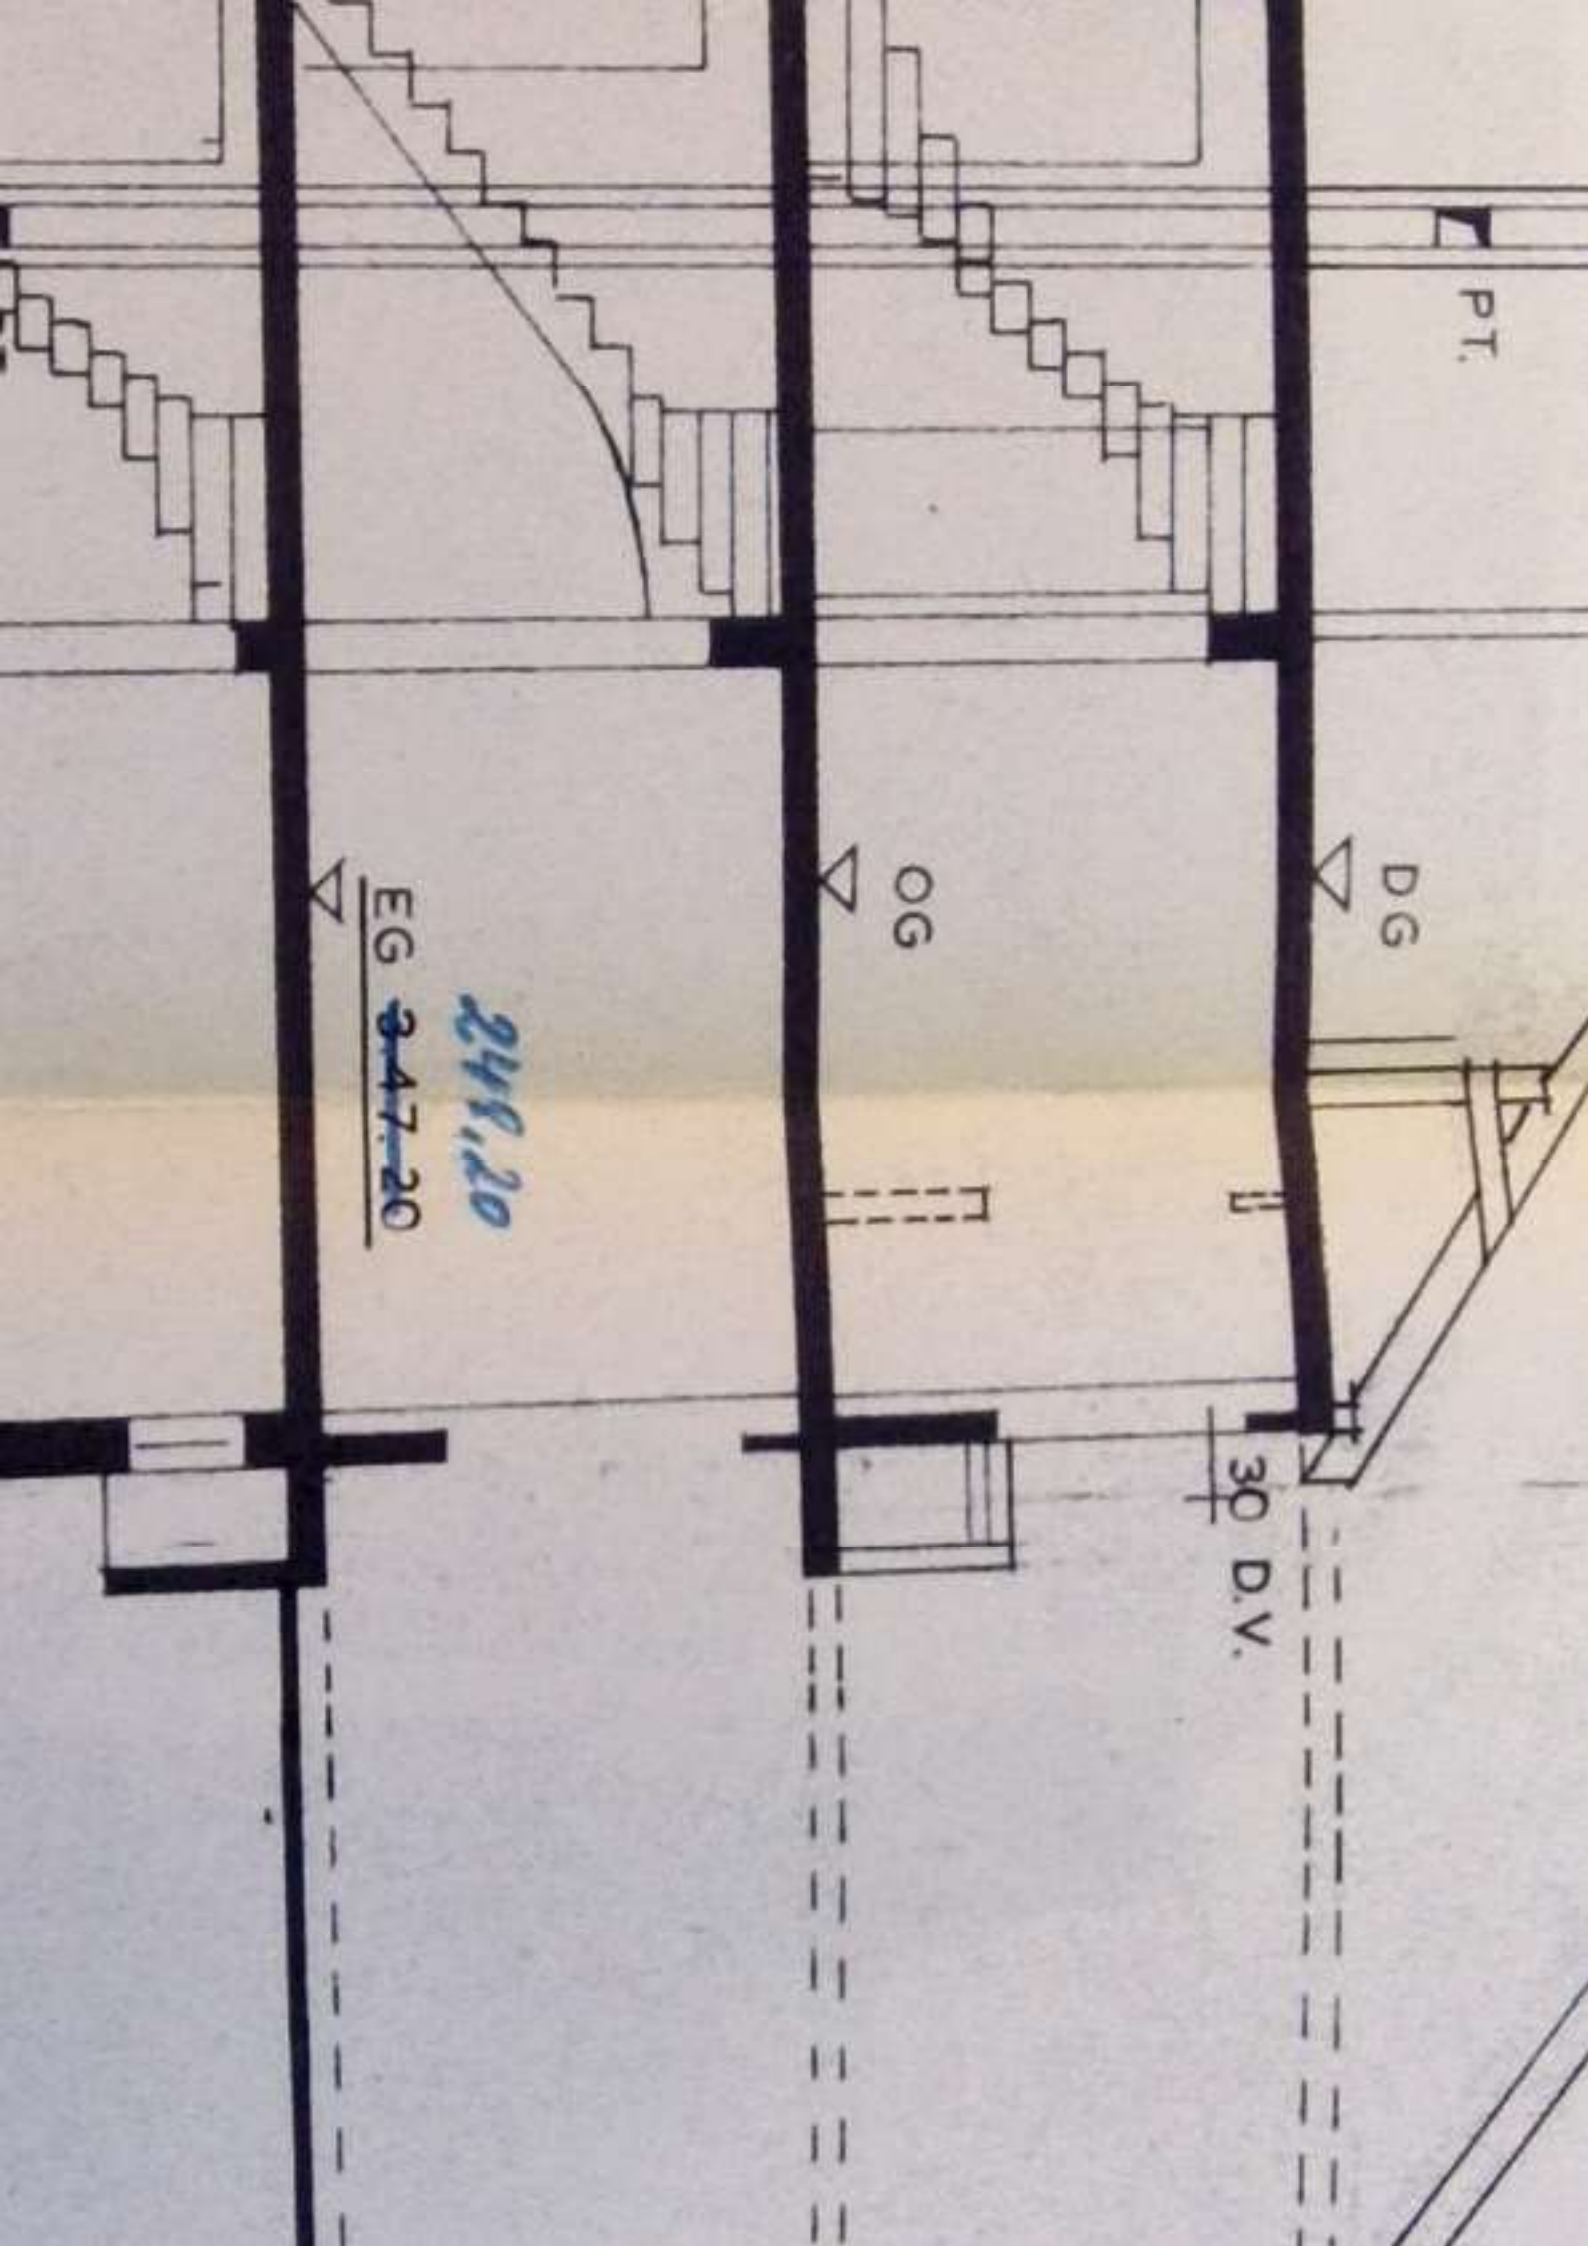


248,20


347.20






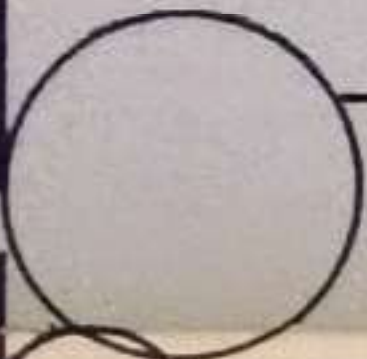



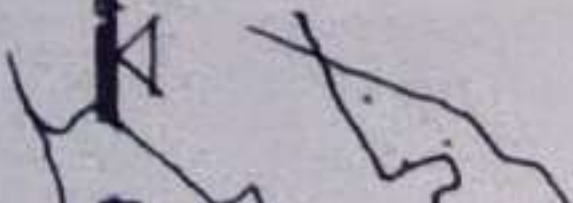


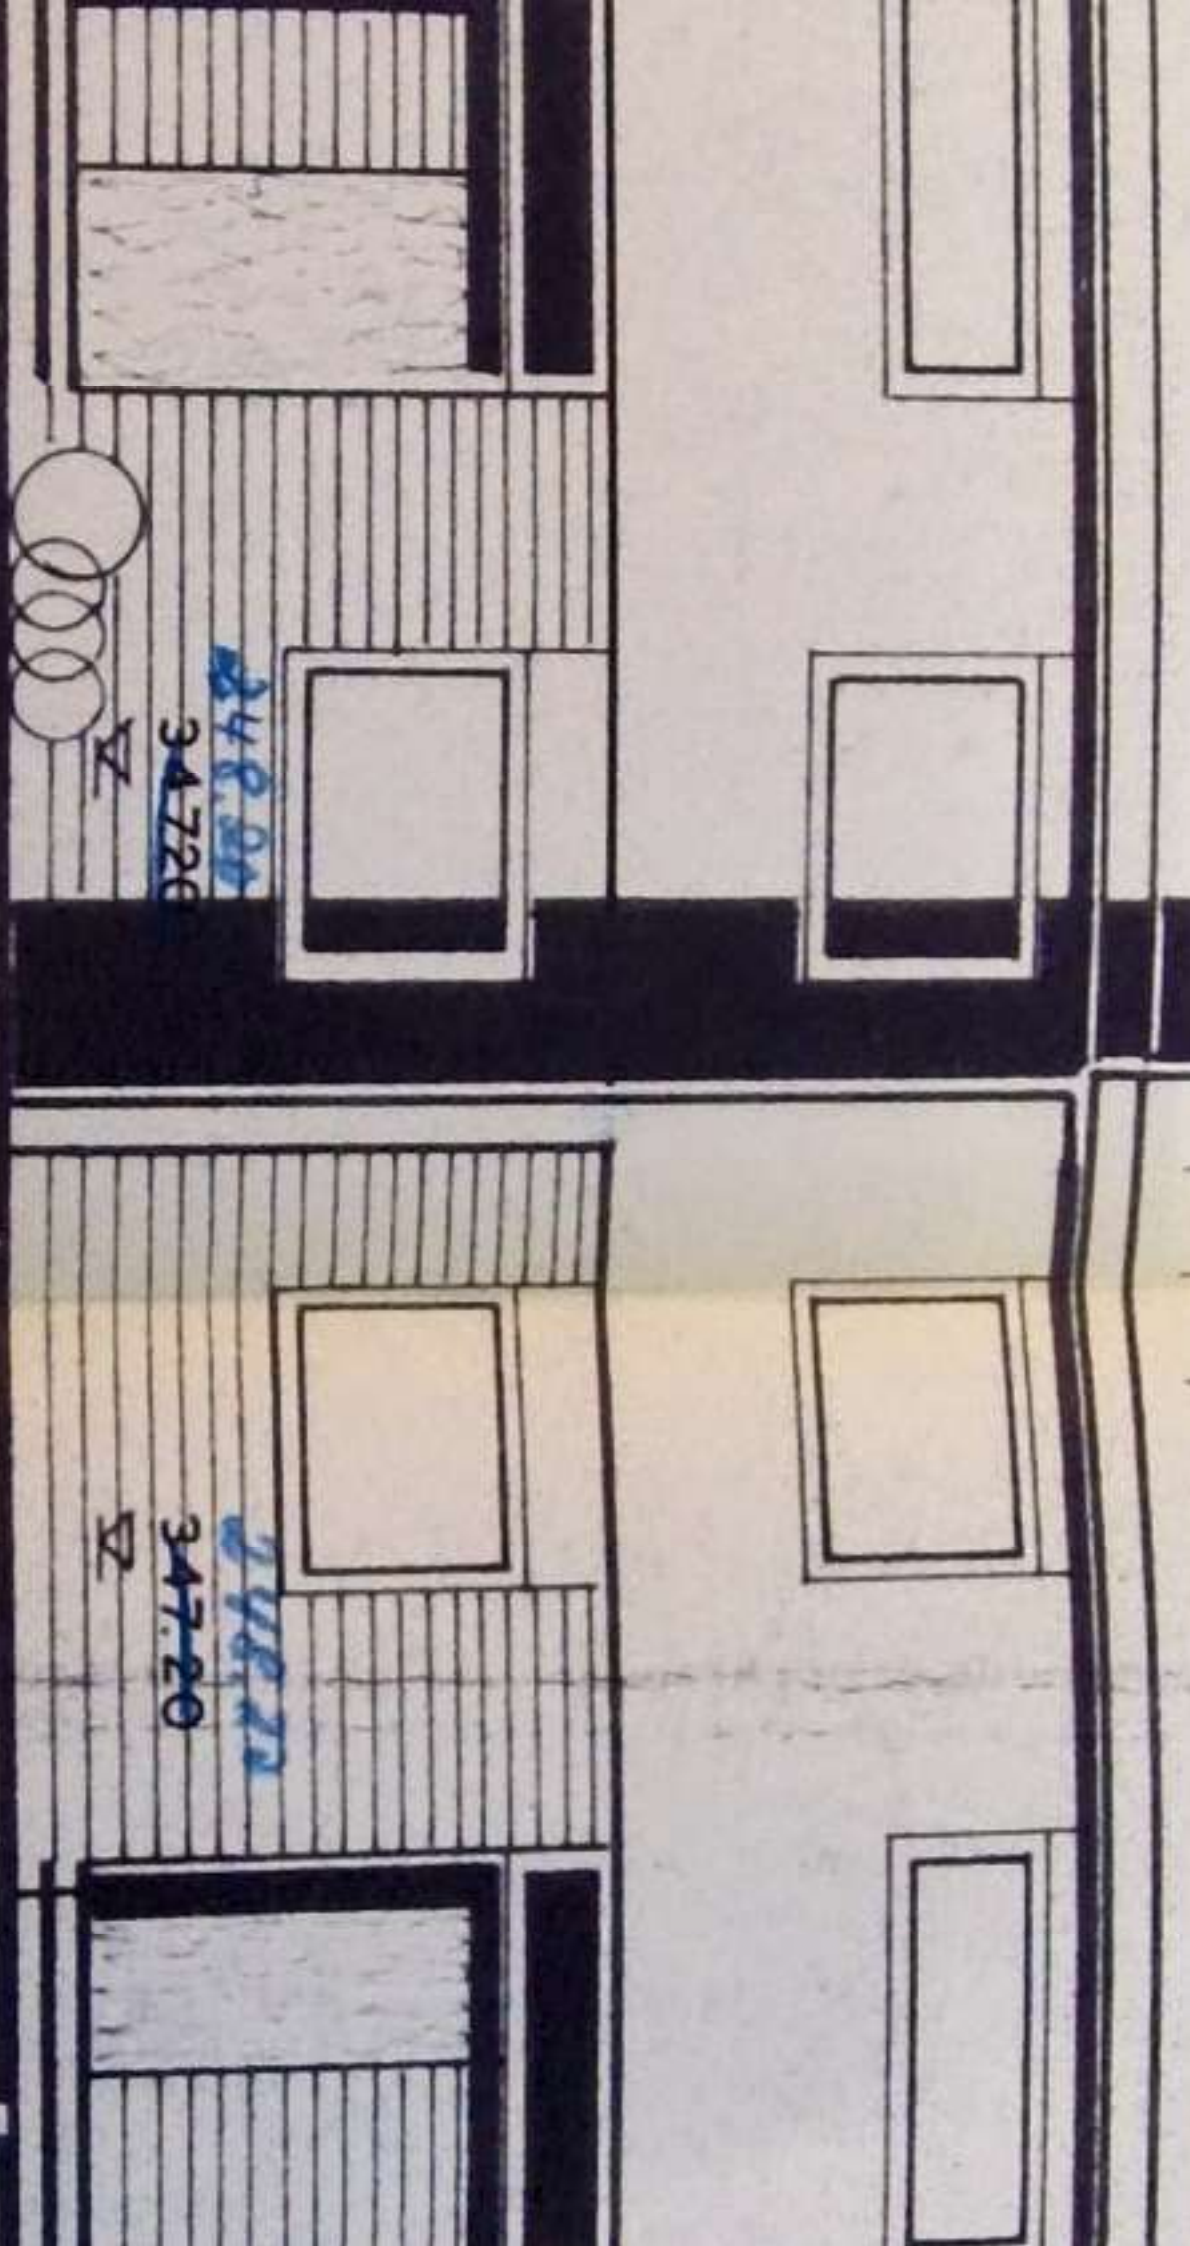

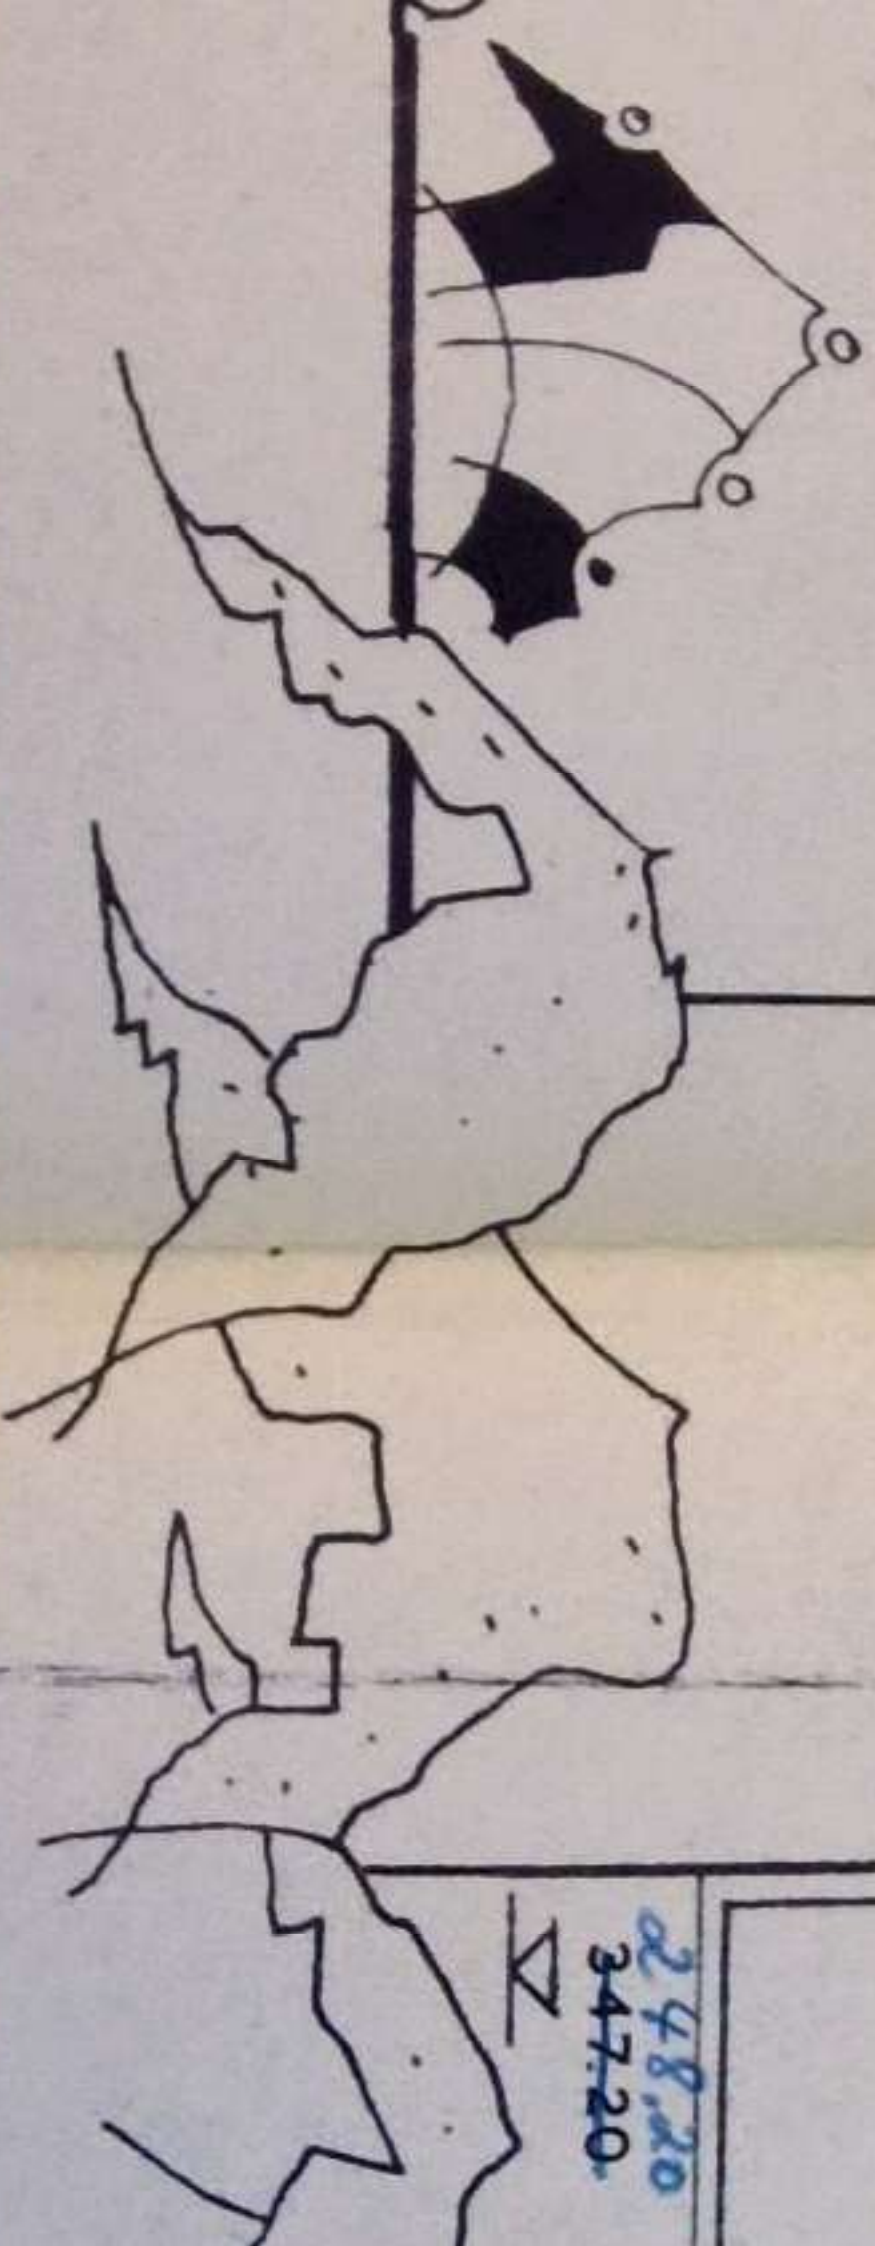

248.20
347.20

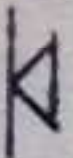

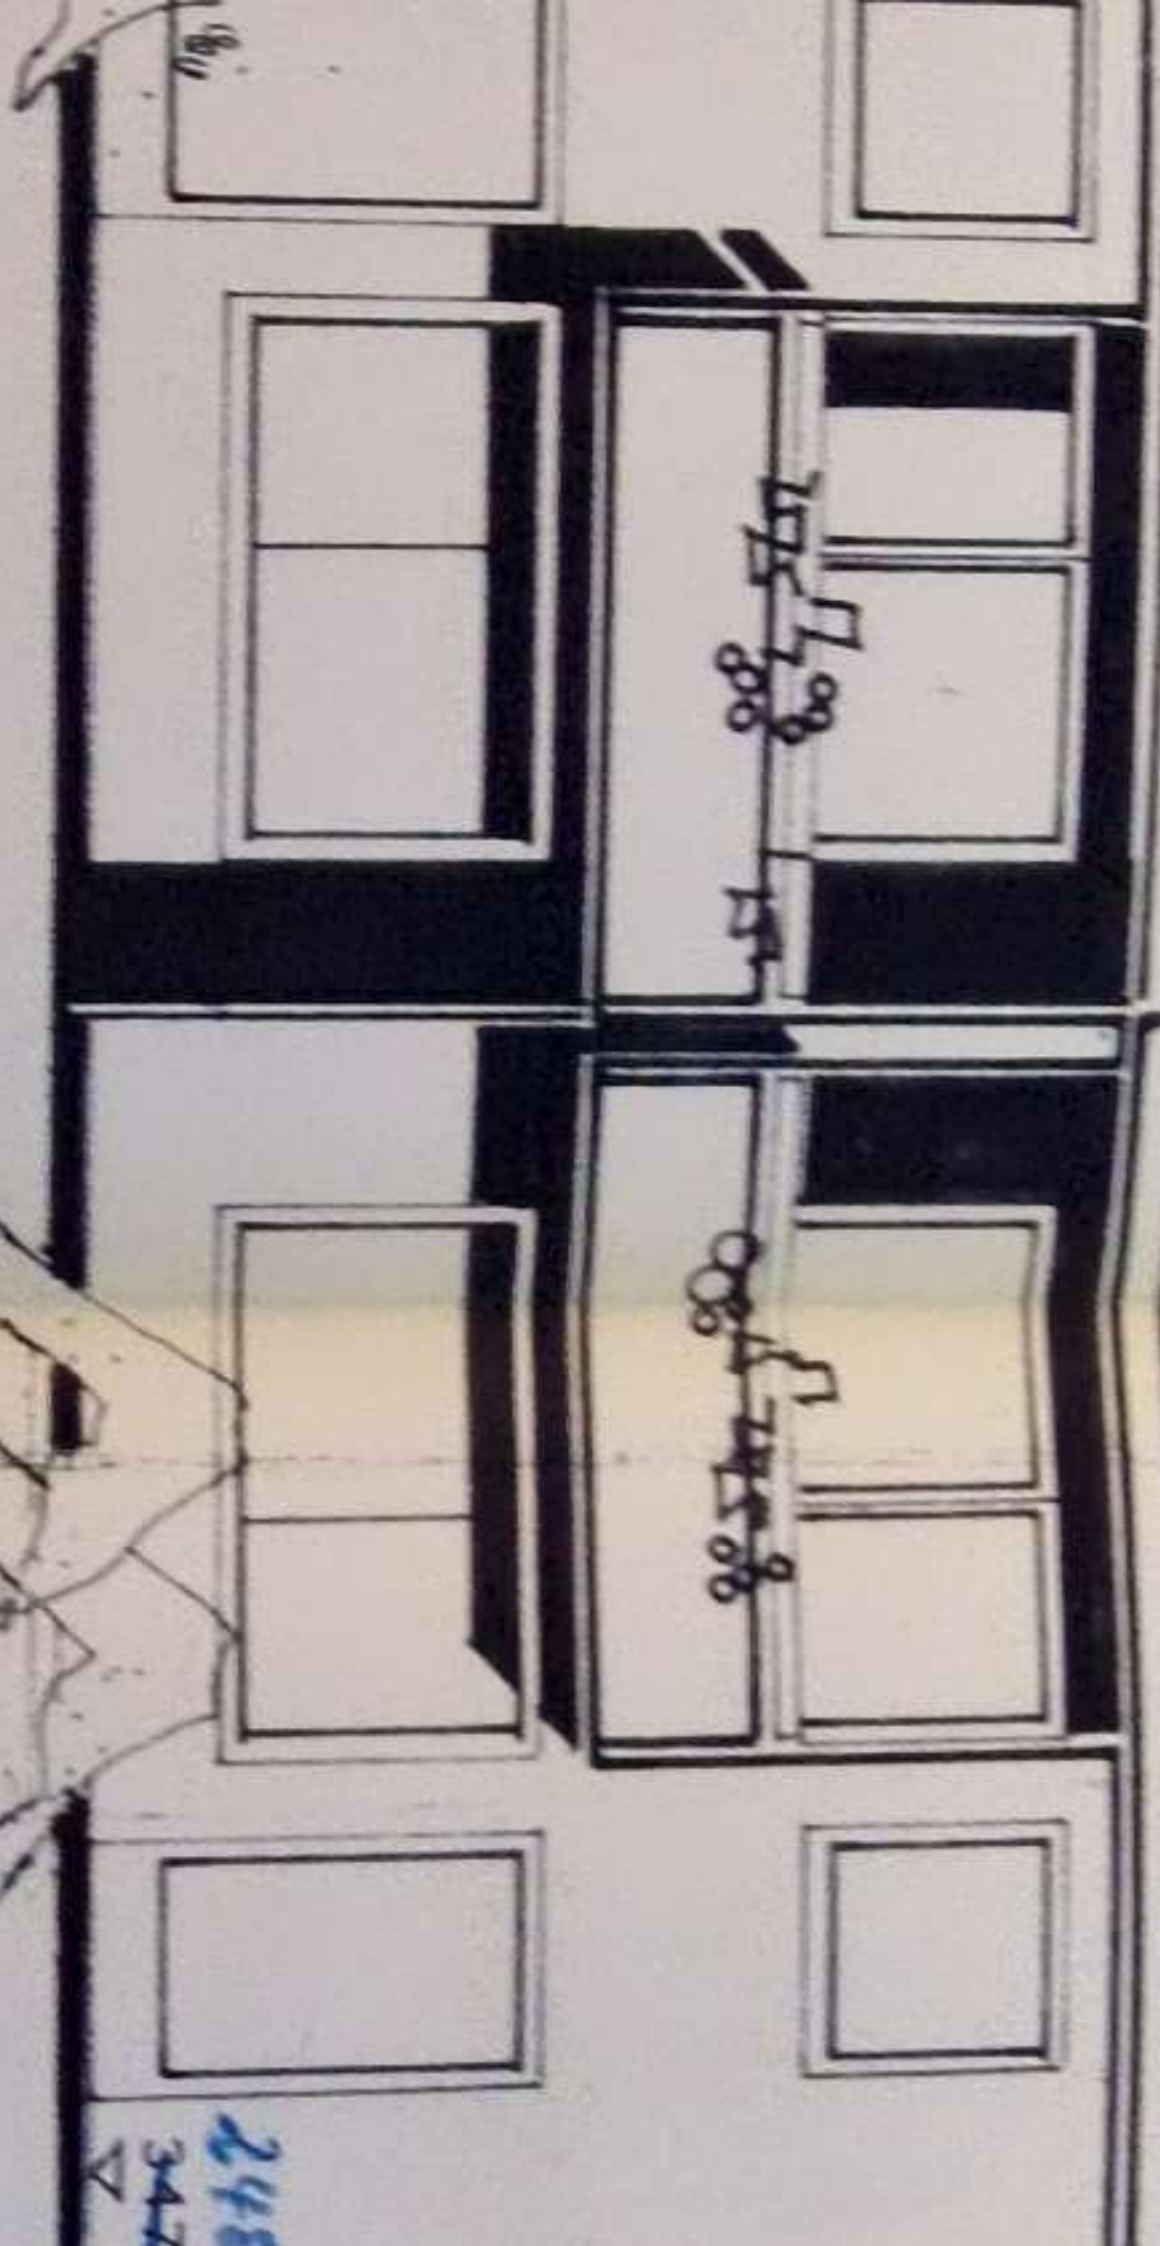



248
347
V

chitekt 6.500.-

atiker 800.-

ometer 500.-

ifstat. 400.-

igen. 300.-

httpausen 500.-

stiges 460.-

gebühr der Fa.

r-Rems =

=

bau. Garage. Aussenan

18.20

