


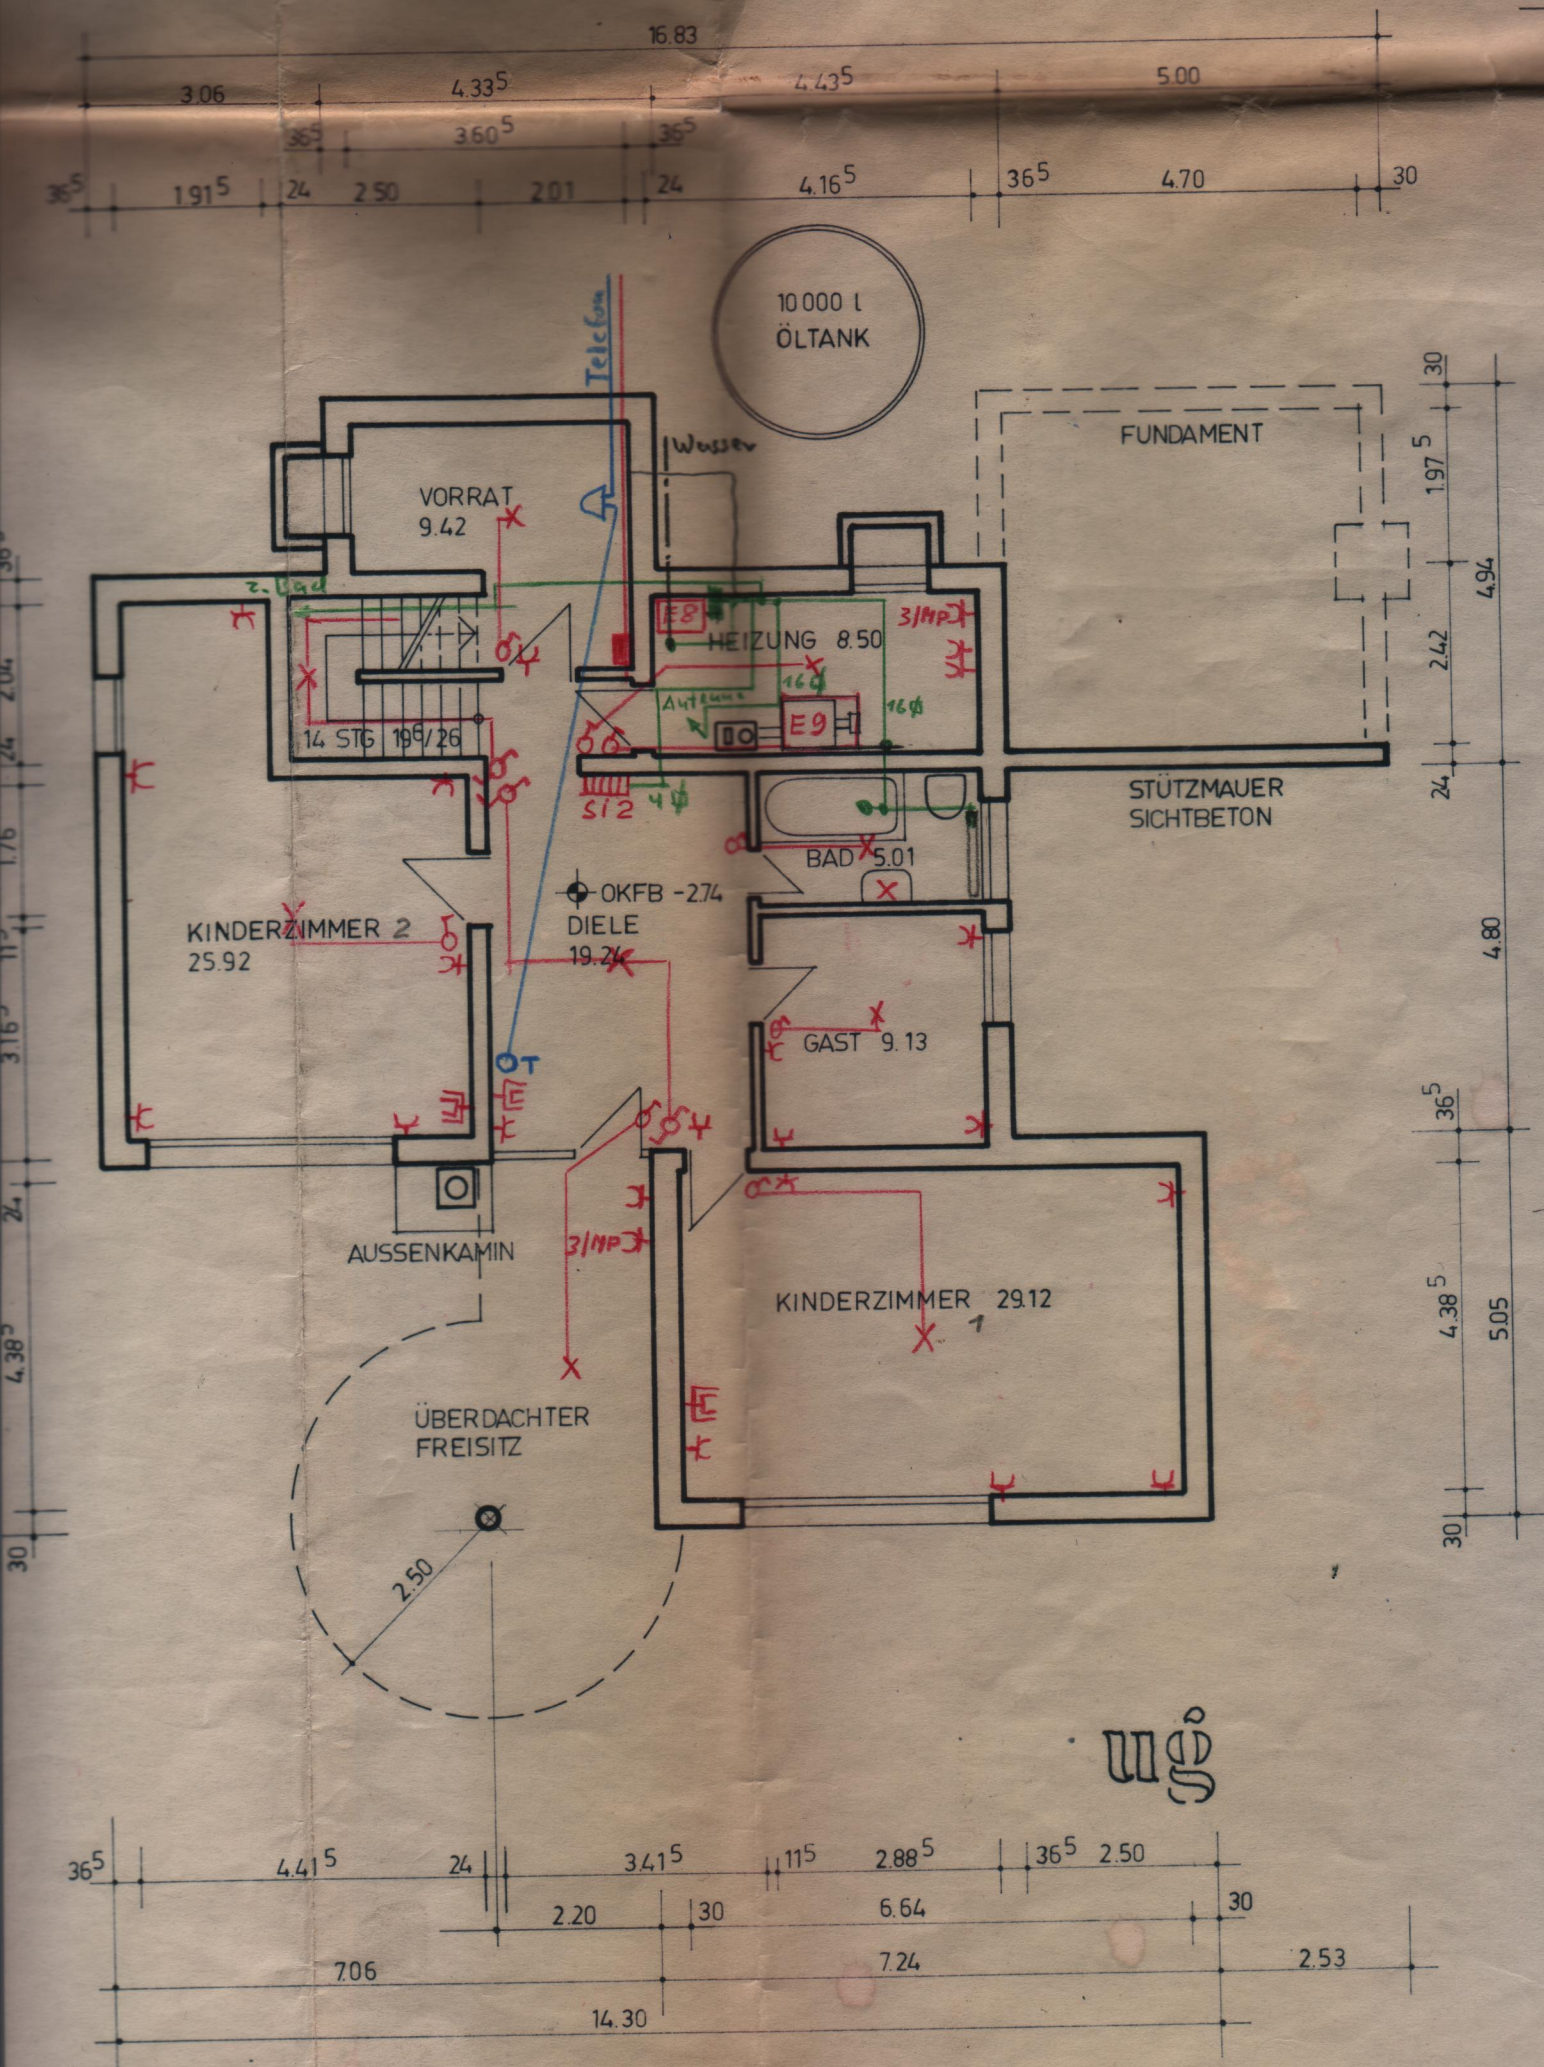


GEHSTEG

HECKEN HINTER RASENBORD-
STEINEN

MULLBOX

3.06 1.99 16.86 6.81 5.00
24 1.51 24
30 2.01 24 2.50 2.01 24 1.26 11.5 2.88⁵ 30

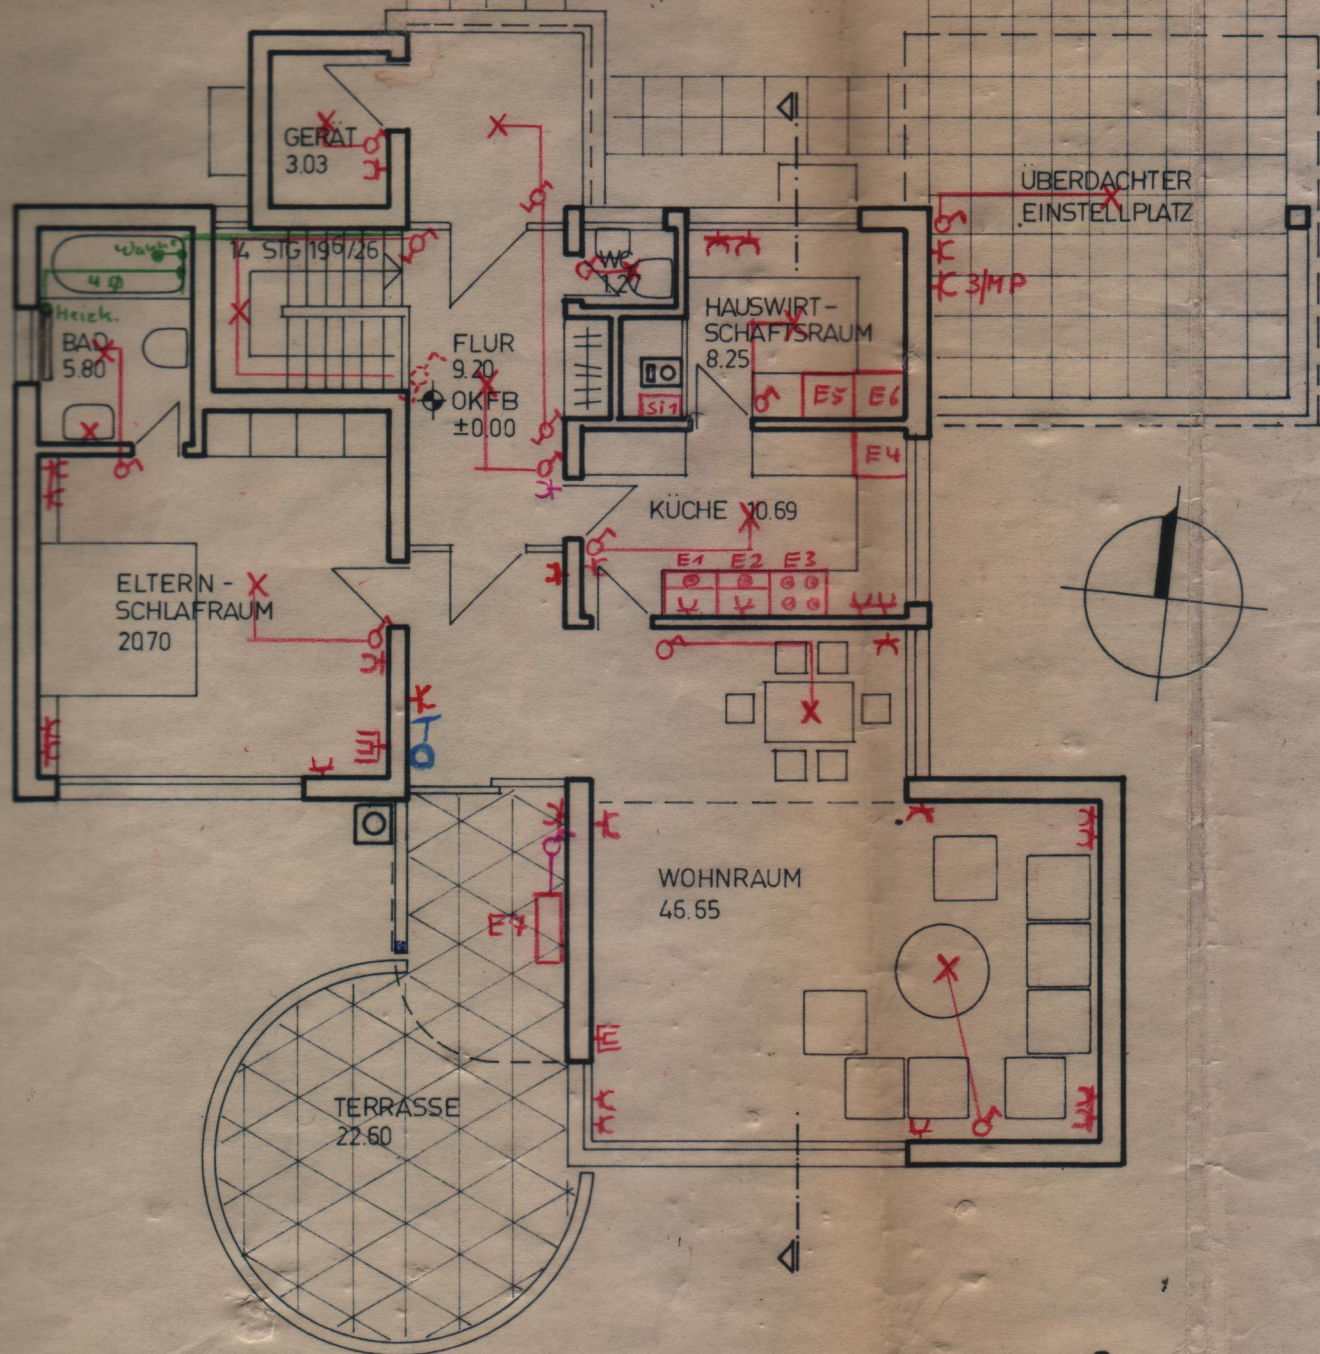

30 4.51 24 2.01 24 4.26 30 2.50
15 4.55 30 6.70 30
7.06 7.30 2.50
14.36