


Keller

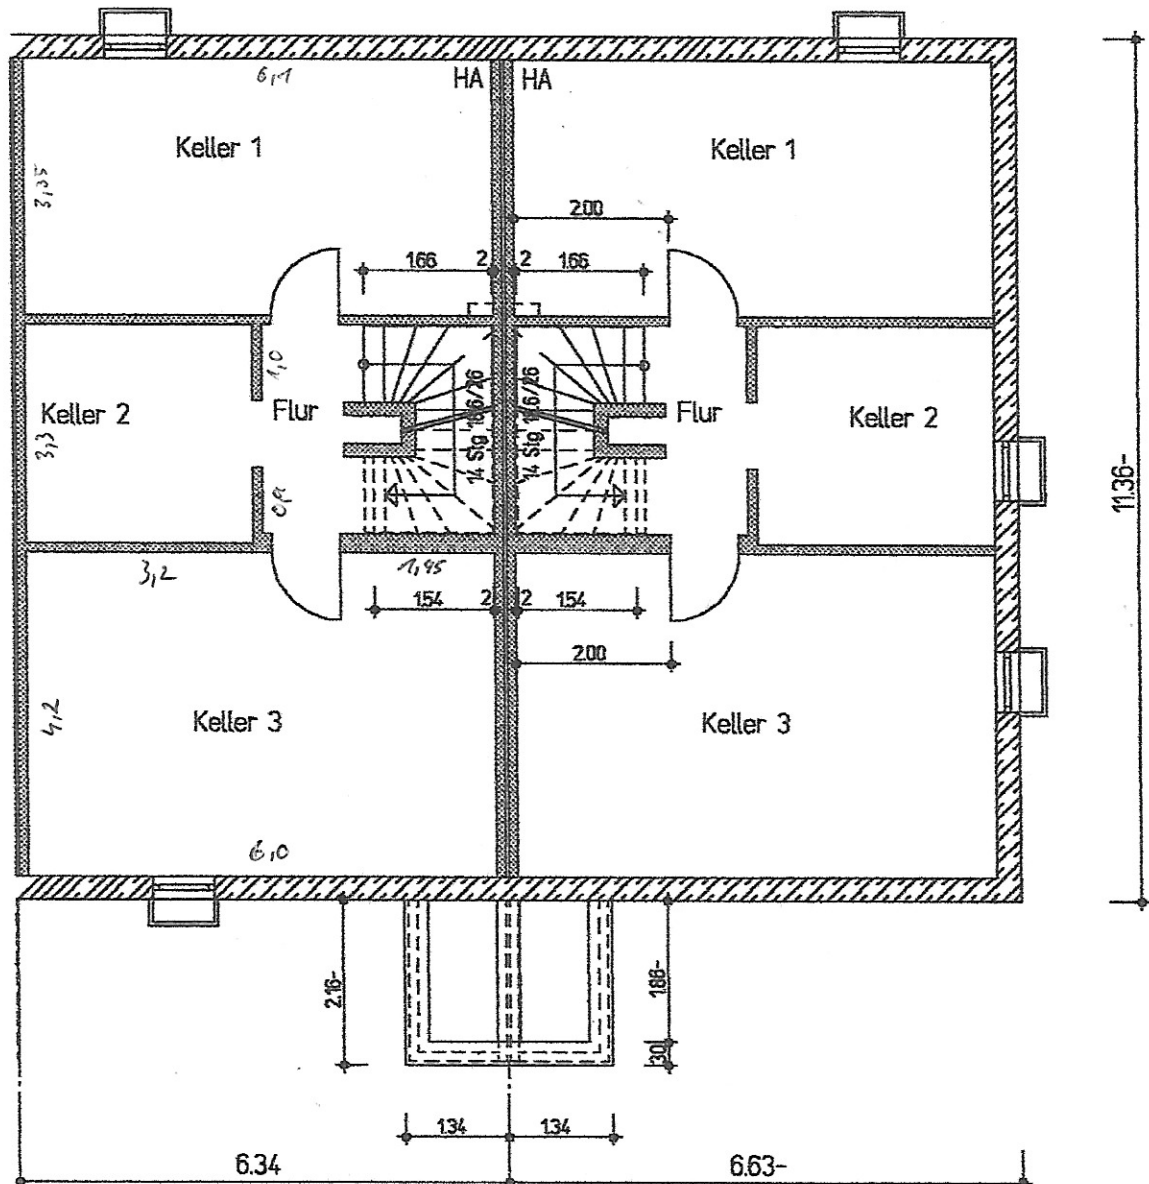

Mittelhaus

Keller I	20,55 m ²
Keller II	8,50 m ²
Keller III	25,92 m ²
Flur	5,53 m ²
	60,50 m ²

Endhaus

Keller I	21,98 m ²
Keller II	9,72 m ²
Keller III	26,29 m ²
Flur	5,53 m ²
	63,52 m ²

Maßstab 1:100