


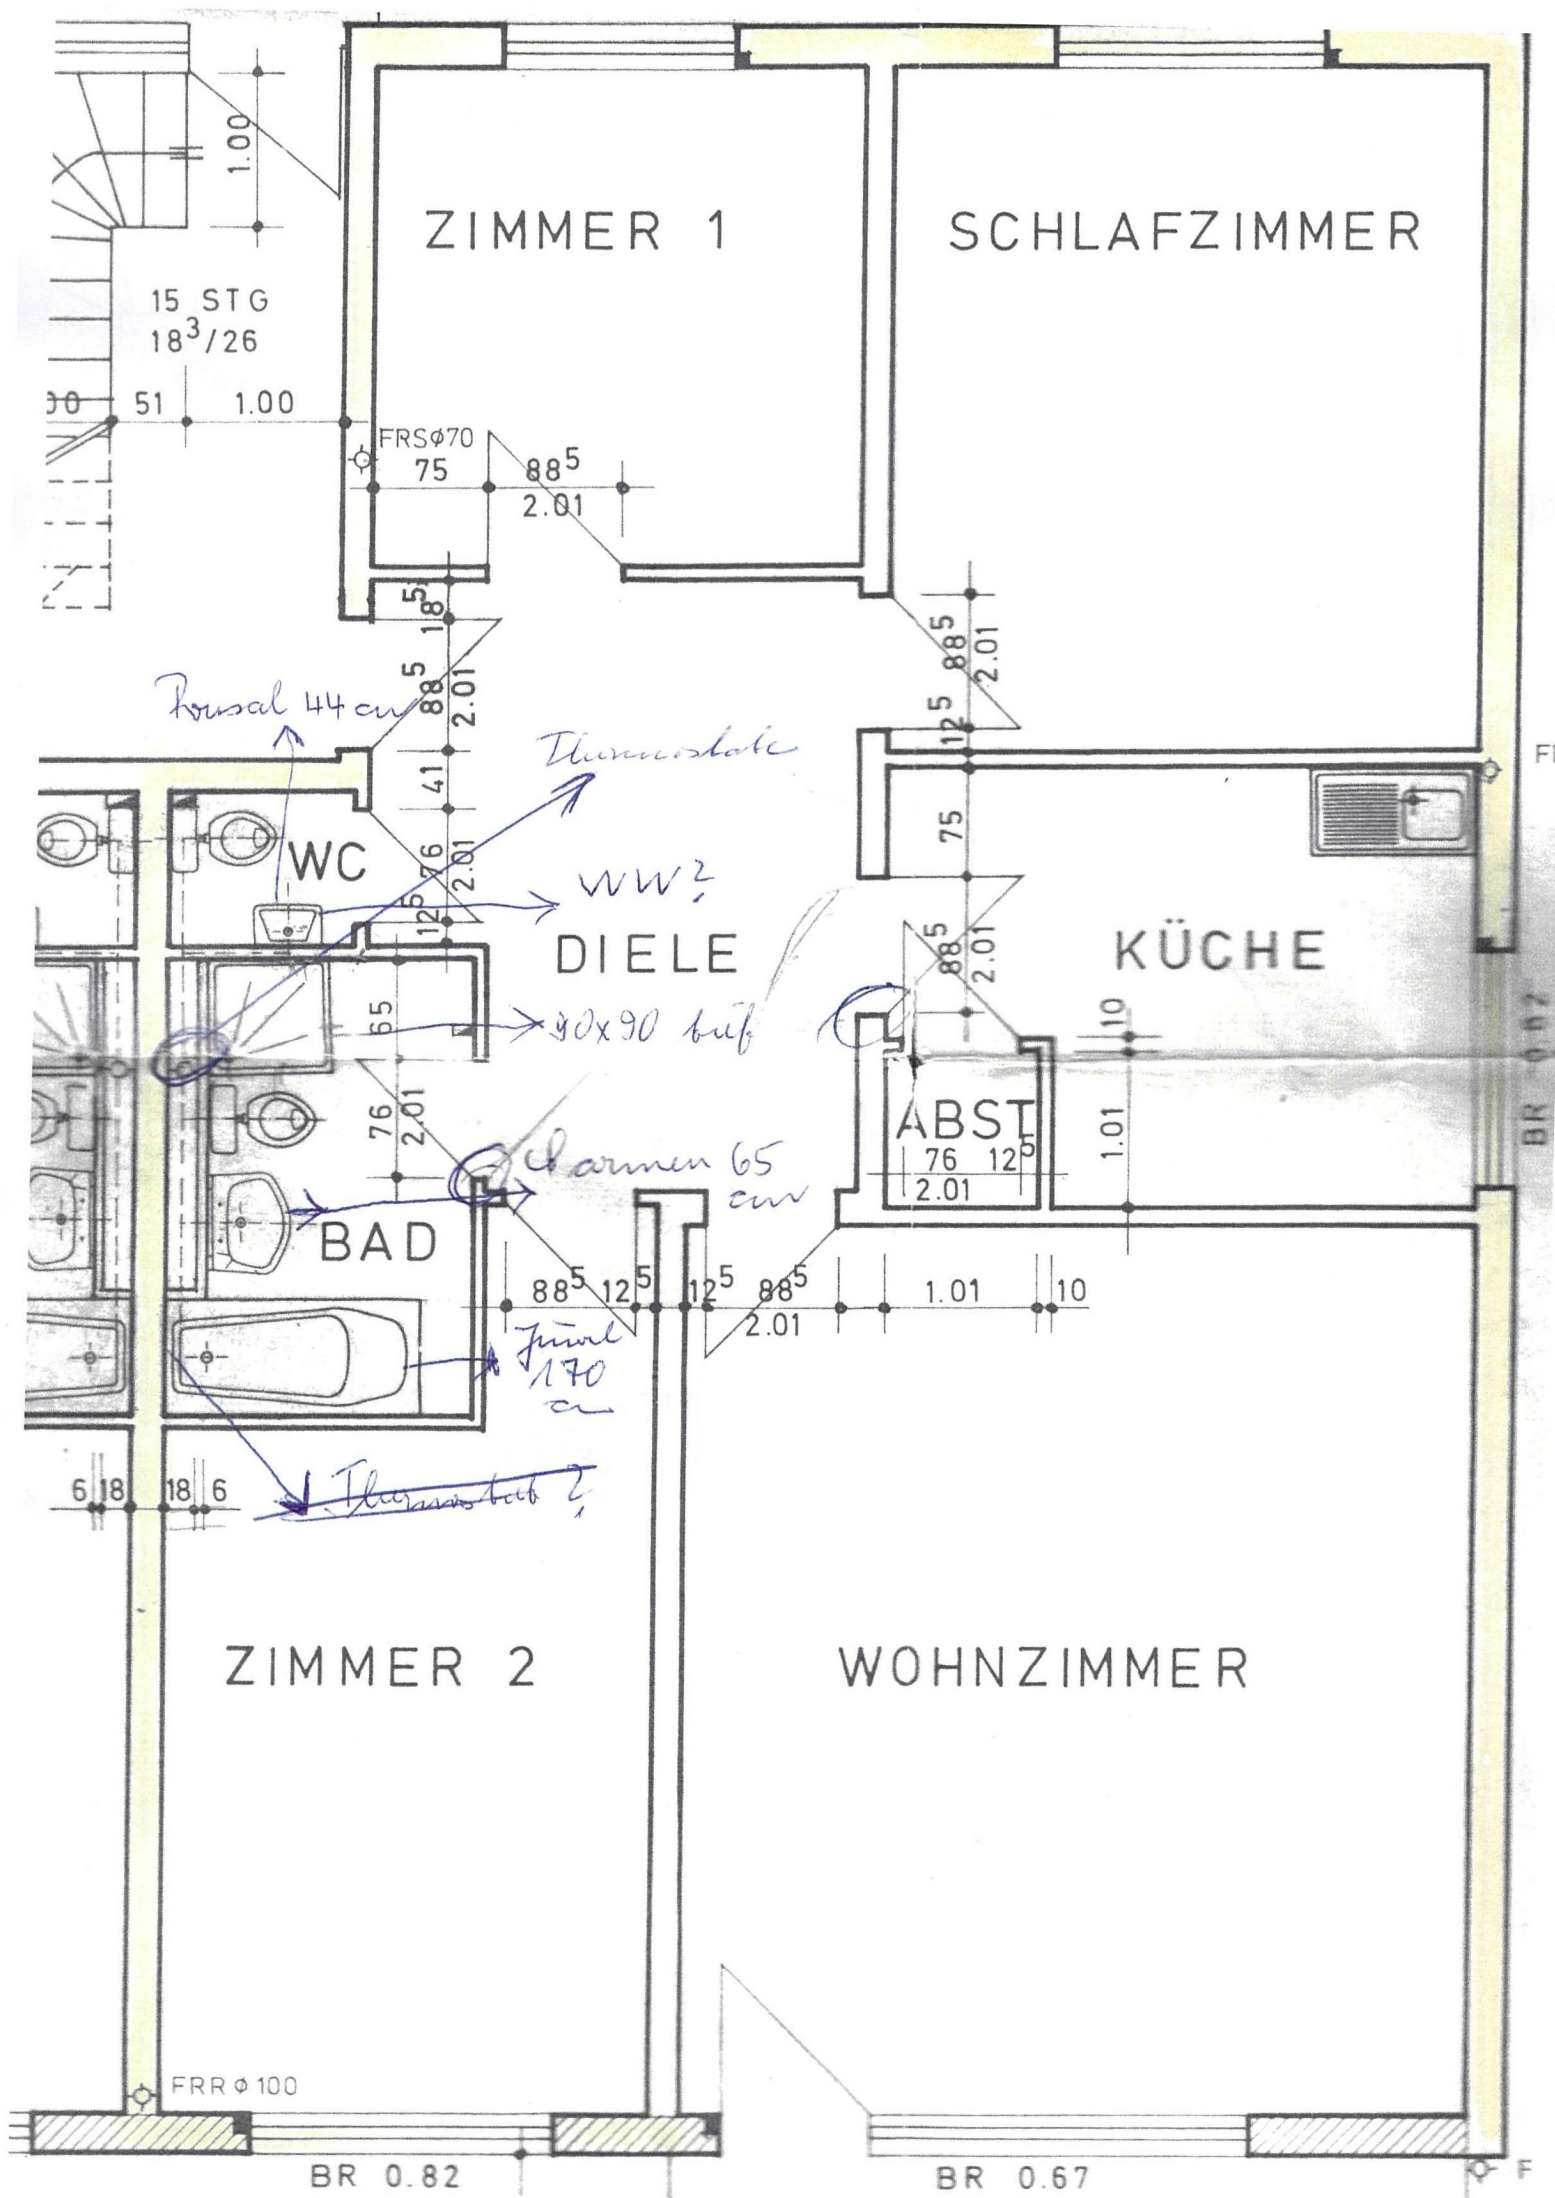

ZIMMER 1

SCHLAFZIMMER

15 STG
18³/26

FRS Ø70
75

885
2.01

Türsal 44 cm

Thermostate

WW?

DIELE

90x90 bnf

WC

KÜCHE

ABST

76 12⁵
2.01

BAD

Charmen 65 cm

Türsal 170 cm

ZIMMER 2

WOHNZIMMER

FRR Ø100

BR 0.82

BR 0.67