
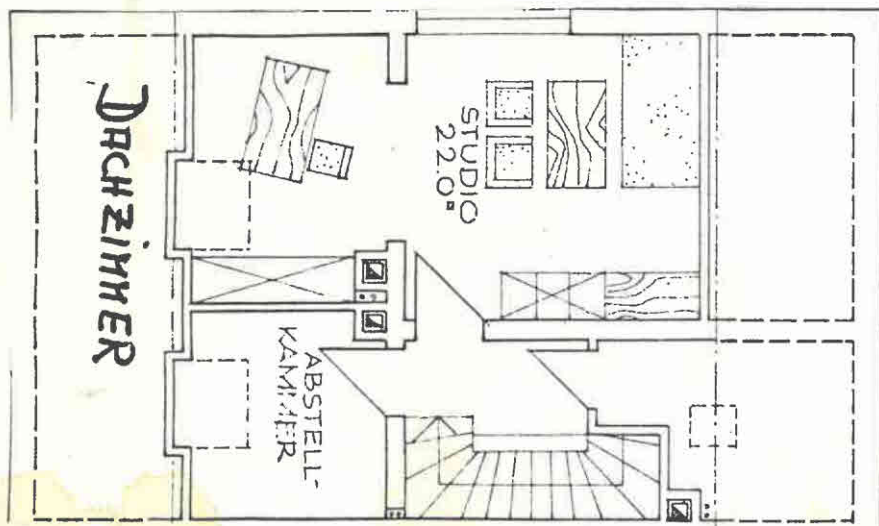
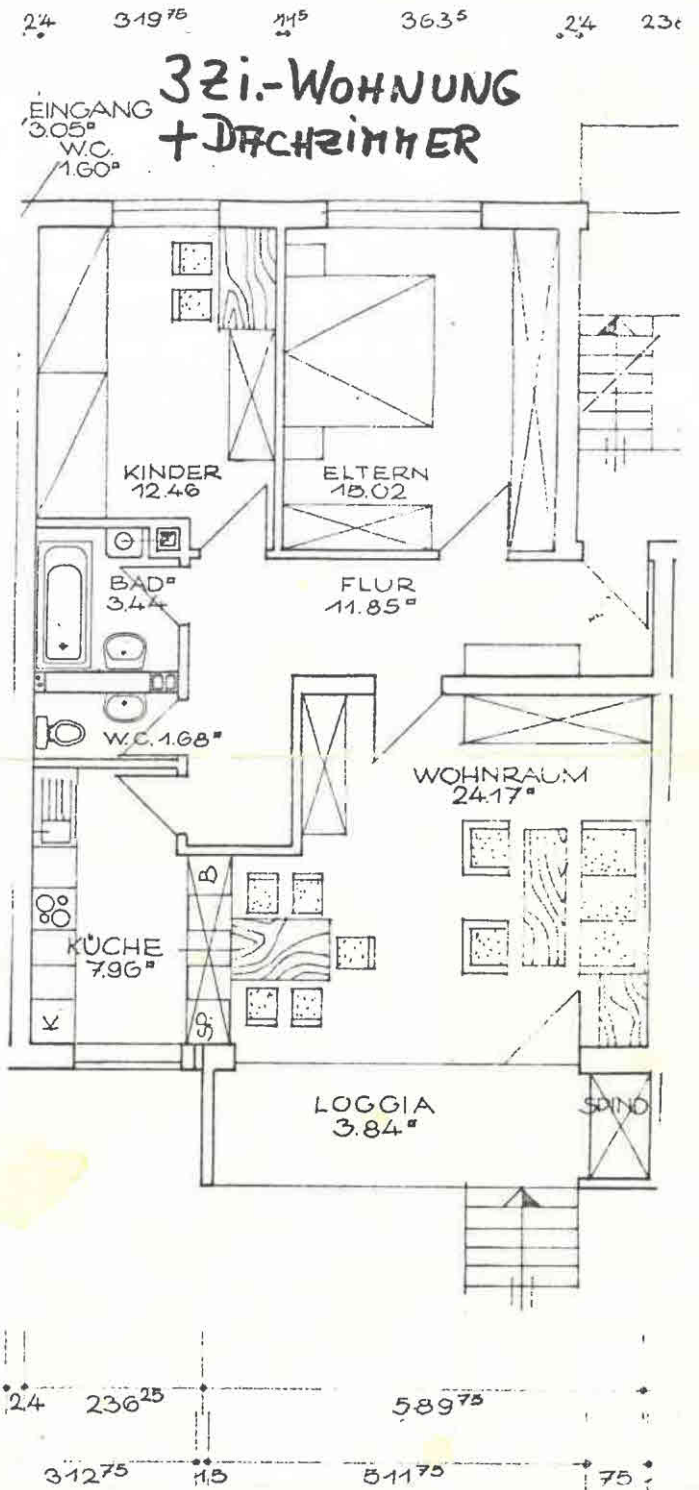


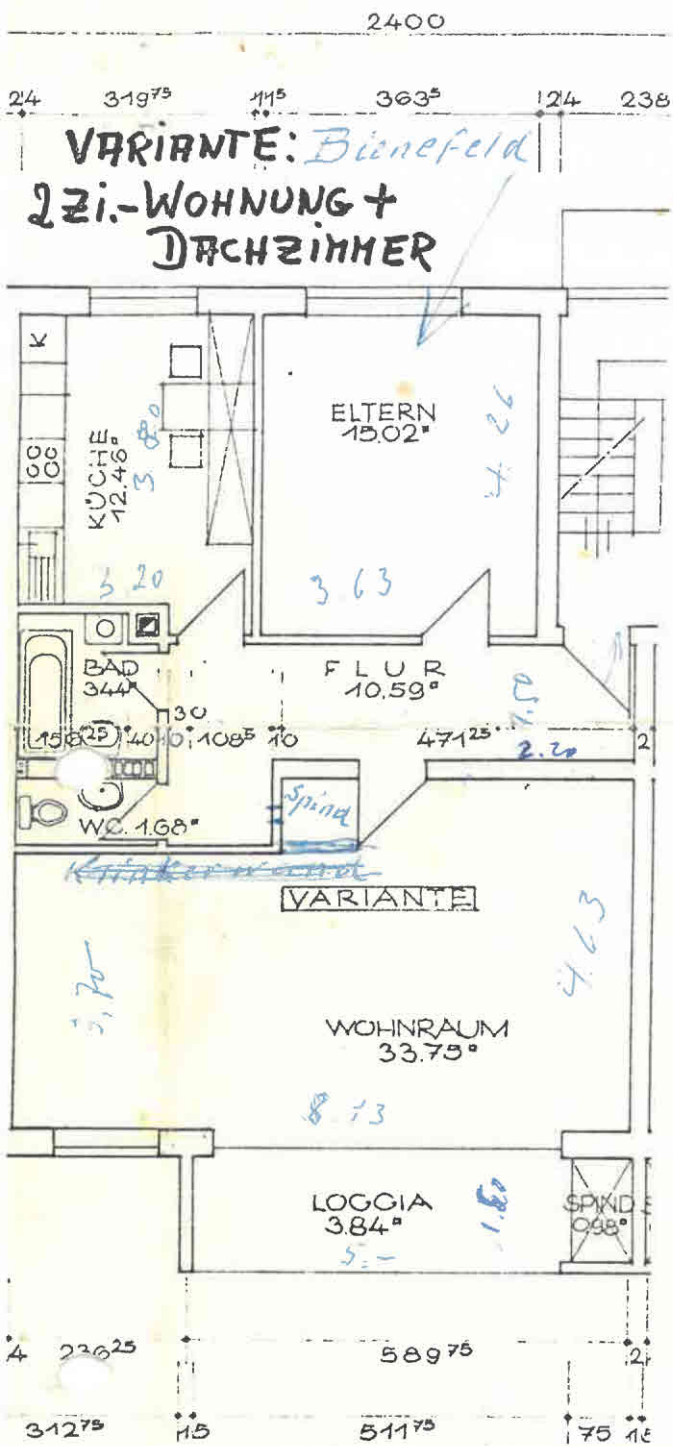

IMMOB. ASTRID GILLE
4048 GREVENBACH - Bahnstr. 107