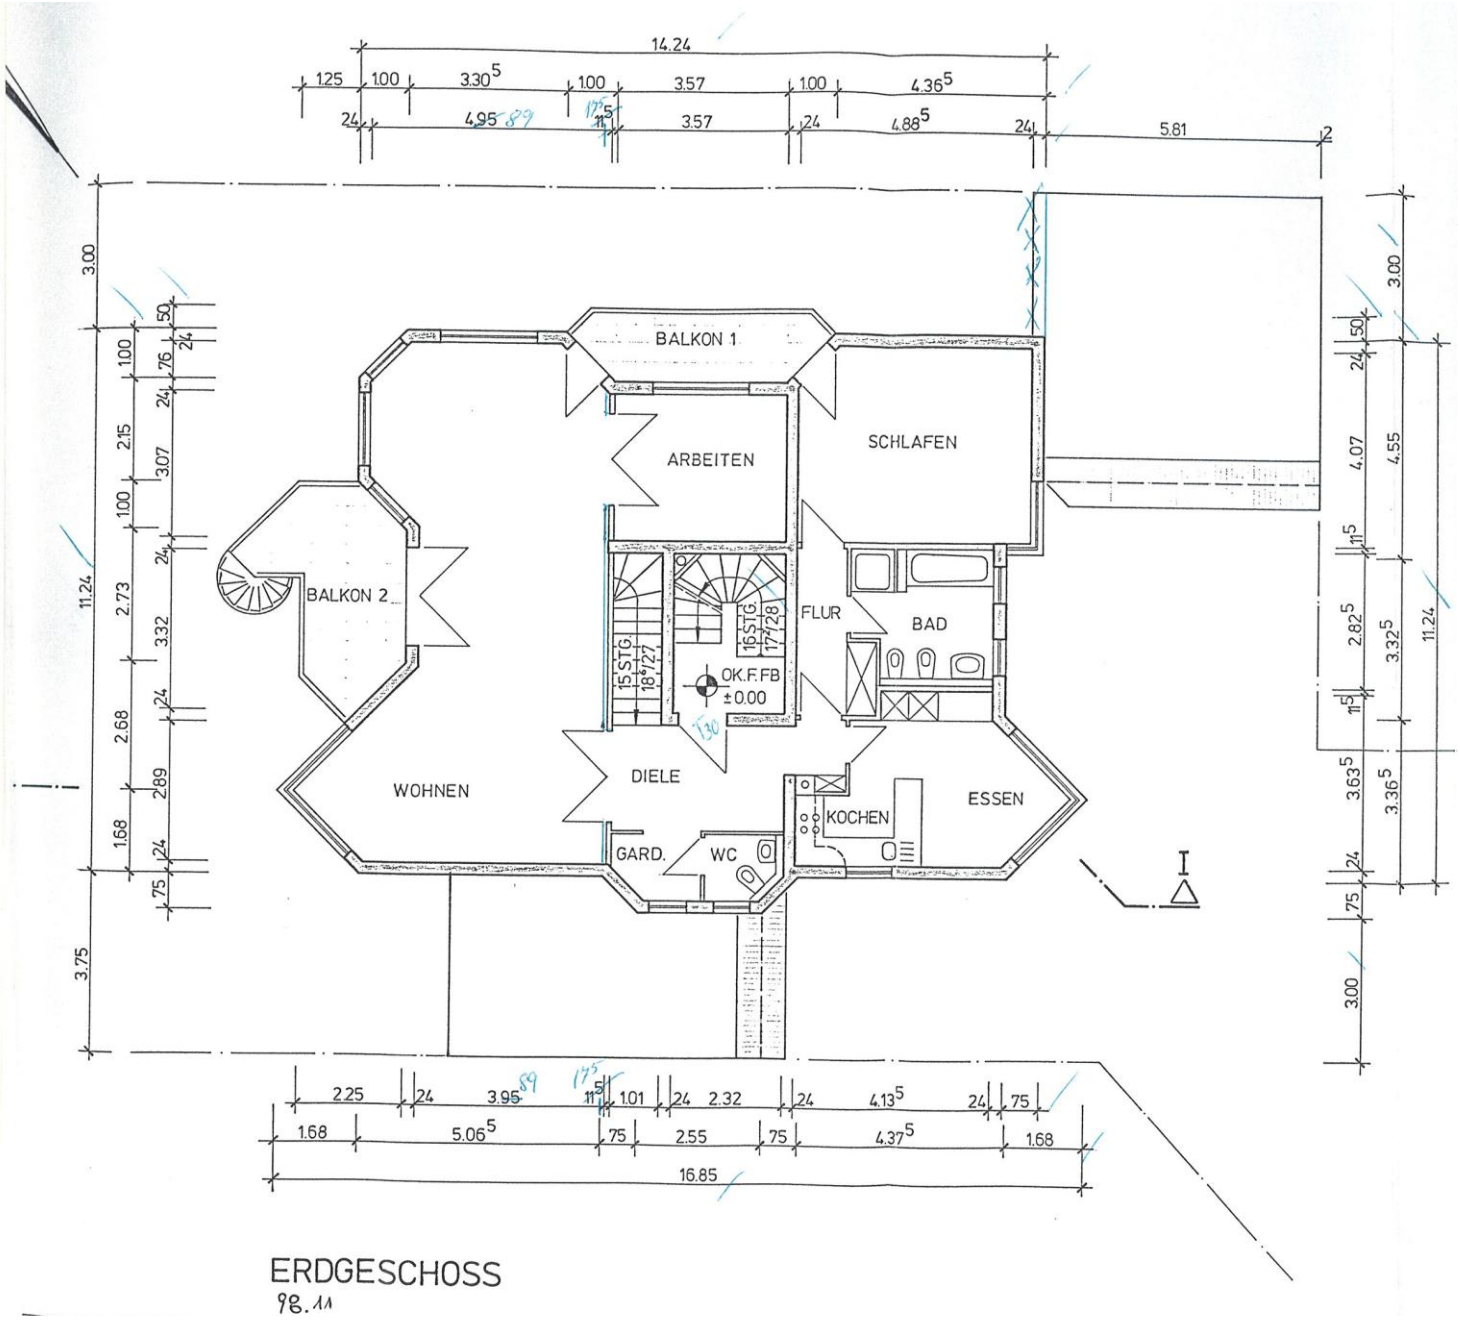

ERDGESCHOSS

98.11