



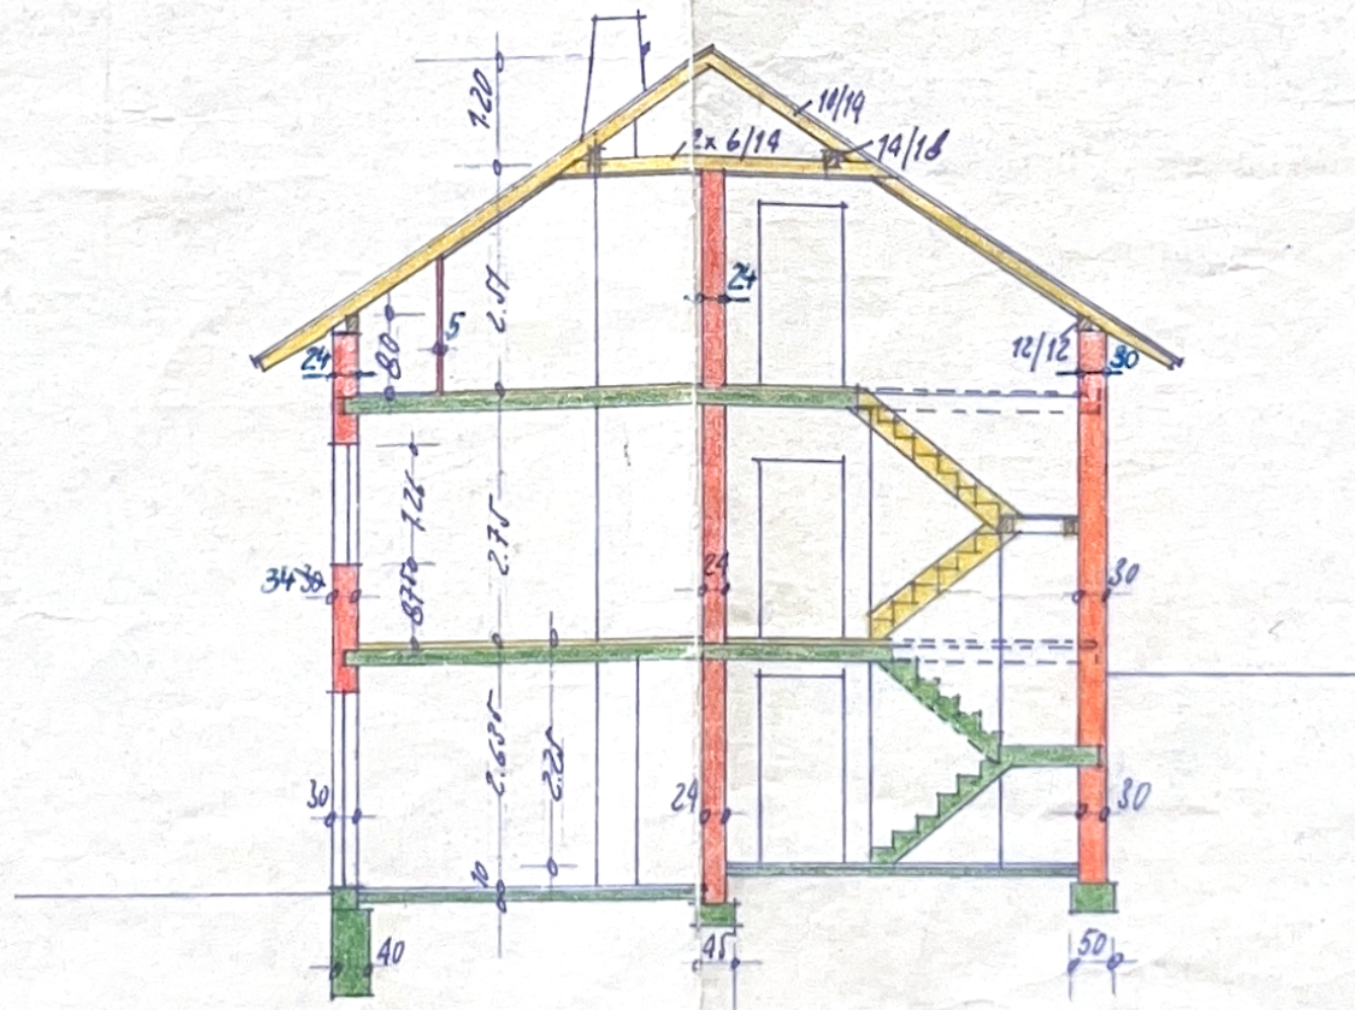


SCHNITT

KELLERGEOSCHOSS

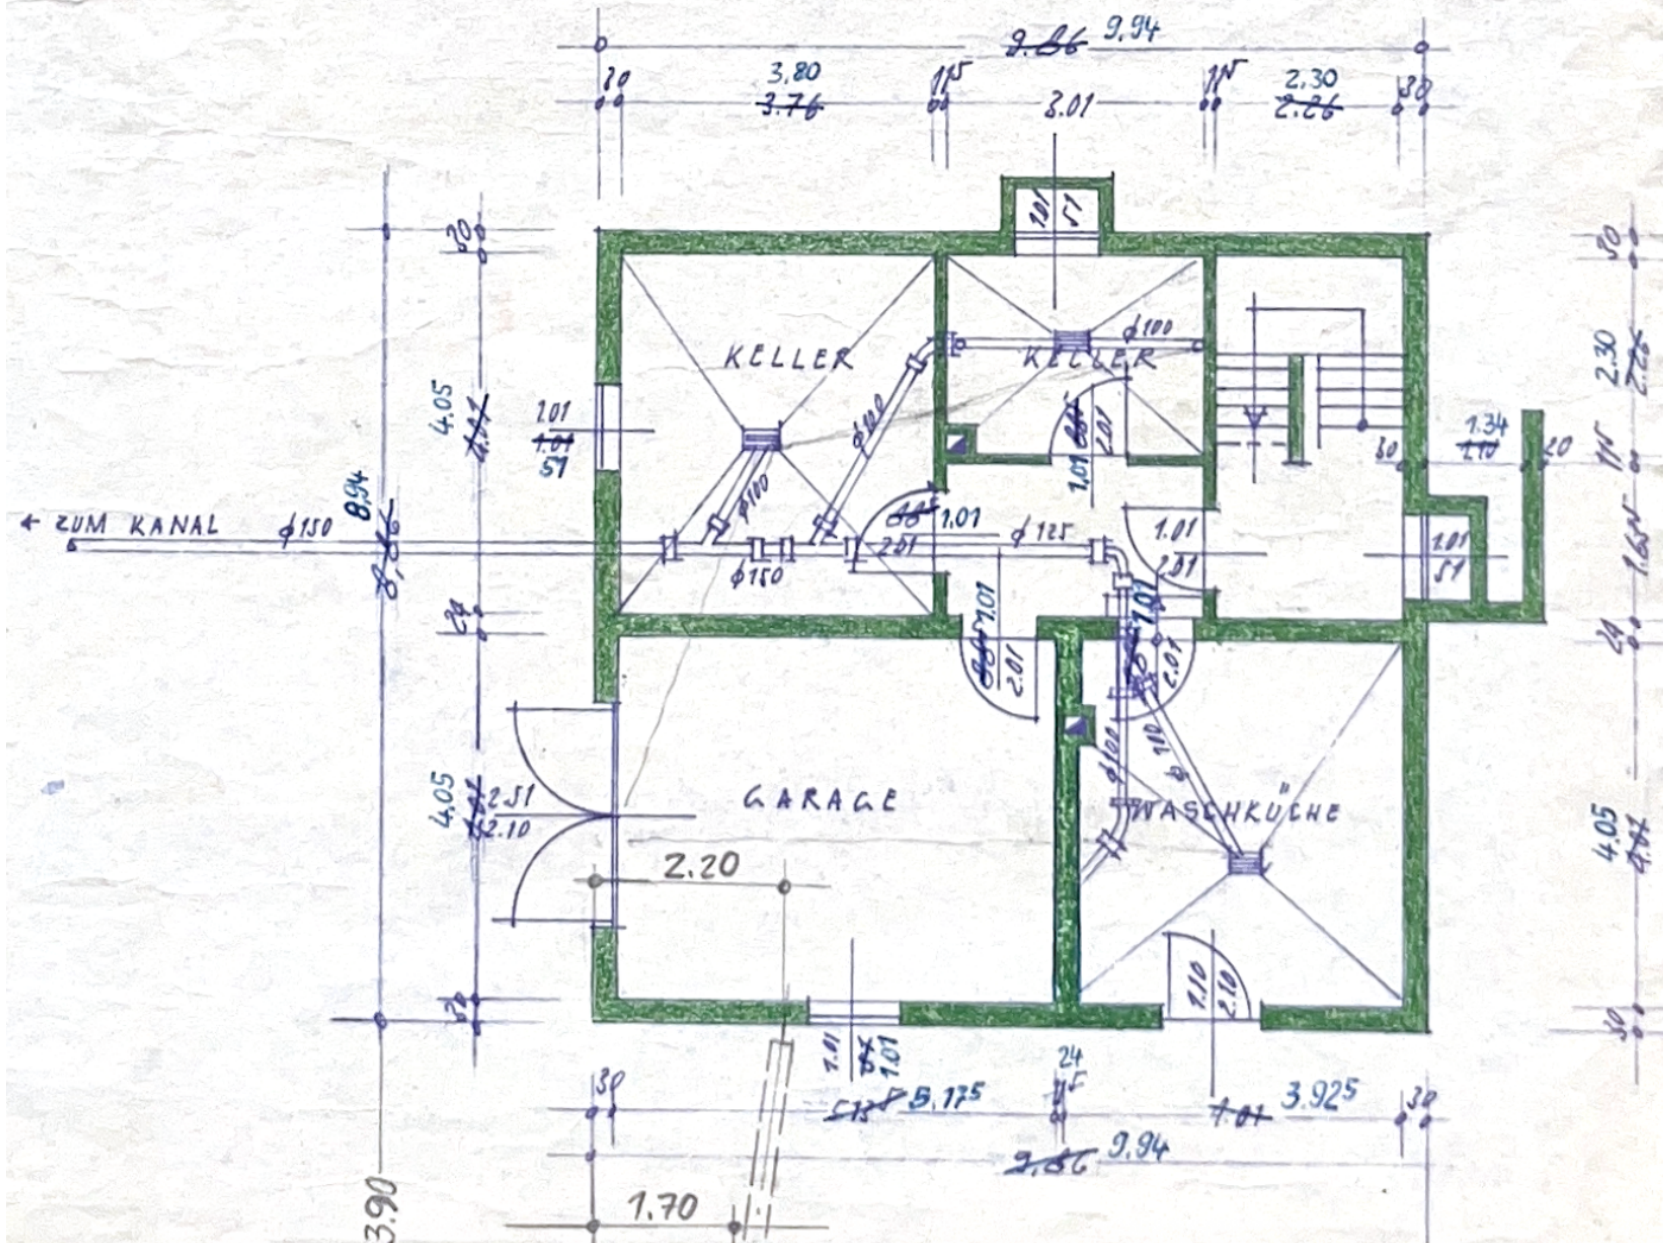

ERDGESCHOSS

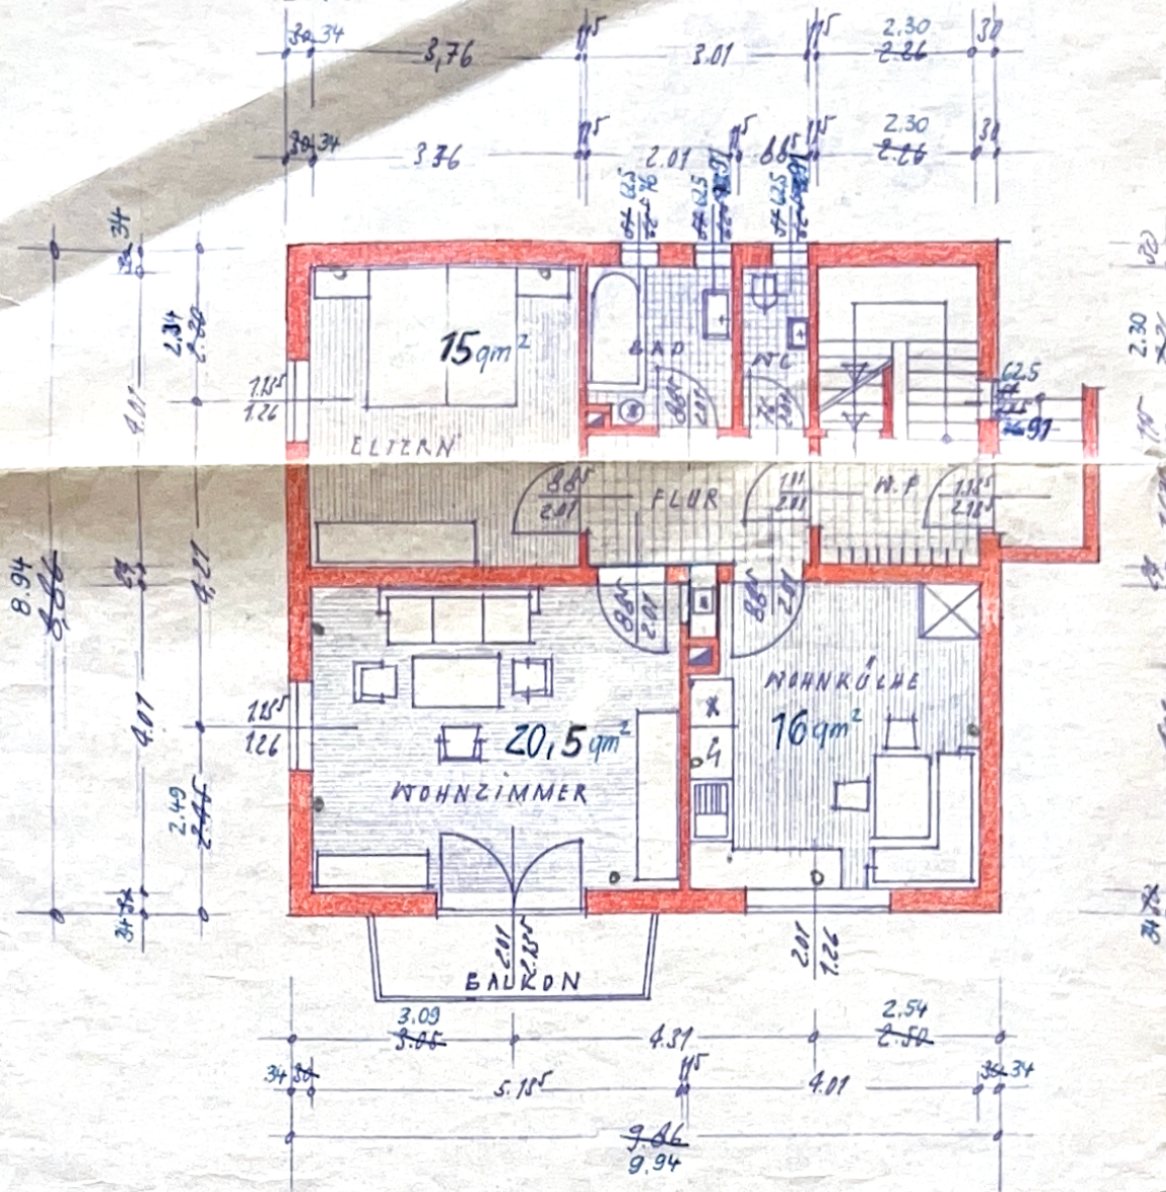

2494
00

3.86
~~3.76~~

115
00

2.01

115
00

115
00

230
~~2.26~~

30
00

