


Erdgeschoss

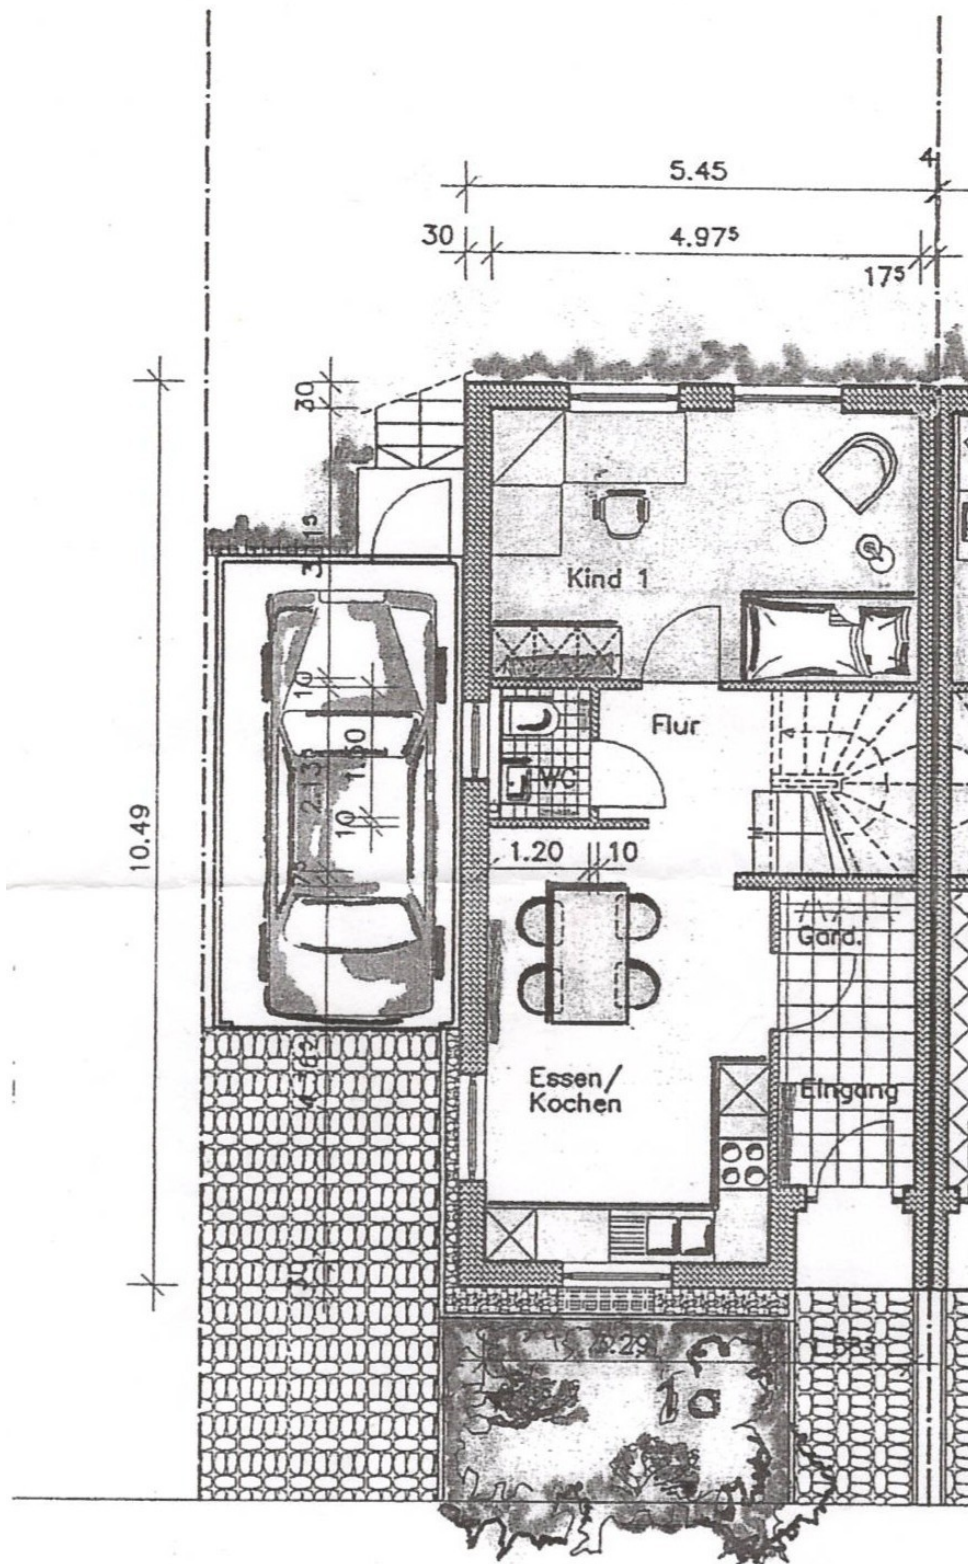


Eingang/Garderobe	5,40m ²
Essen/Kochen	16,50m ²
Flur	3,10m ²
Gäste WC	1,80m ²
Kind 1	15,33m ²
Summe	42,10m ²

9

1.1

Obergeschoss

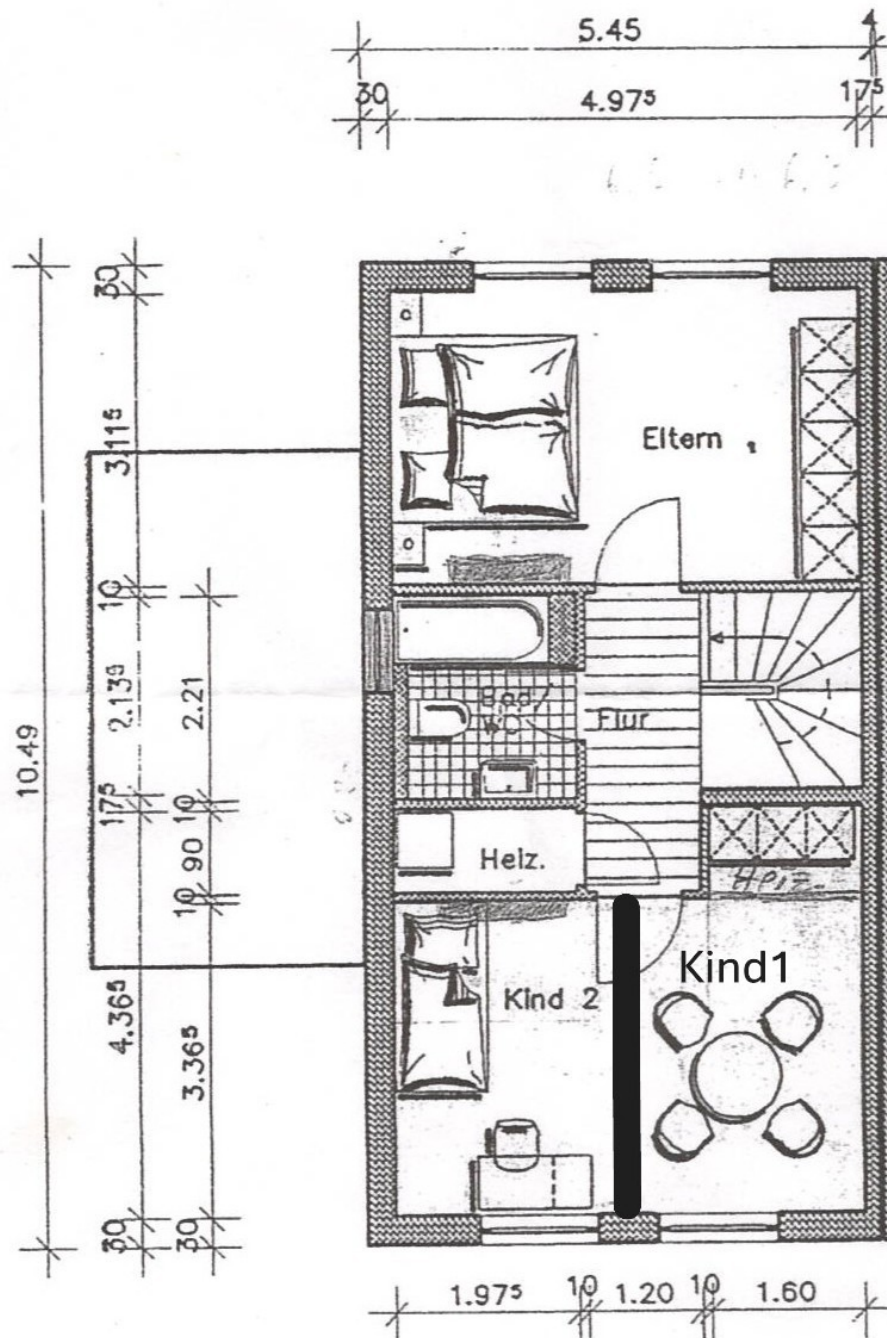

1a

Kind 2	18,10m ²
Bad/WC	4,33m ²
Flur	4,20m ²
Eltern	15,33m ²
Summe	42,00m ²

Heizungsraum 1,76m²



Keller 21,40 m²