


2.26 | | 2.26 | | 2.26 | |

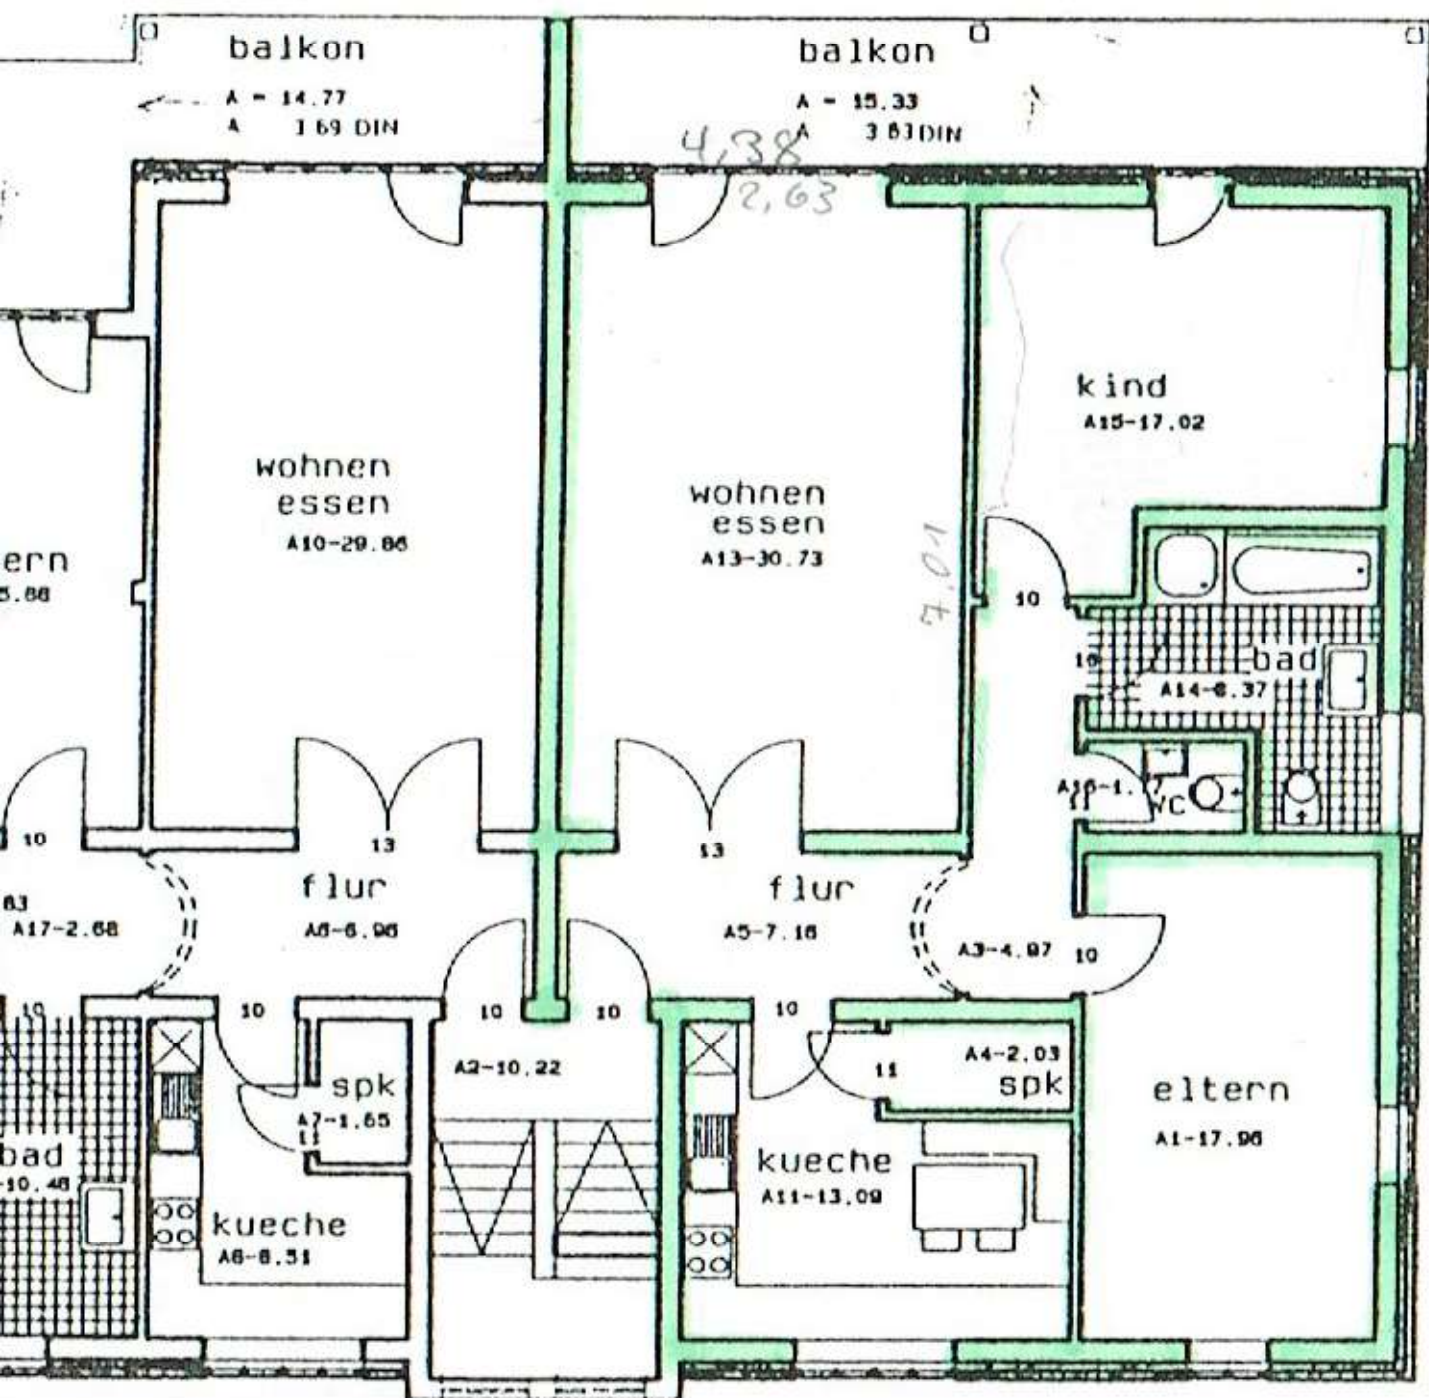

03

04