


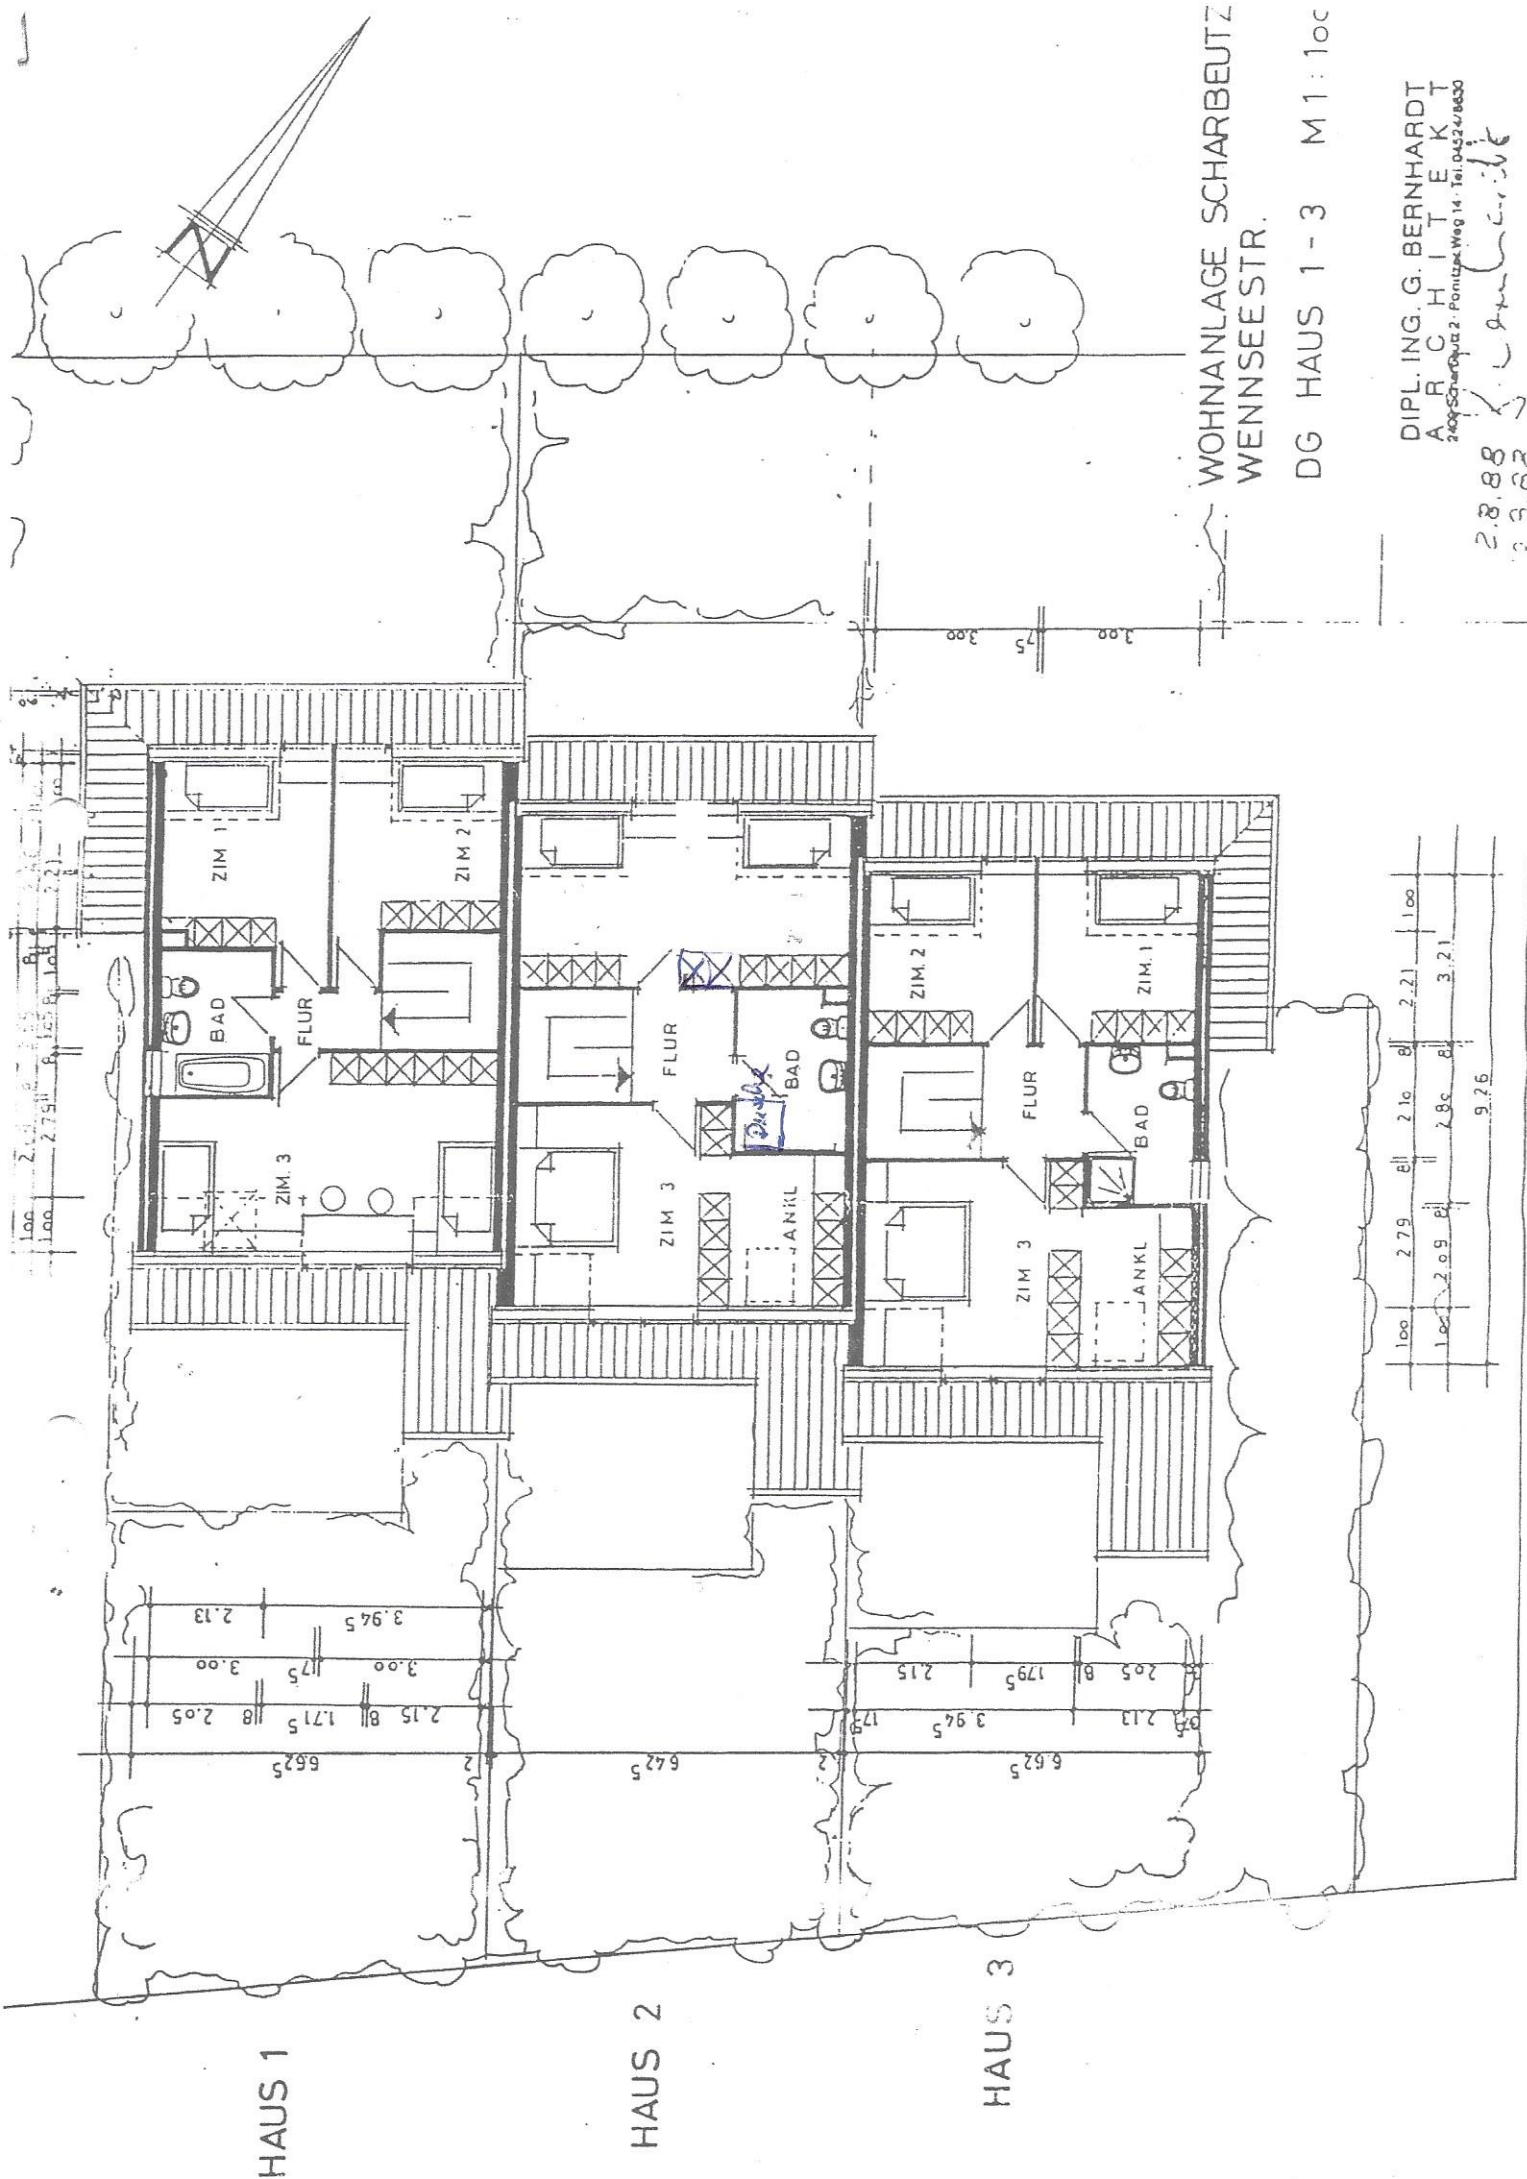

WOHNANLAGE SCHARBEUTZ
WENNSEESTR.

DG HAUS 1-3 M1:100

DIPL. ING. G. BERNHARDT
ARCHITECT
2409 Scharbeutz, Pönitzweg 14, Tel. 04524/8630

2.8.88
3.3.88

100	2.79	2.10	2.21	1.00
100	2.09	2.80	3.21	
		9.25		