

BRANDWAND

B

ÜBERDACHTER
ABSTELLPLATZ

5.50

2.4

GARAGE
-1.25

6.02

B

TERRASSE
-0.50

SCHLAFEN
19.17 qm

BAD
7.52 qm

ABLUF
20/20

KOCHN.
2.31 qm

DUSCHE
3.22 qm

VORR.
1.61 qm

ZIMMER
15.65 qm

3 STG.
17.2/26

5 STG.
17.5/26

-1.07

ABST.
1.32 qm

DIELE
9.13 qm
±0.00

WOHNEN
28.75 qm
-0.45

ESSEN
13.69 qm

KÜCHE
10.10 qm

A

*Se w entlüften gem
DIN 18017*

ERDGESCHOSS

Sudetenstrasse

14.66

2.57

1.57

2.60

1.00


2.40


3.26

6.35

2.00


14.66

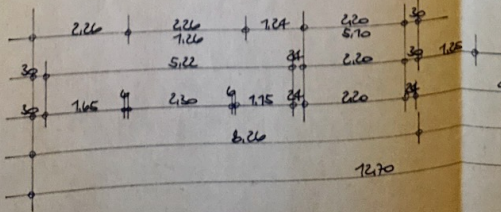

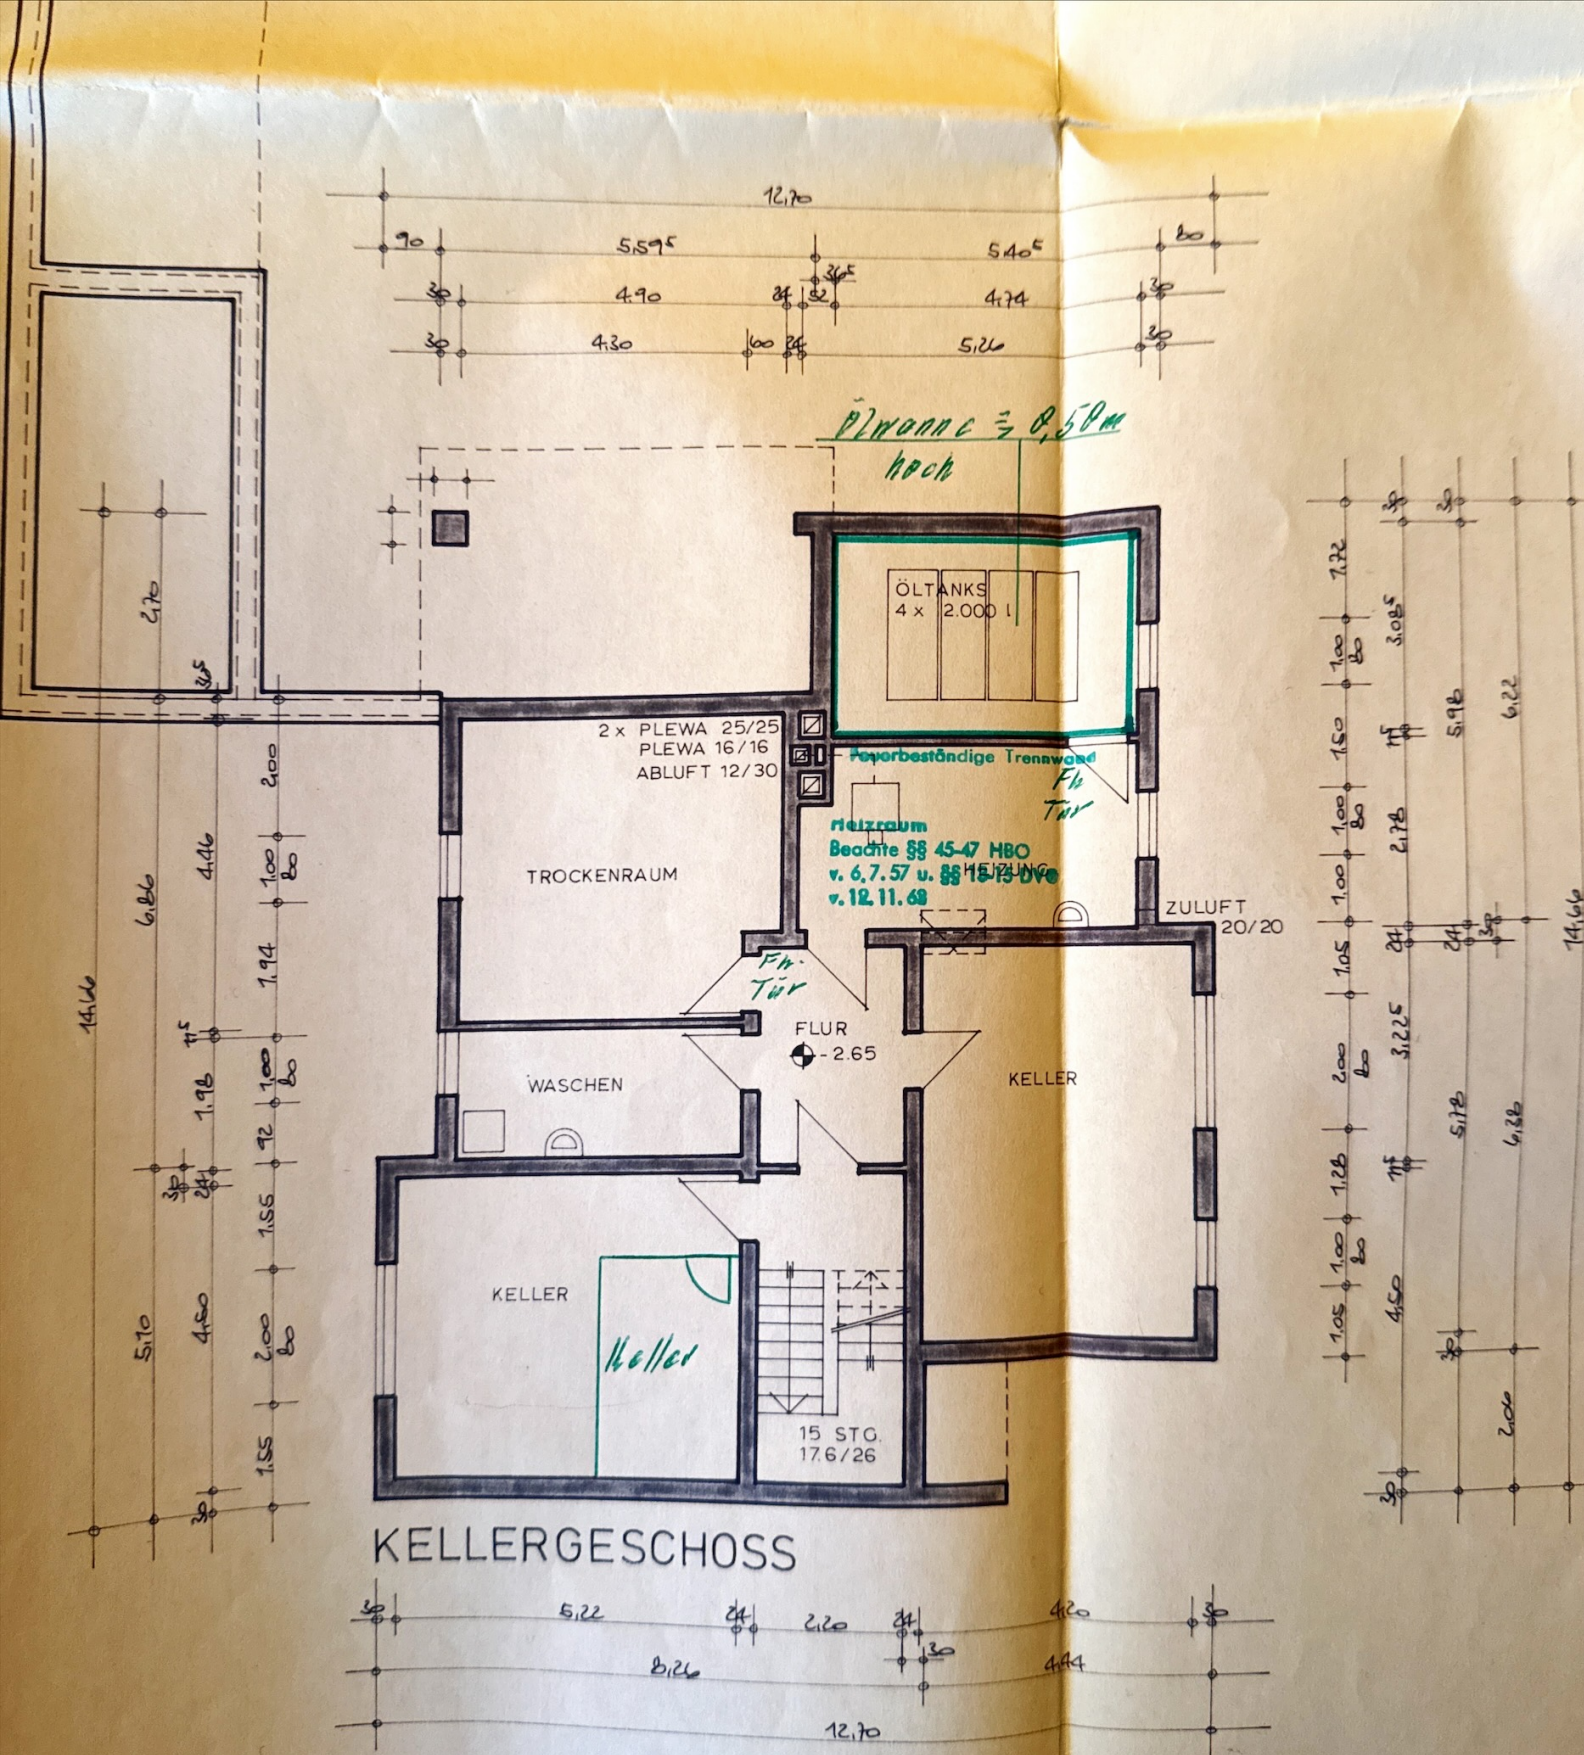

DACHKONSTRUKTION: HOLZ, NACH STAT. BERECHNUNG
 DACHDECKUNG: PFANNEN
 DACHNEIGUNG: 38°

Fenstermaße
Bohle

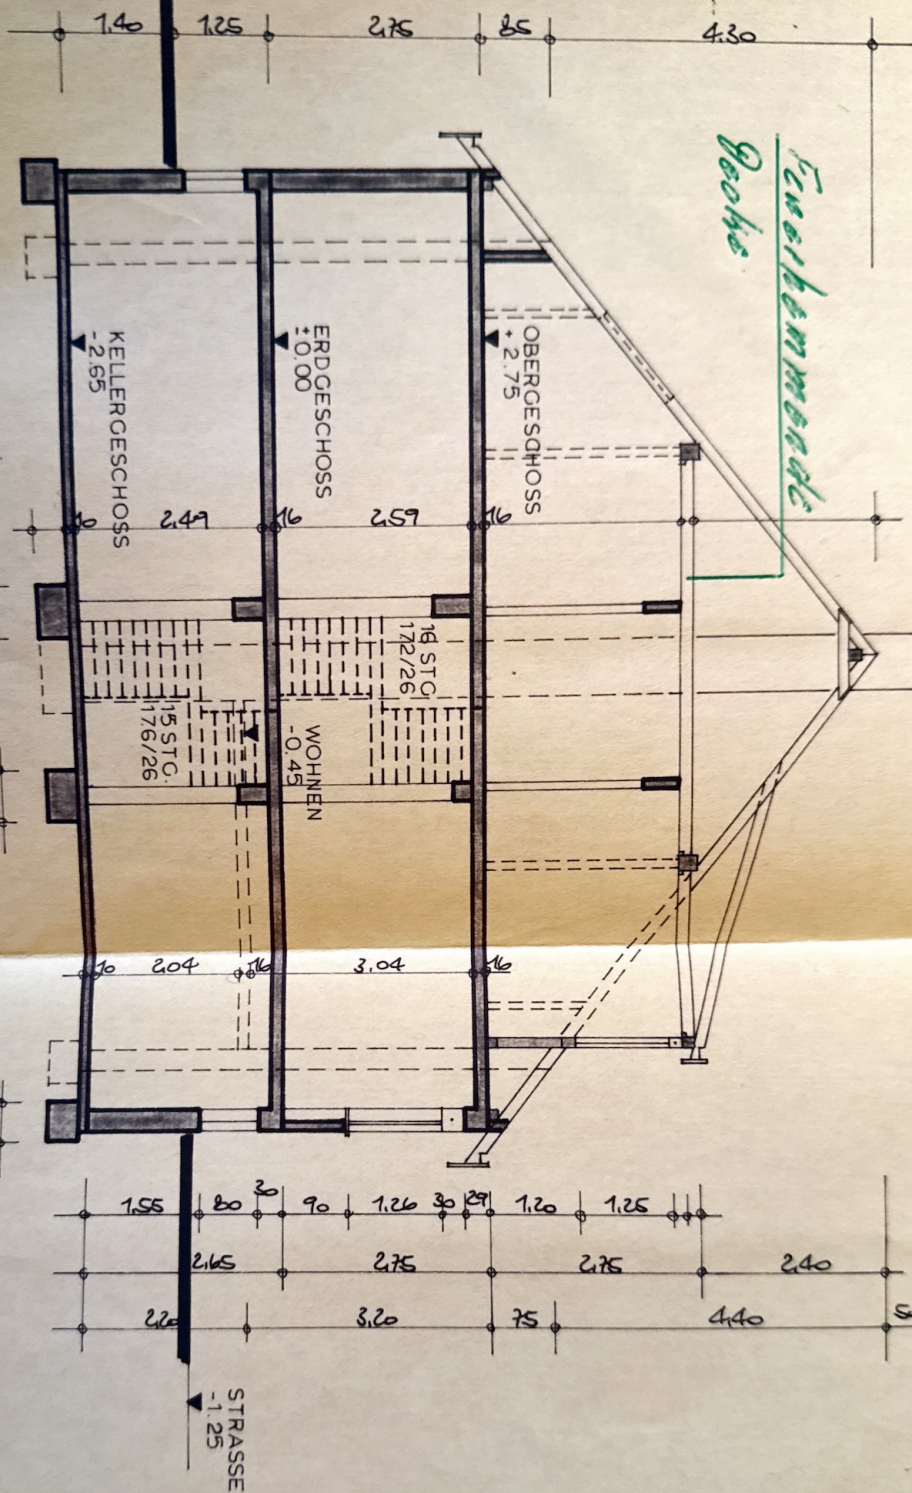

SCHNITT A-A

FUNDAMENTE NACH STAT. BERECHNUNG

