


G82E1  
 G82E2  
 G82E1

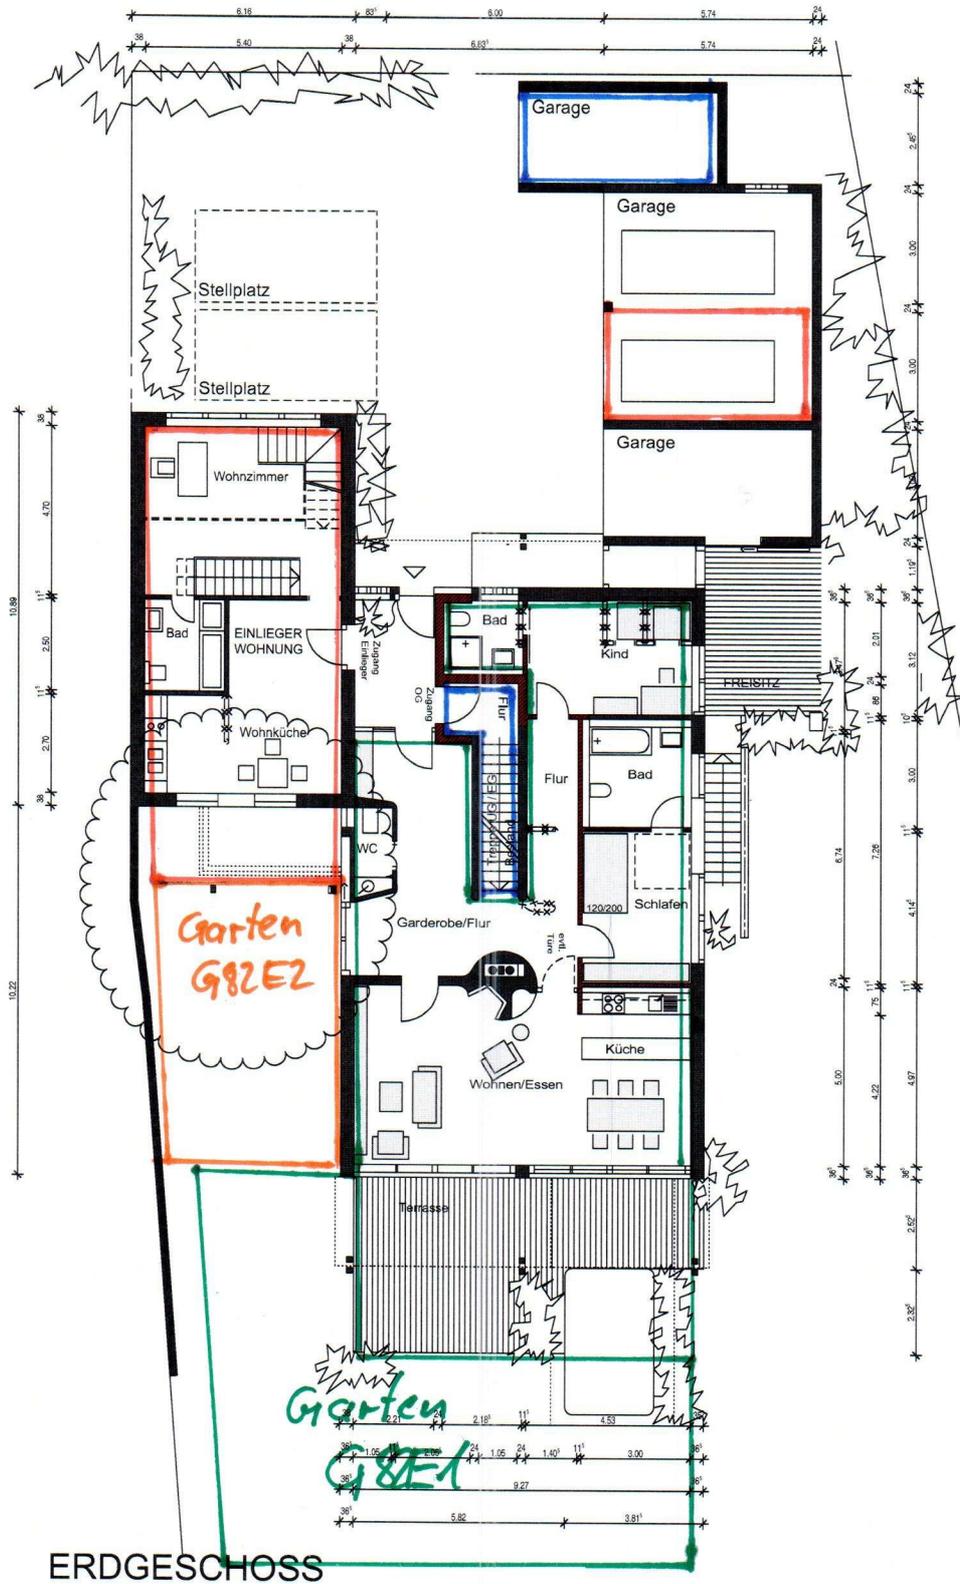

ERDGESCHOSS



