


EINFAMILIEN-DOPPELHAUS mit GARAGE, Meerbusch

Wohnfläche nach DIN 283

1. Wohnraum	=	22,33	qm	12. Diele	=	6,22	qm
2. EBdiele	=	13,36	"	13. Loggia EG.	=	2,30	"
3. Treppenpodest	=	1,23	"	14. Balkon 1. OG.	=	2,16	"
4. Küche	=	8,12	"	Wohnfl.n.DIN 283 :	=	104,04	qm
5. WC	=	1,73	"		=	13,84	qm
6. Entree u. Gard.	=	3,94	"	15. Giebelstube	=	3,73	"
7. Eltern	=	13,95	"	16. Schrankdiele	=	1,12	"
8. Kind 2	=	11,10	"	17. Abstellraum	=	18,69	qm
9. Kind 1	=	8,00	"	Nutzfläche :	=	122,73	qm
10. Bad	=	7,59	"	Gesamtfläche :	=	22,46	qm
11. WC	=	2,10	"	18. Werkraum KG.			

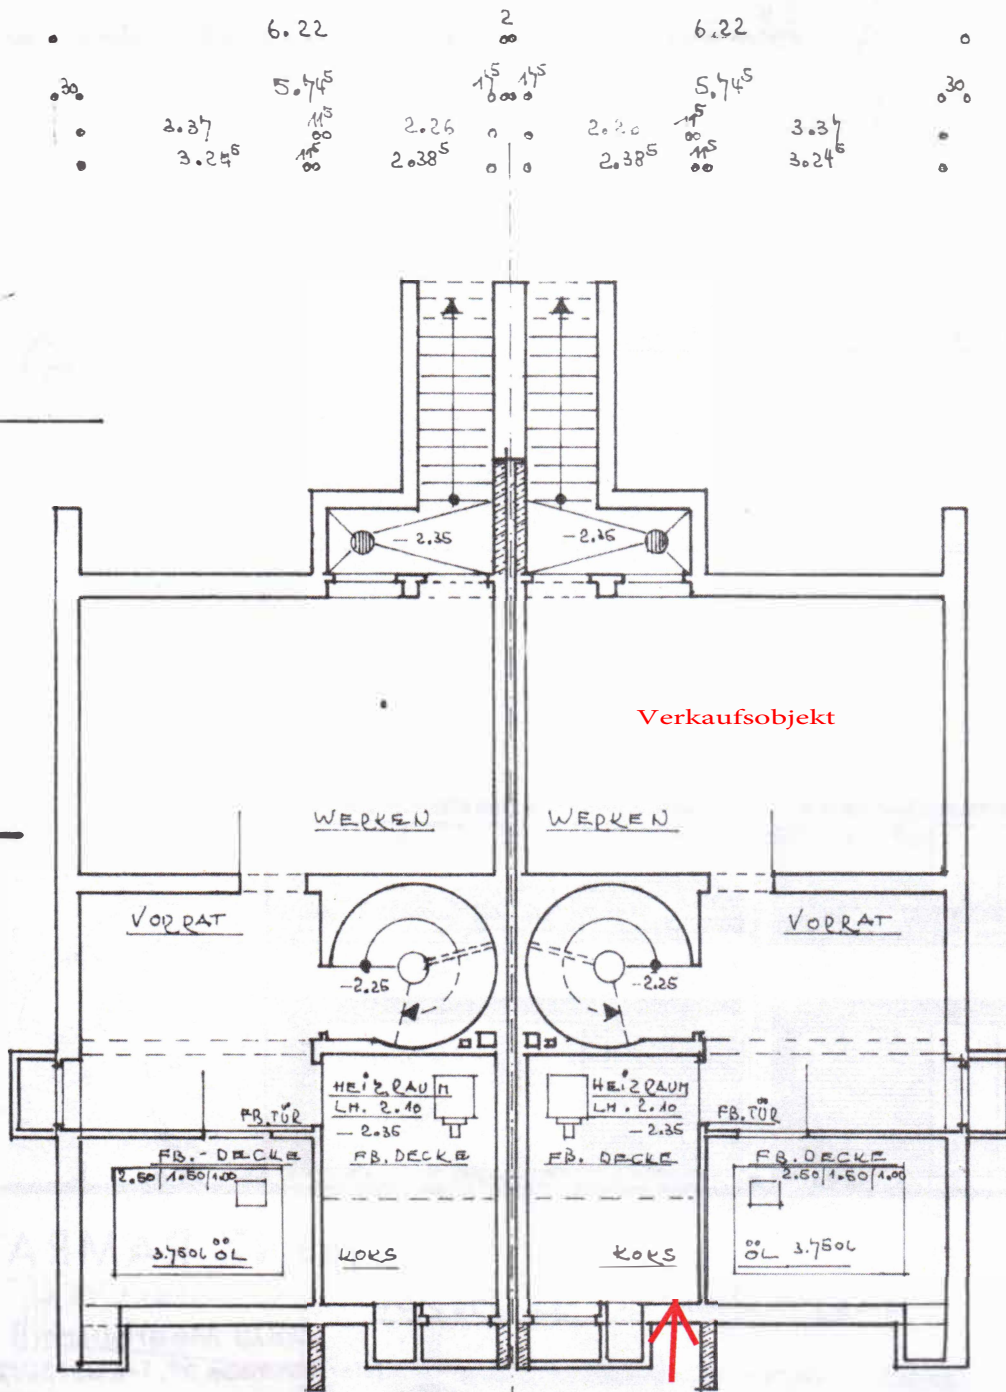

1

3.00 8.85
3.91
2.26 2.01 2.4
3.35 10.53
3.53 2.28
3.00 5.00
KELLERGESCH.

9.28

6024

5.72⁵

3.455

3.22

2.10

2.26
2.38⁵

2.38

6.24

5.72⁵

2.456

3.2
10

2.4

3.00.

2.77

2:

44

2

Verkaufsobjekt







WC

EDD GESCHOS

DACH GESCHOSS

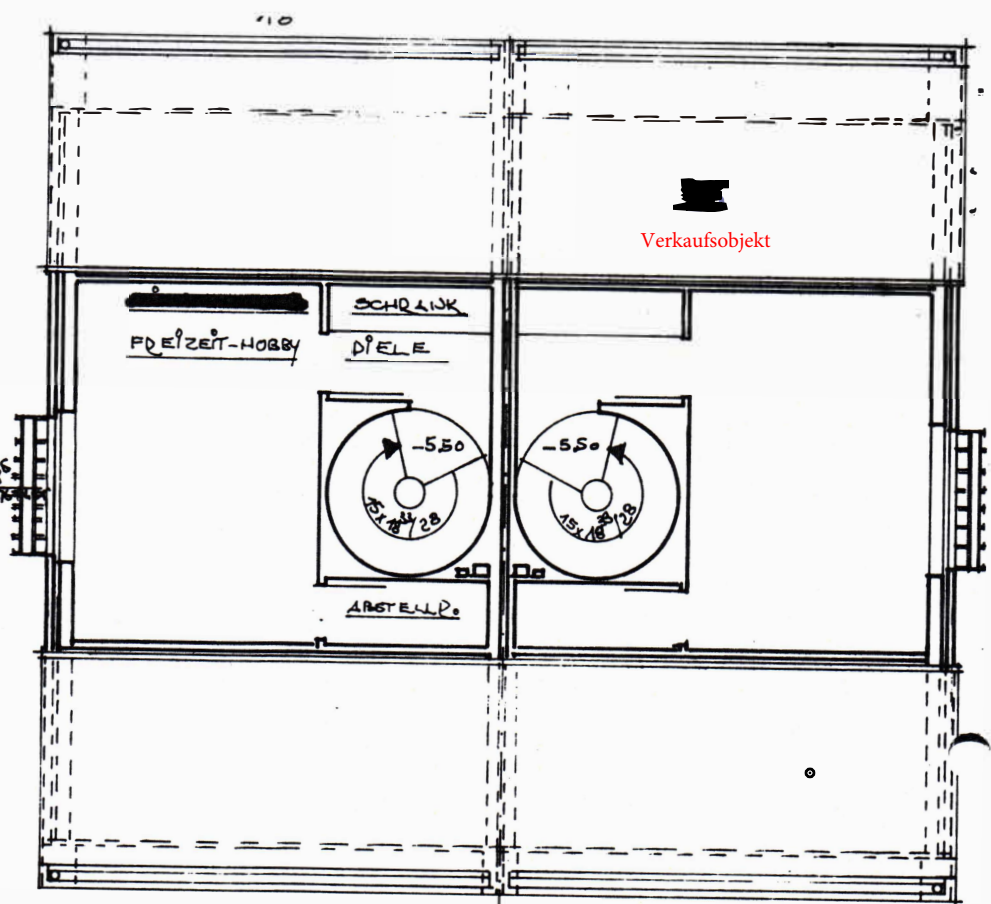


Verkaufsobjekt




Verkaufsobjekt

1. OBERGESCHOSS

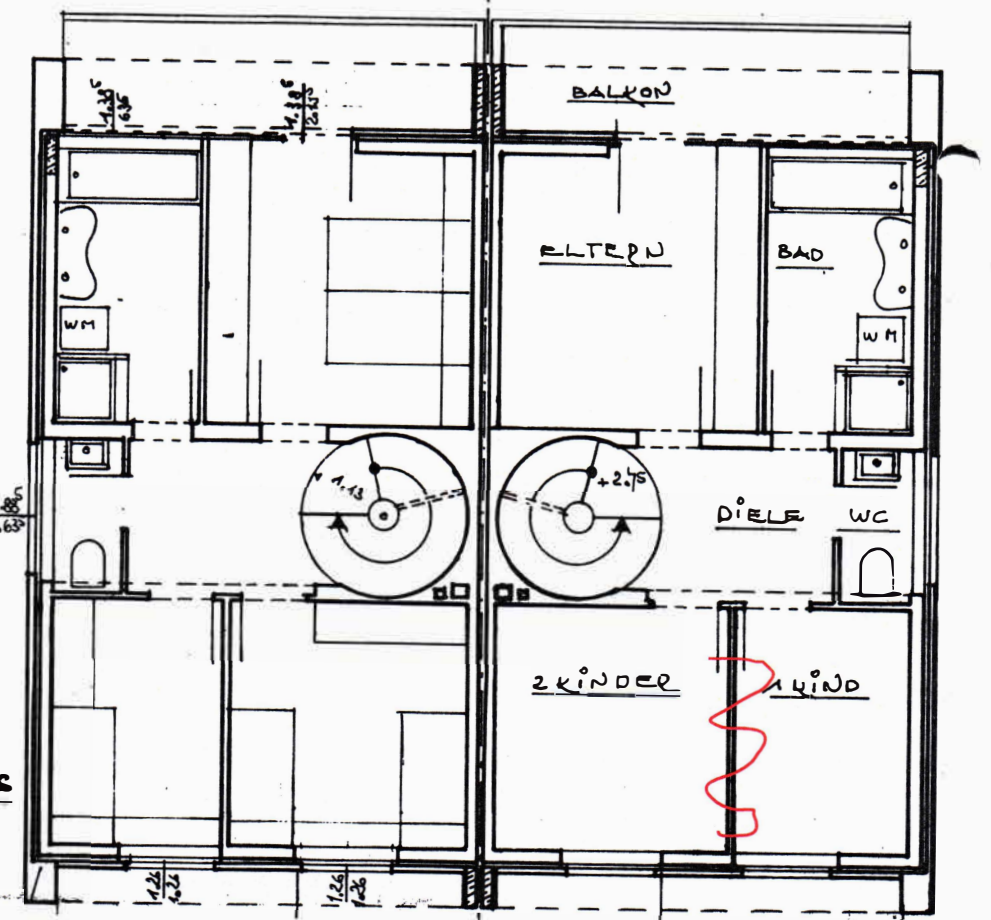

3

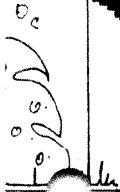



GARTENANSICHT 1:100