


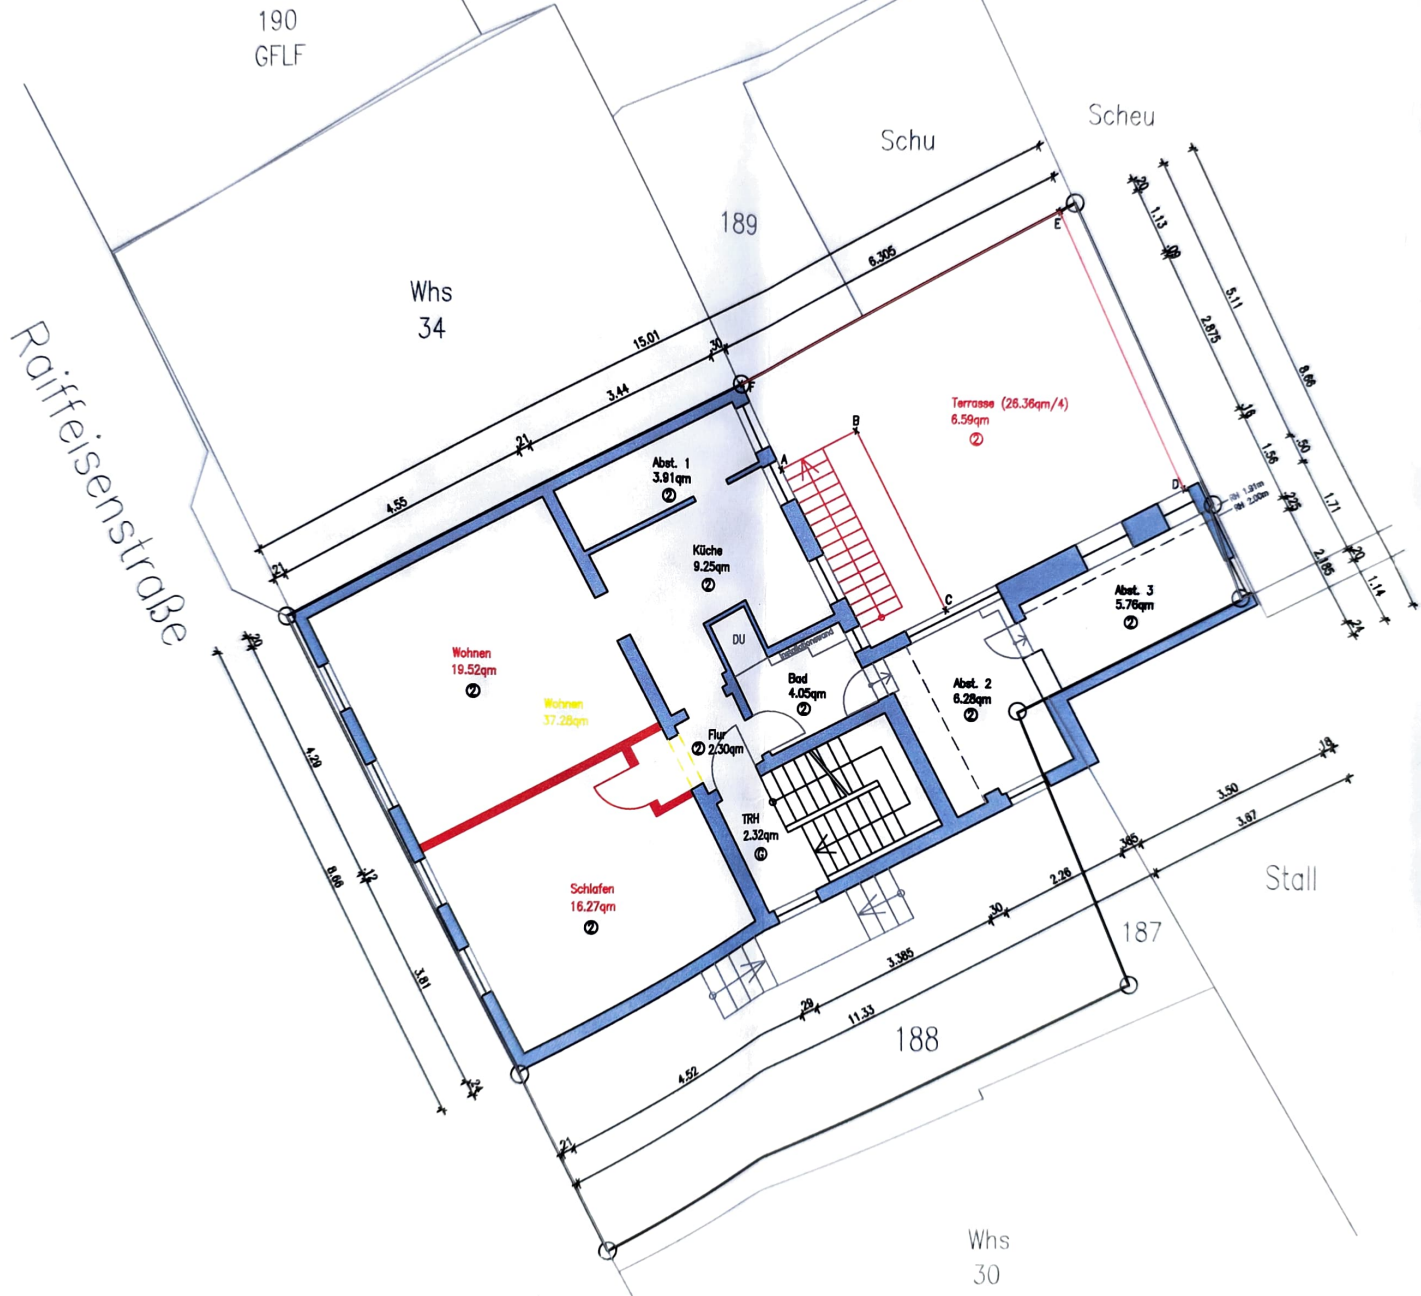

Baug  
2  
La