


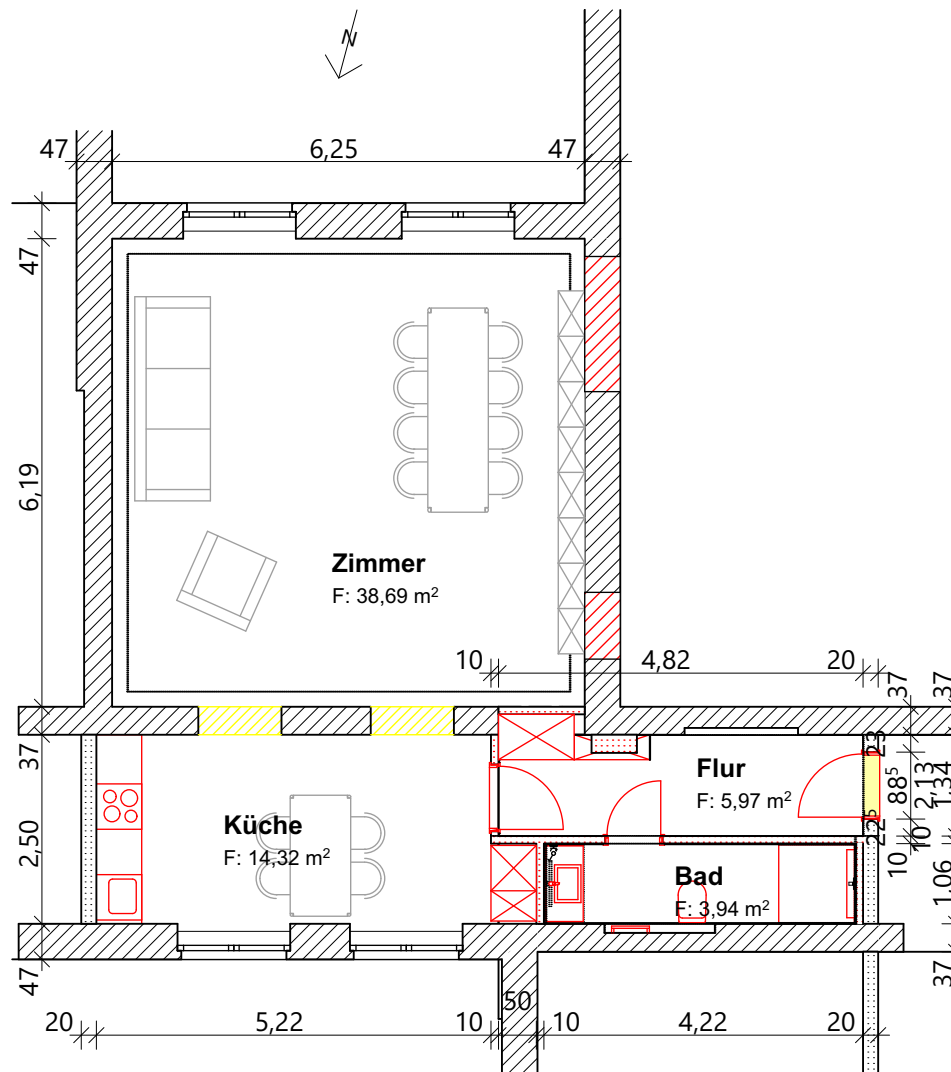

Grundriss
Holstenstr. EG
Broszkiewicz / Bohn
M: 1:100

Legende:
Bestand
Neubau
Abbruch