


22,55

$$16 + 4 + 4 = 24 \text{ m}^2$$

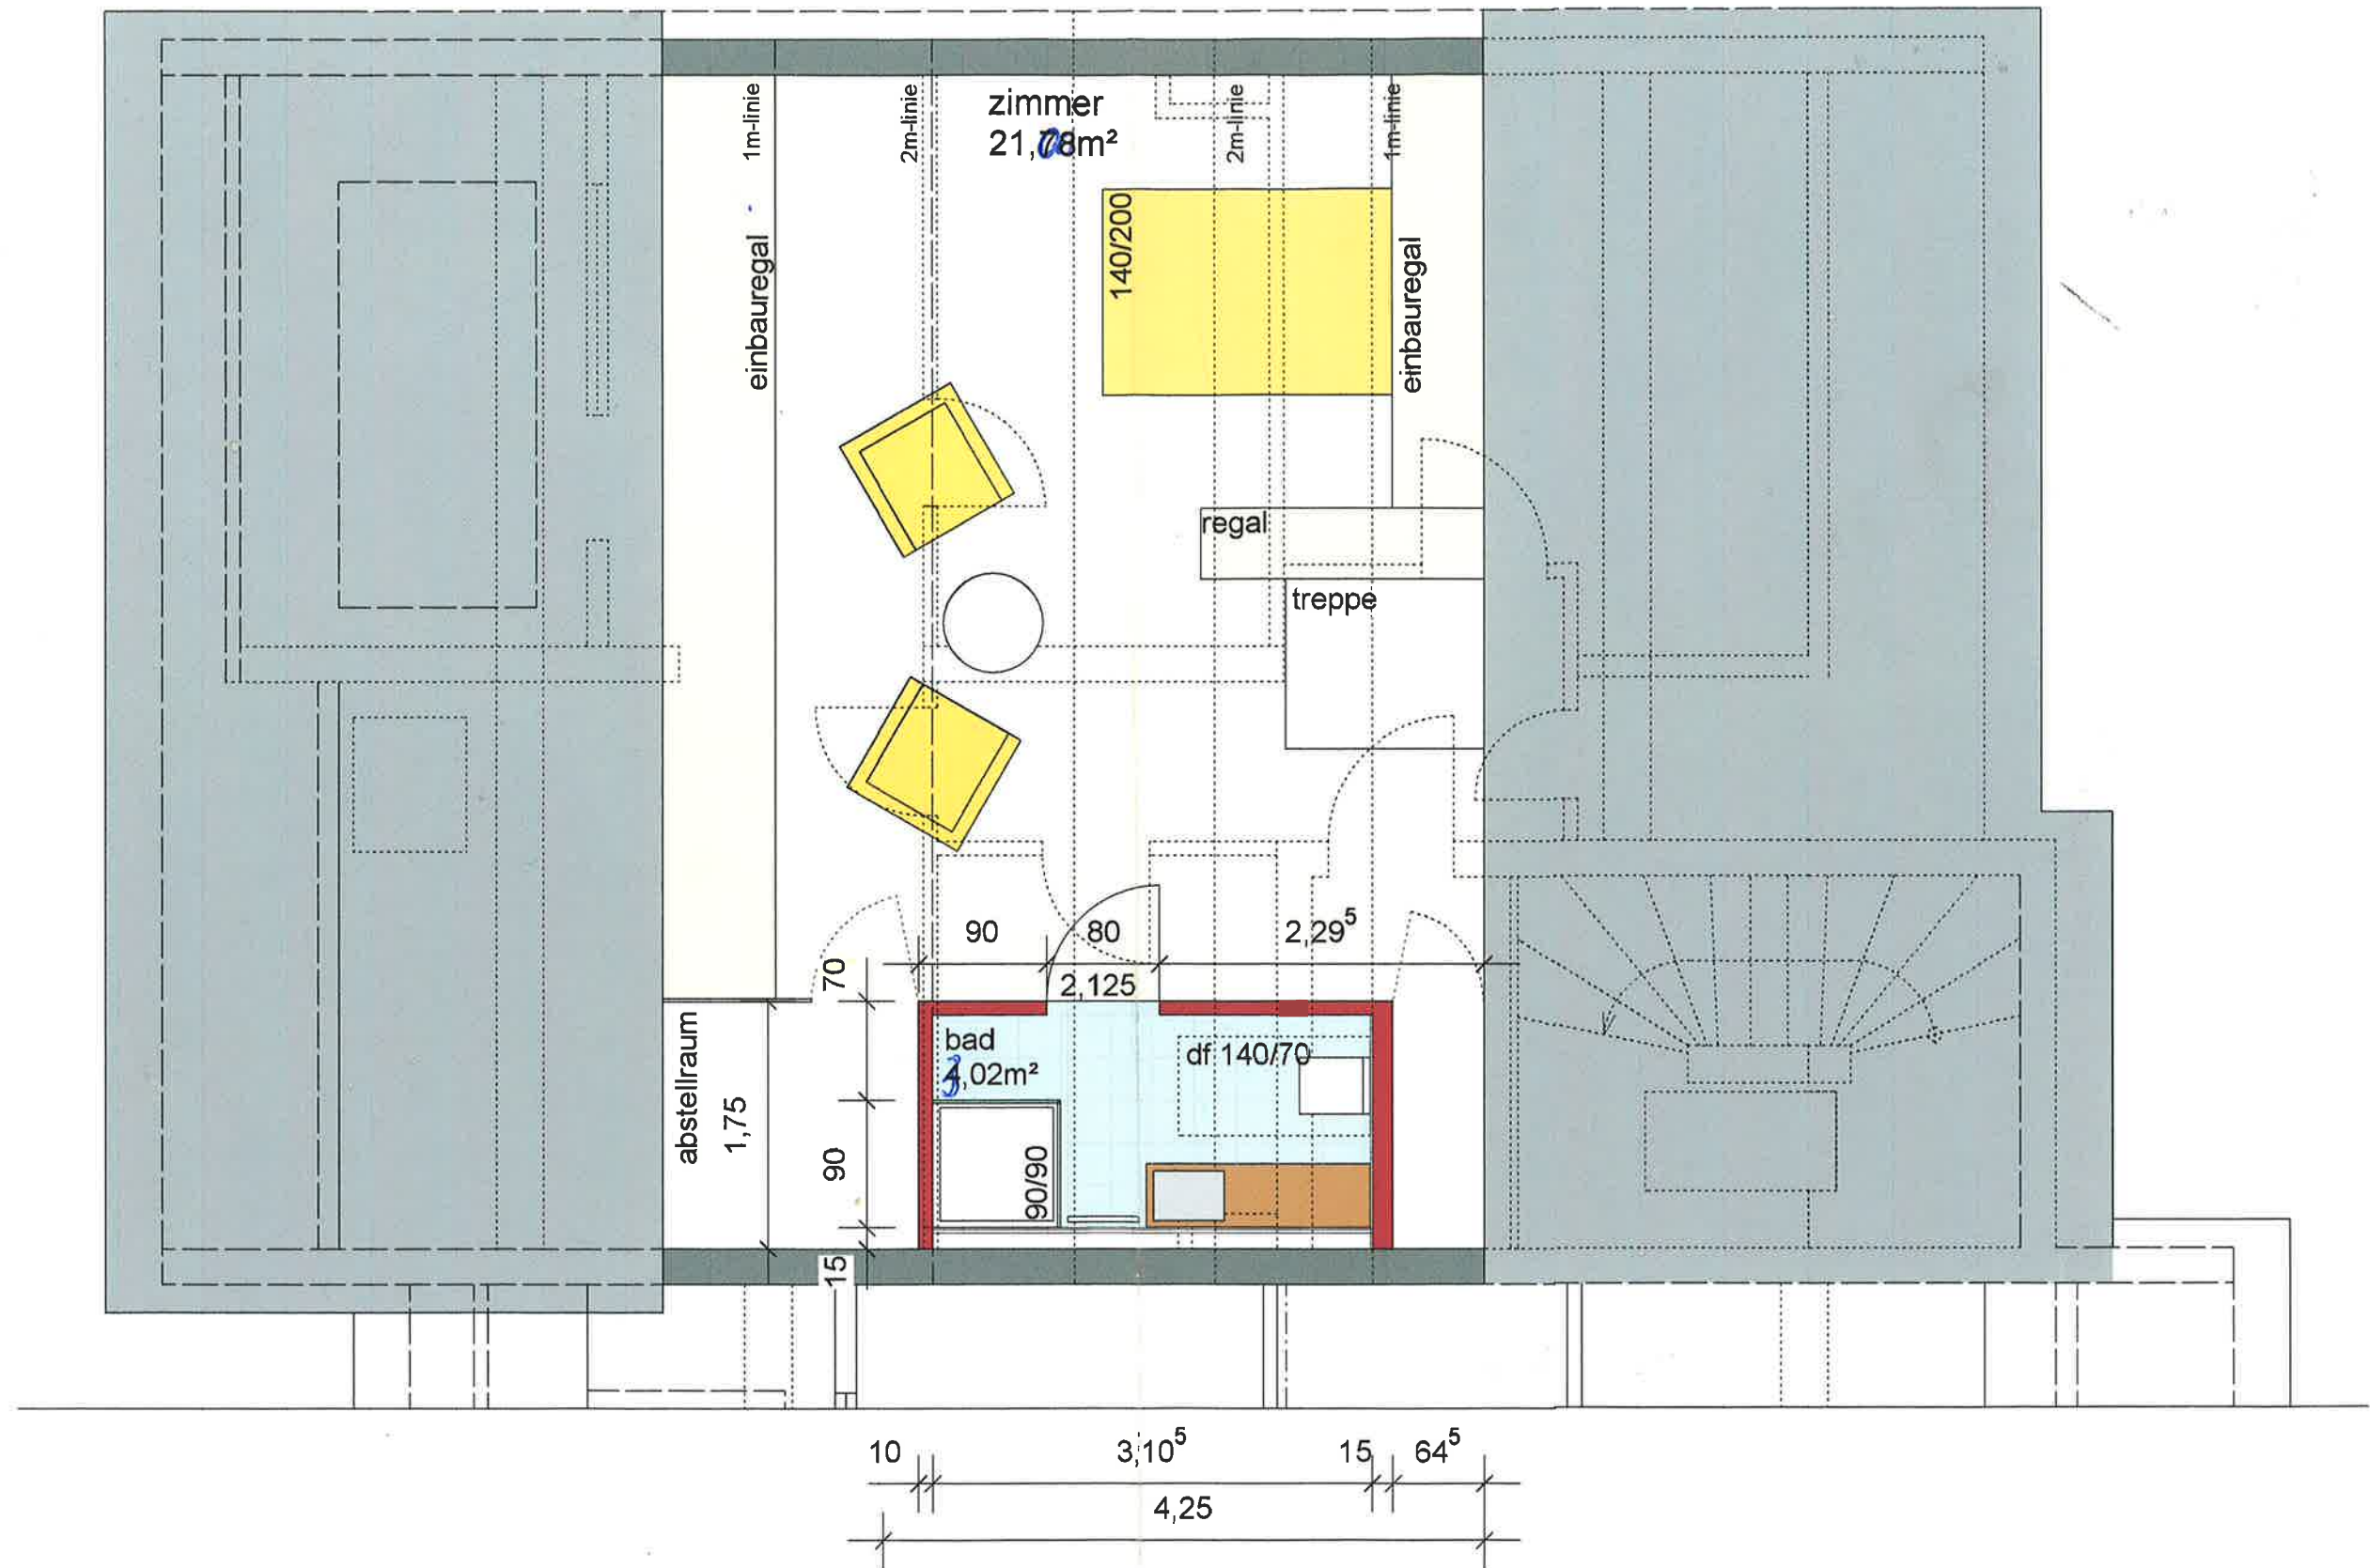

dachgeschoss

bauherr:

architekt: