


ansicht w e s t e n

NEU

3.01		7.99			2		8.74		
1.99	4.01	1.99	1.115	2.01	2.49	2.01			
385	380	175	3,475	175	175	3,825	175	4,39	1,385

13,49	151	7,99	365
3,99	1,385	6,20	175
2,285	4,00	1,585	115
10	3,40	4,50	120
1,57	115		175

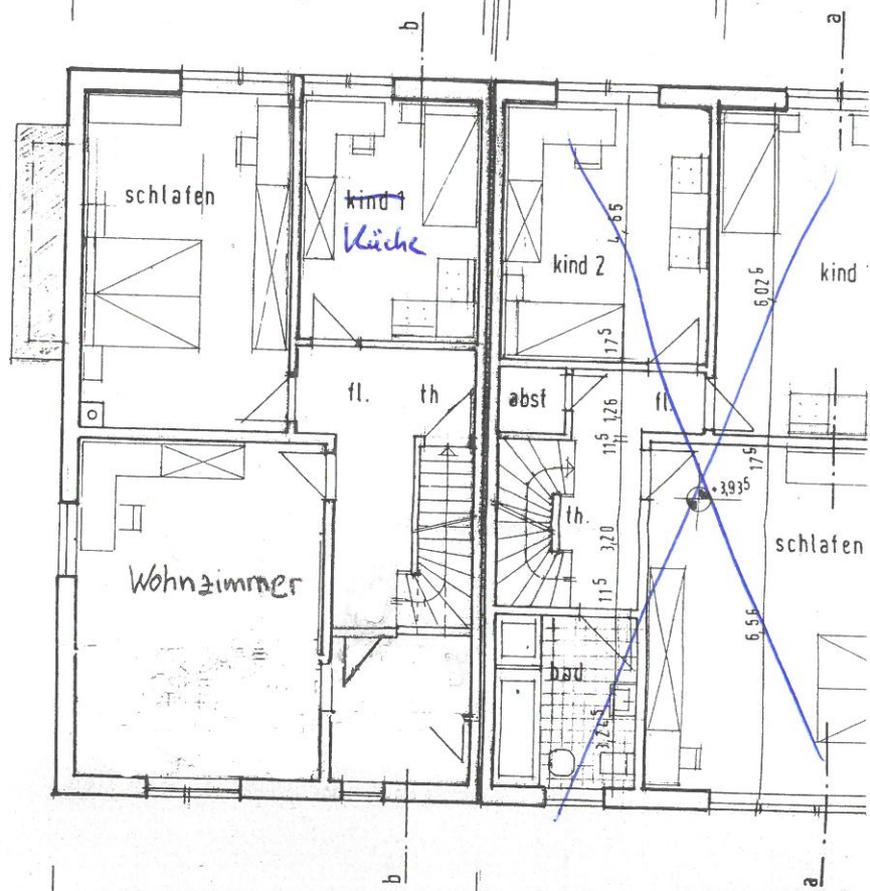

365	4,60	175	2,675	175	2,675	175	5,54	4,39	
1,74	1,76	1,93	1,76	1,80	1,30	1,26	1,68	3,01	
	1,385		1,75		1,385			1,385	
3.01		7.99			2		8.74		

grundriss o bergeschoss

055,18