



12,23


22 6/10

22 6/10

wohnfläche 69,7 m<sup>2</sup>

164



234

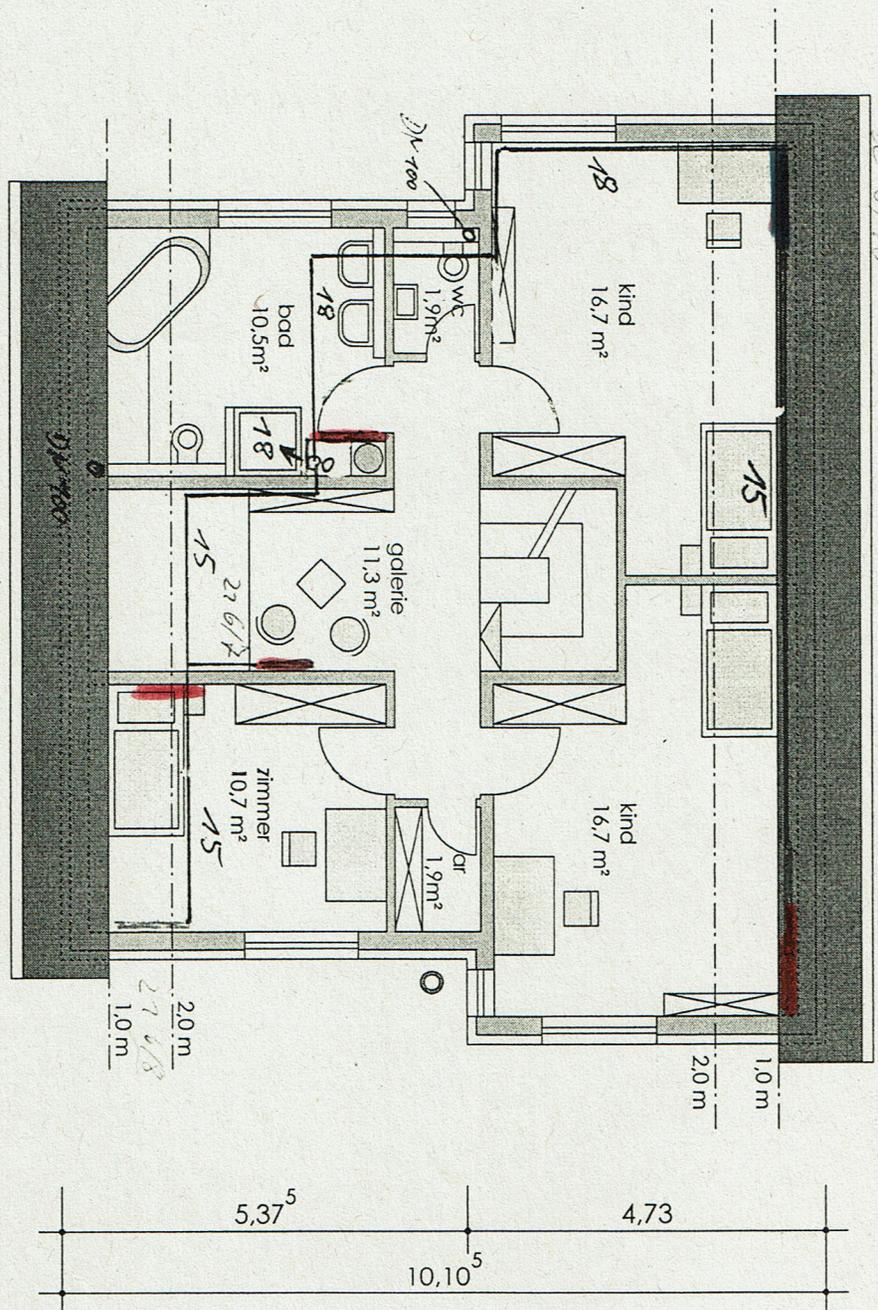

9,98


wohnen in stöckach

wohnfläche 83,9 m<sup>2</sup>

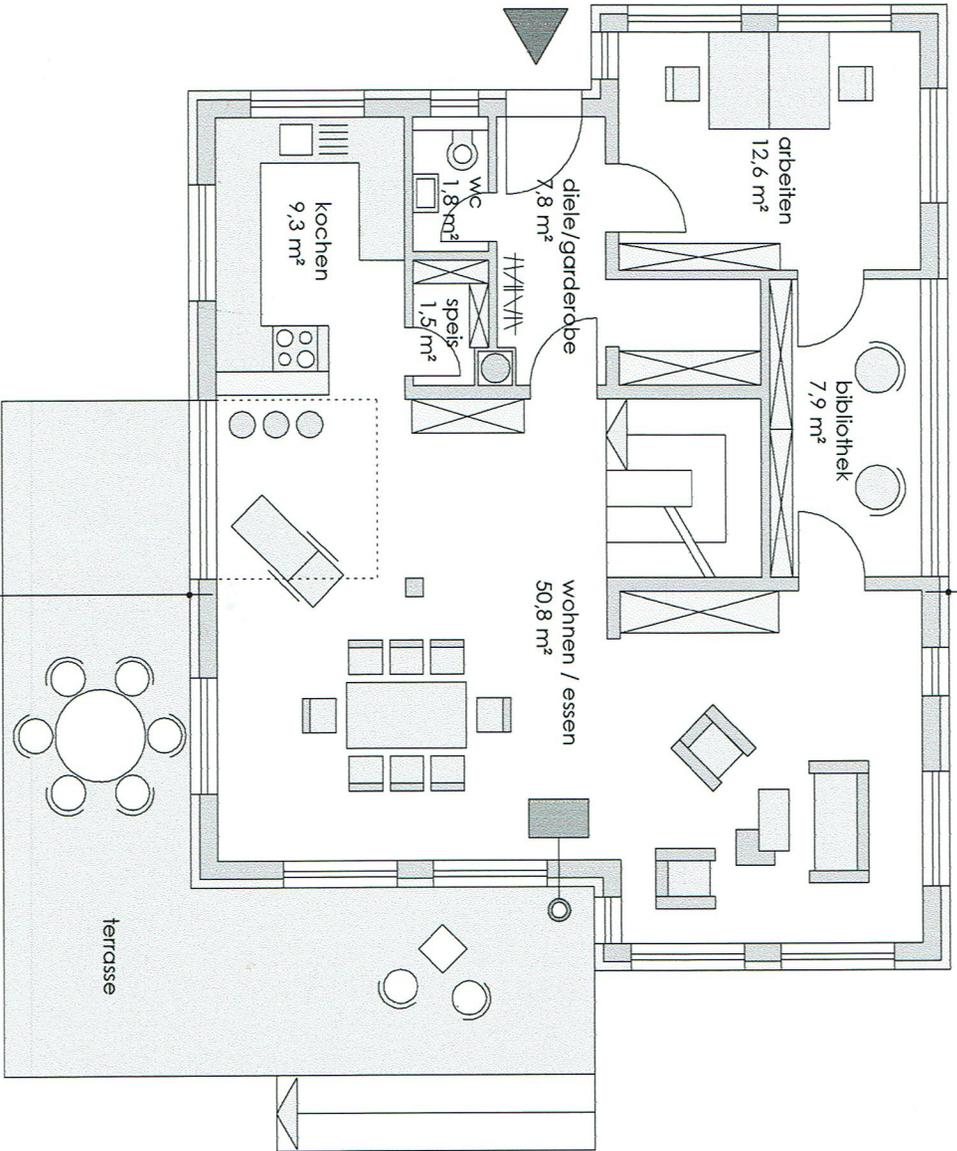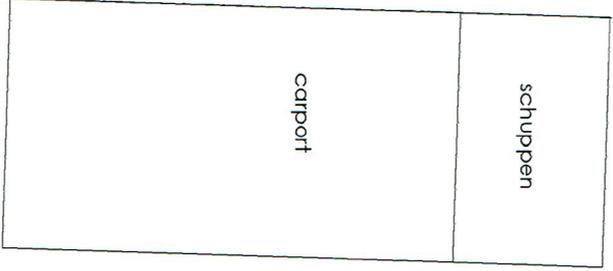

5,00

7,79<sup>3</sup>

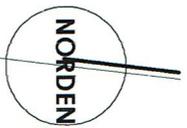

erdgeschoss

wohnfläche 49,2 m<sup>2</sup>  
nutzfläche 37,2 m<sup>2</sup>

