


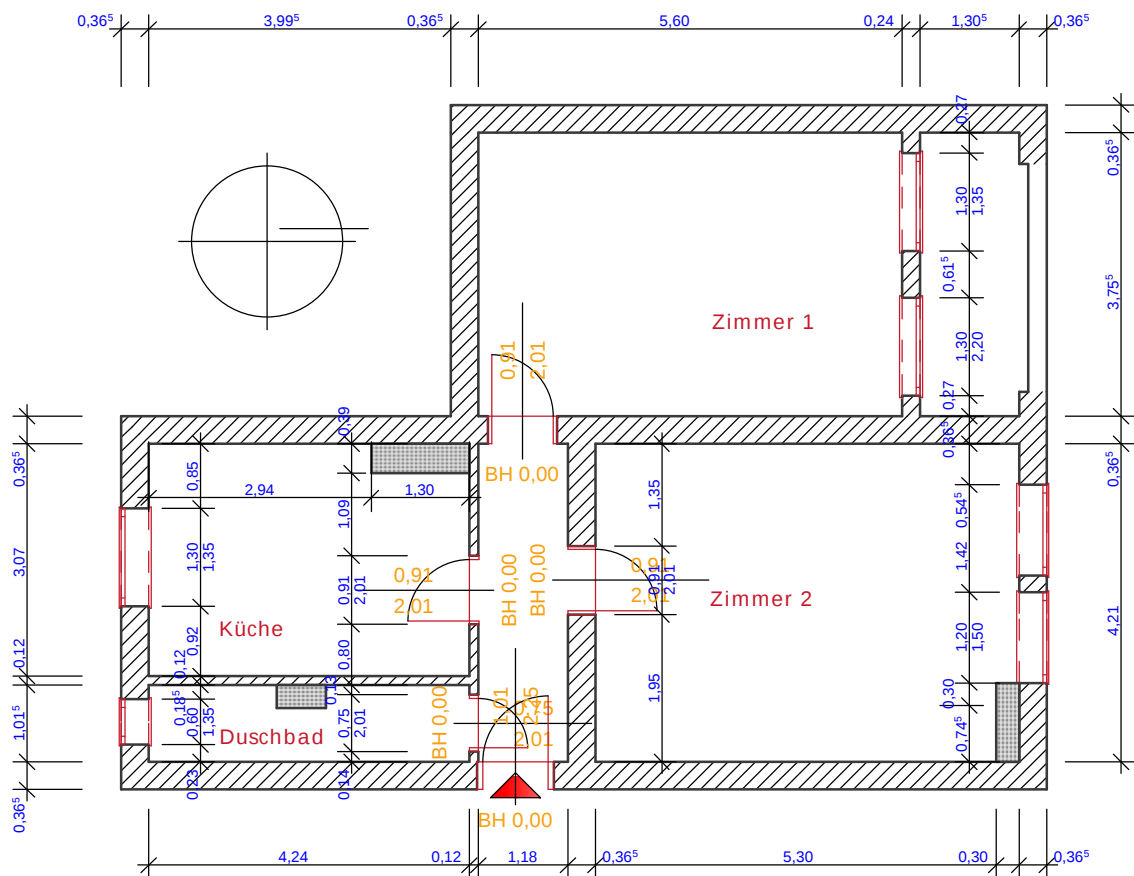

ETW #3
WEG Osloer Str. 101,
13359 Berlin

M=1:100

Aufmaß am 13.07.2015