



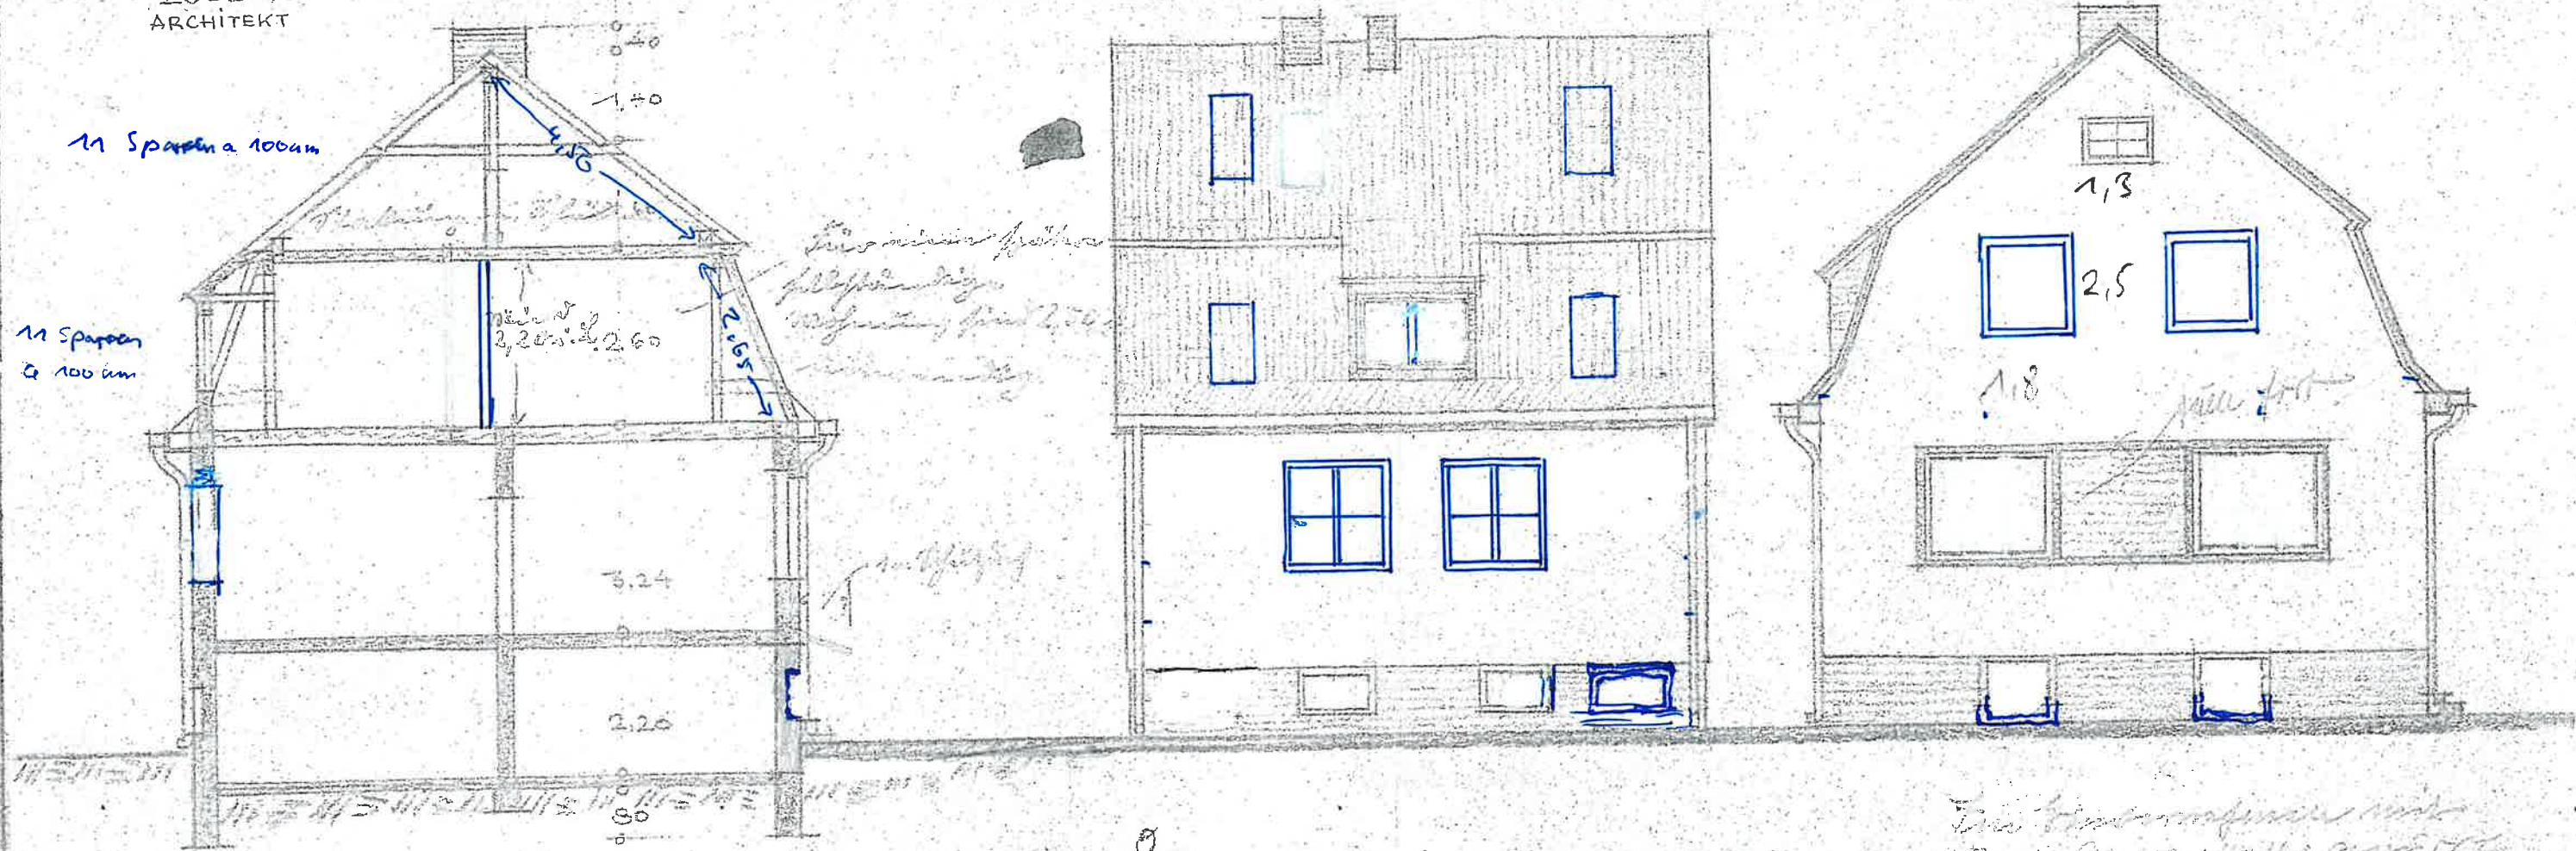


Grund

8,30 x 8,65 = 71,8m² EG = 65,83m² OG = 67,85m²

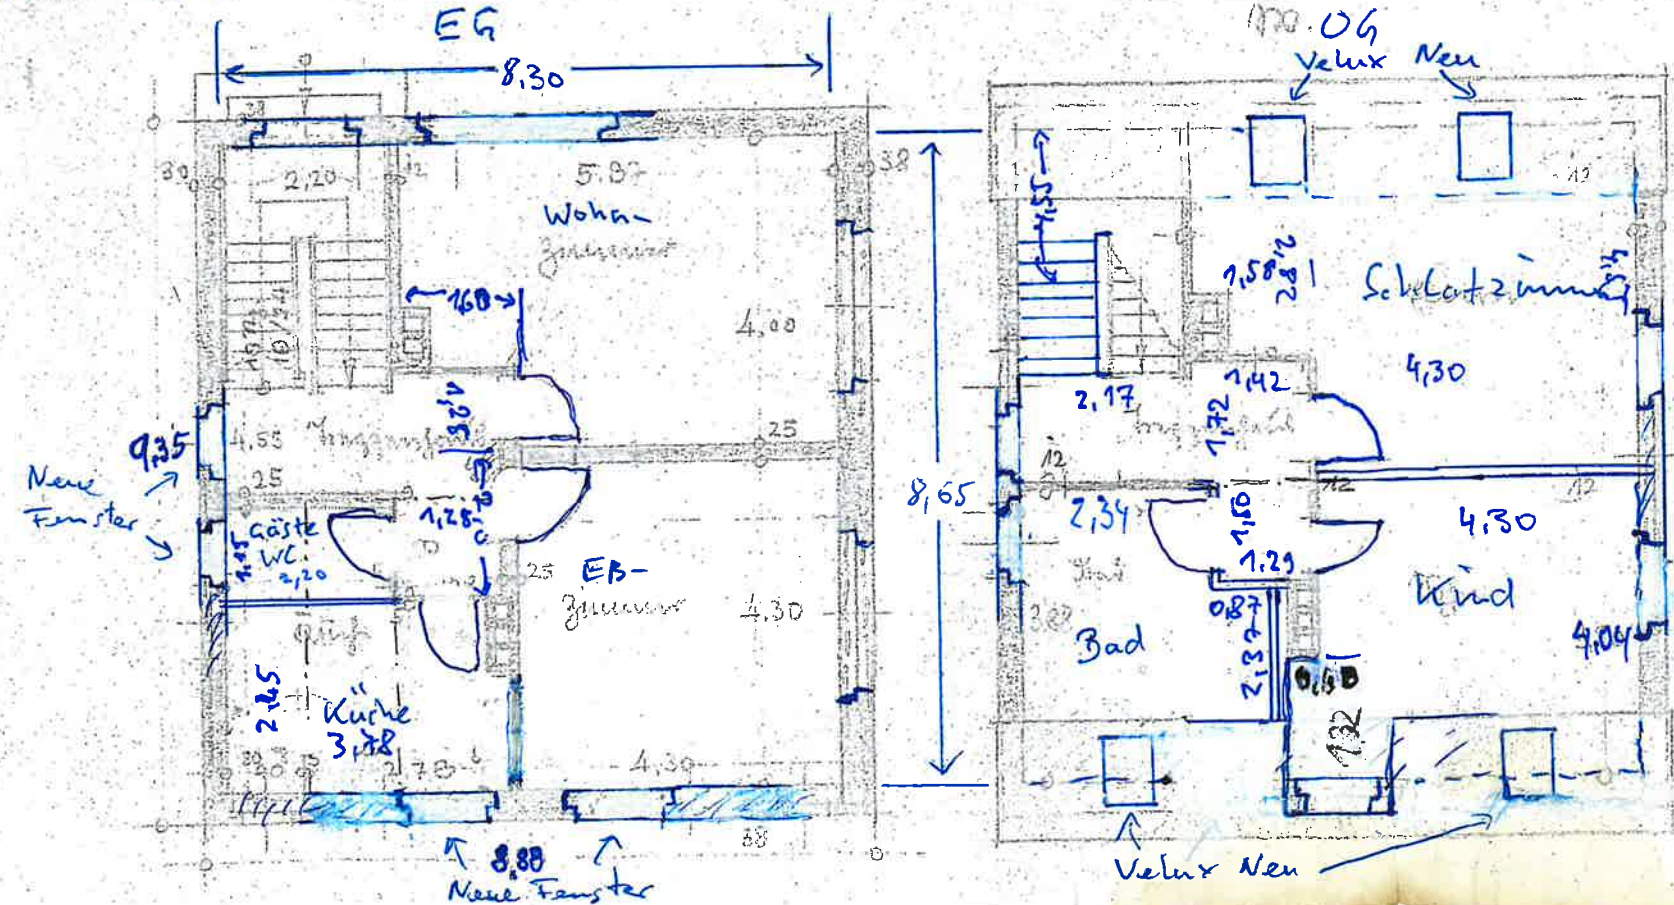

KG = 64,85m² DG = 16,6m²

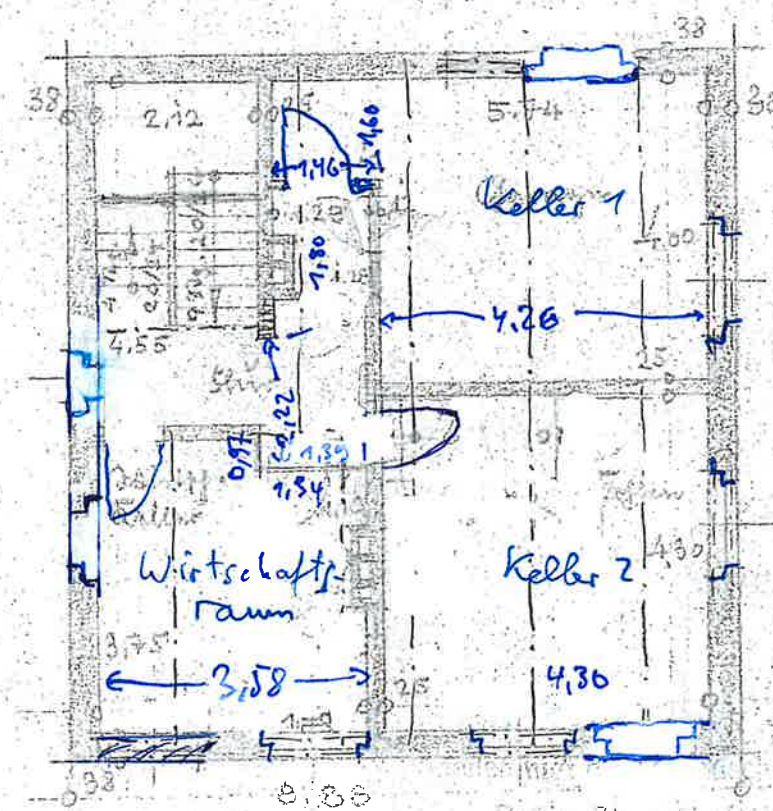

Haus gesamt

DG = 16,6m²
OG = 67,85m²
EG = 65,83m²
KG = 64,85m²

215,13m²