

18,00

10,00

8,00

2,185

1,01

30

1,01

30

1,01

30

2,185

1,365

2,26

1,365


7,40

30

2,00


4,00

2,00

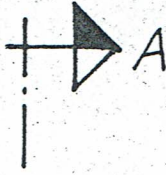

Wohnung W1



BALKON  
Wohnung 3

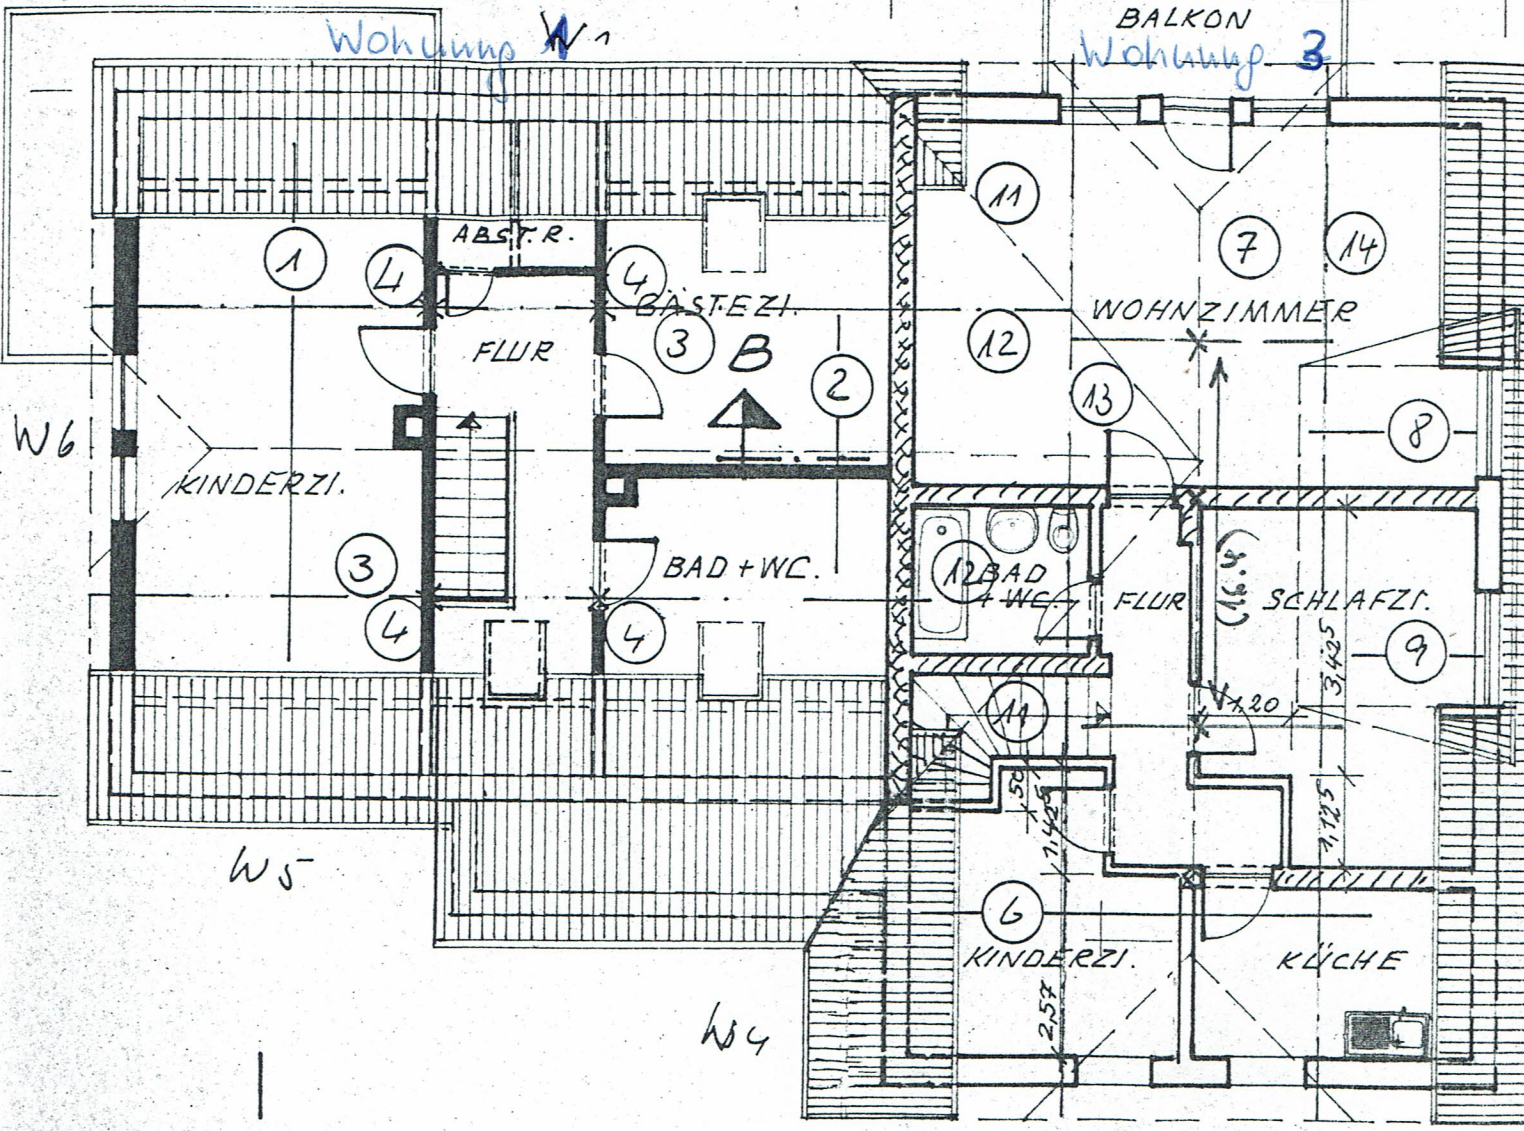

W5

W4

W3

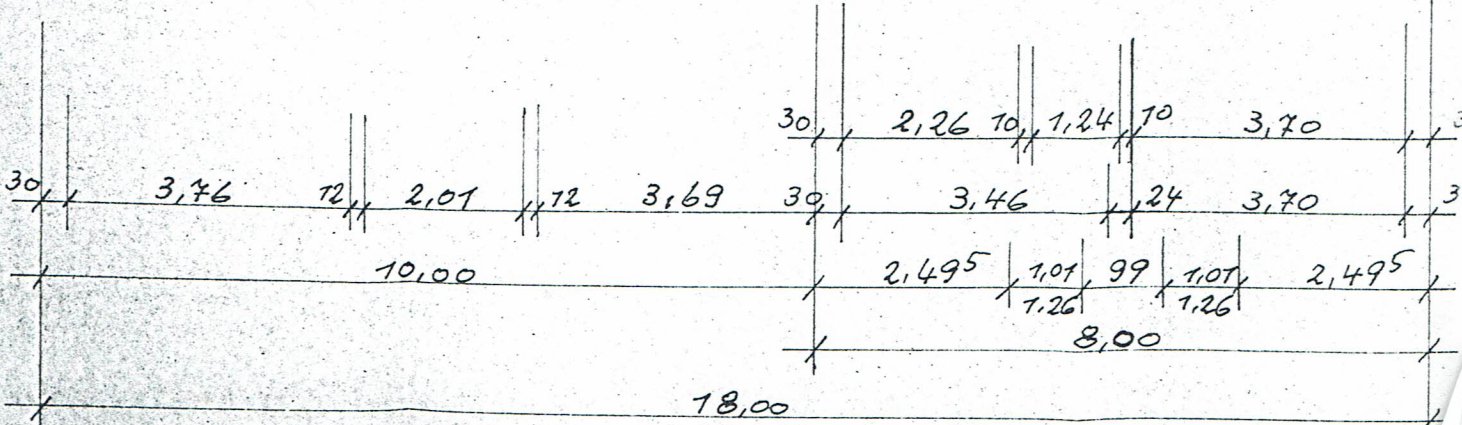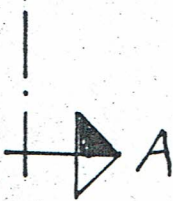

Grundriss Dachgeschoss