



Grundriss Keller

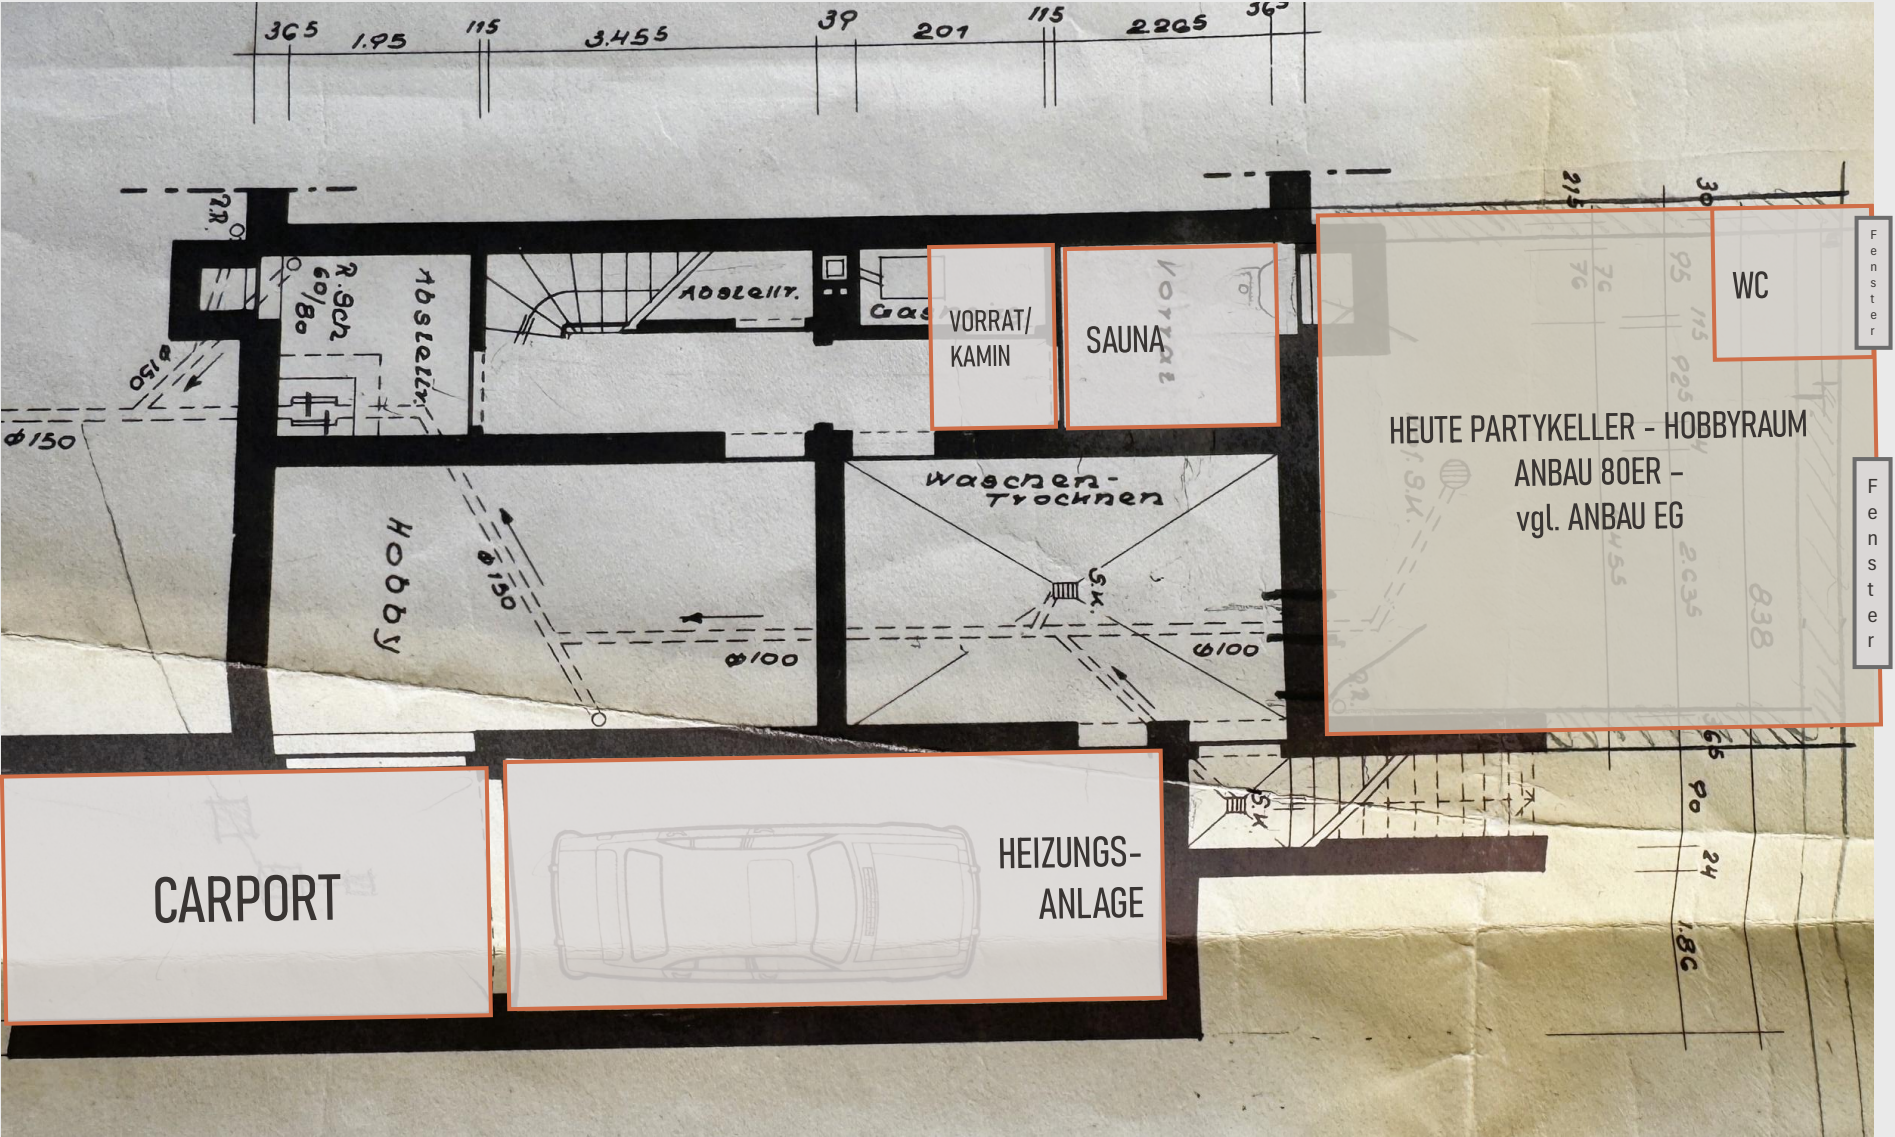

[illegible]

Grundriss 1OG

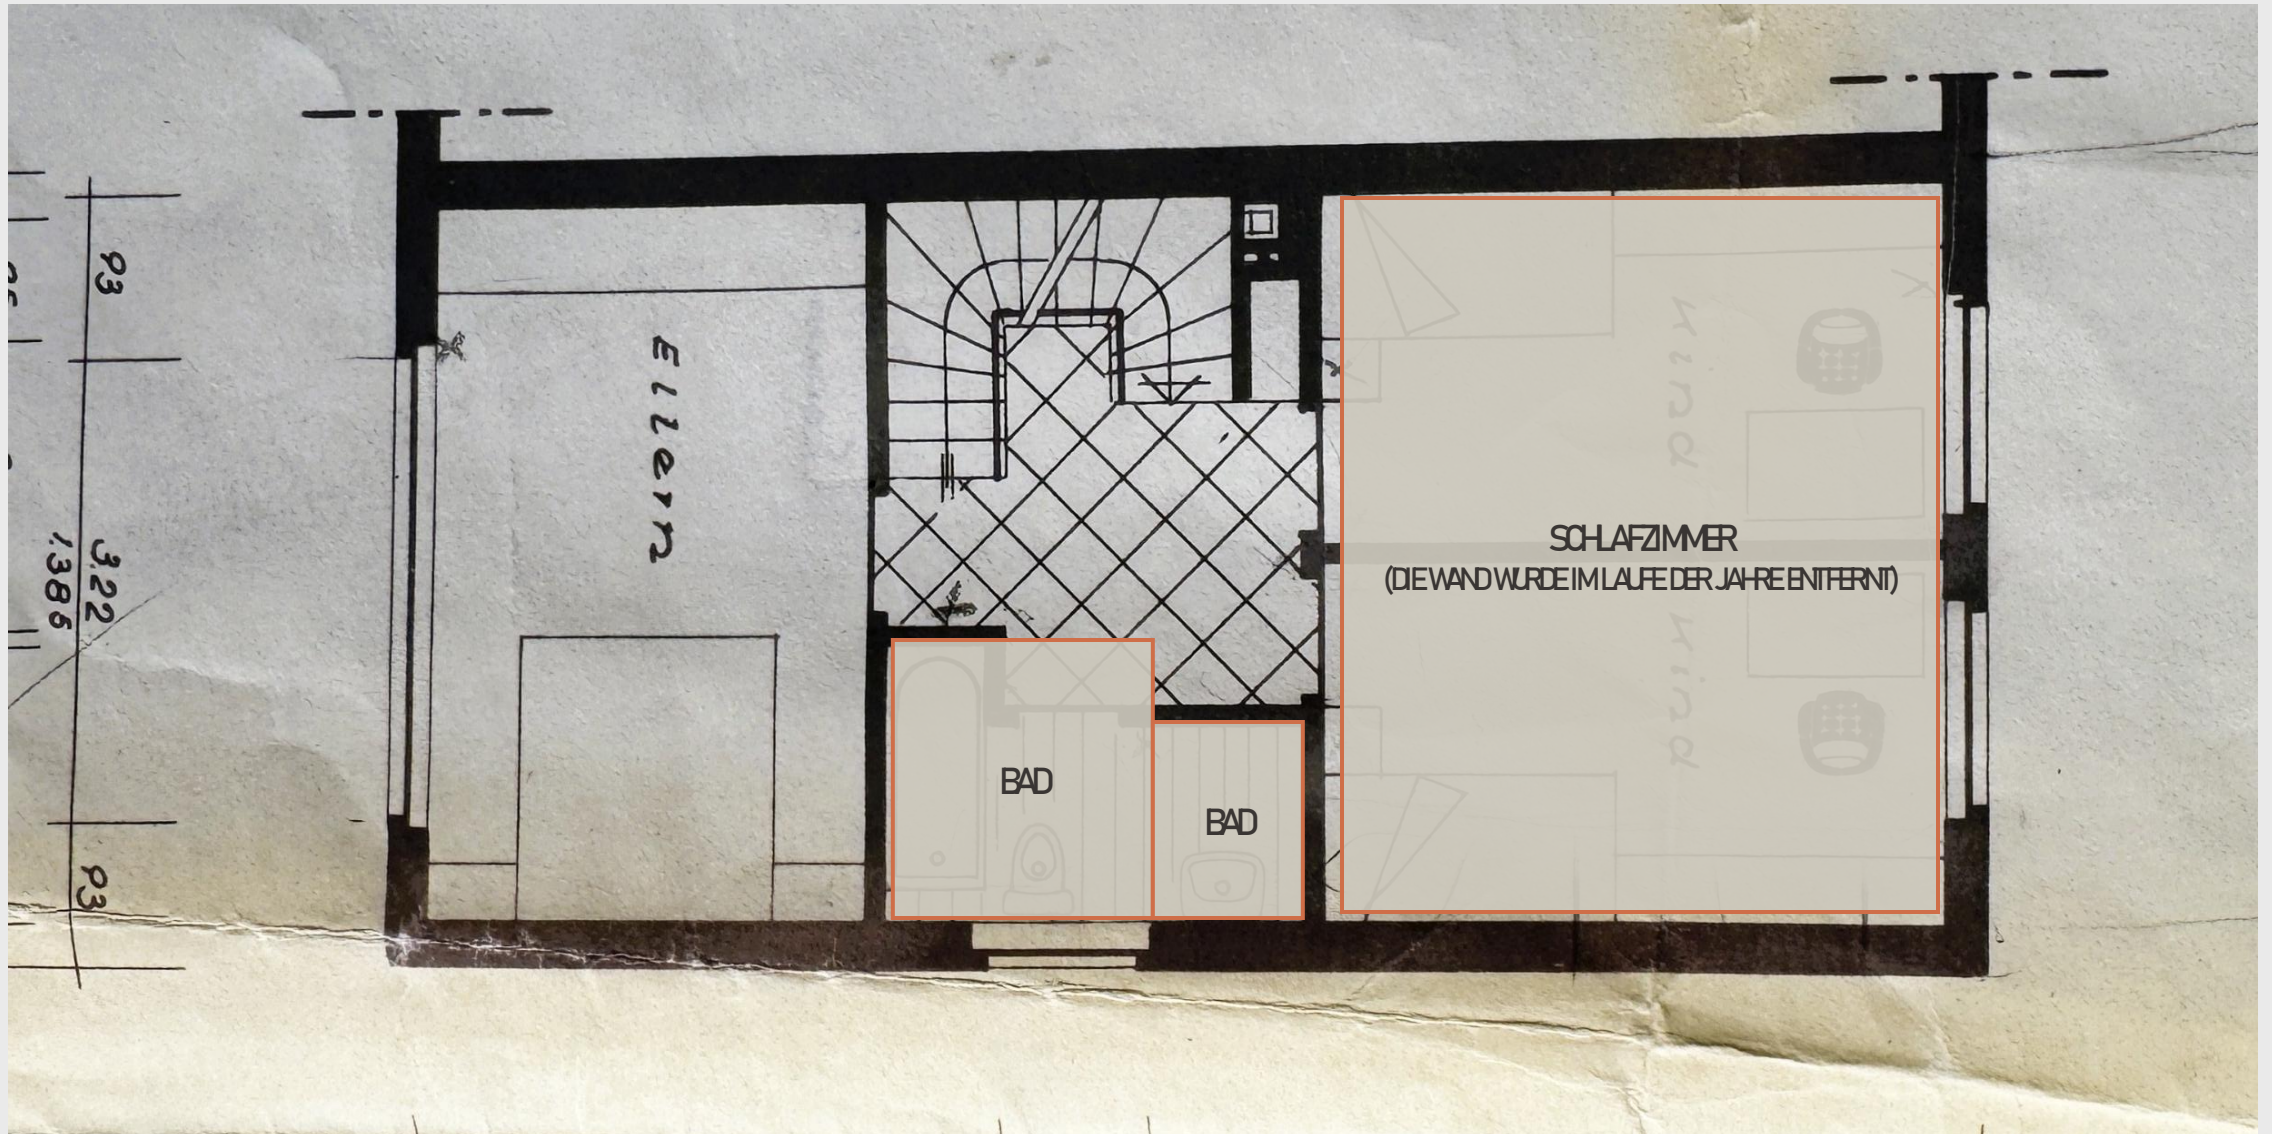

Grundriss DG

