

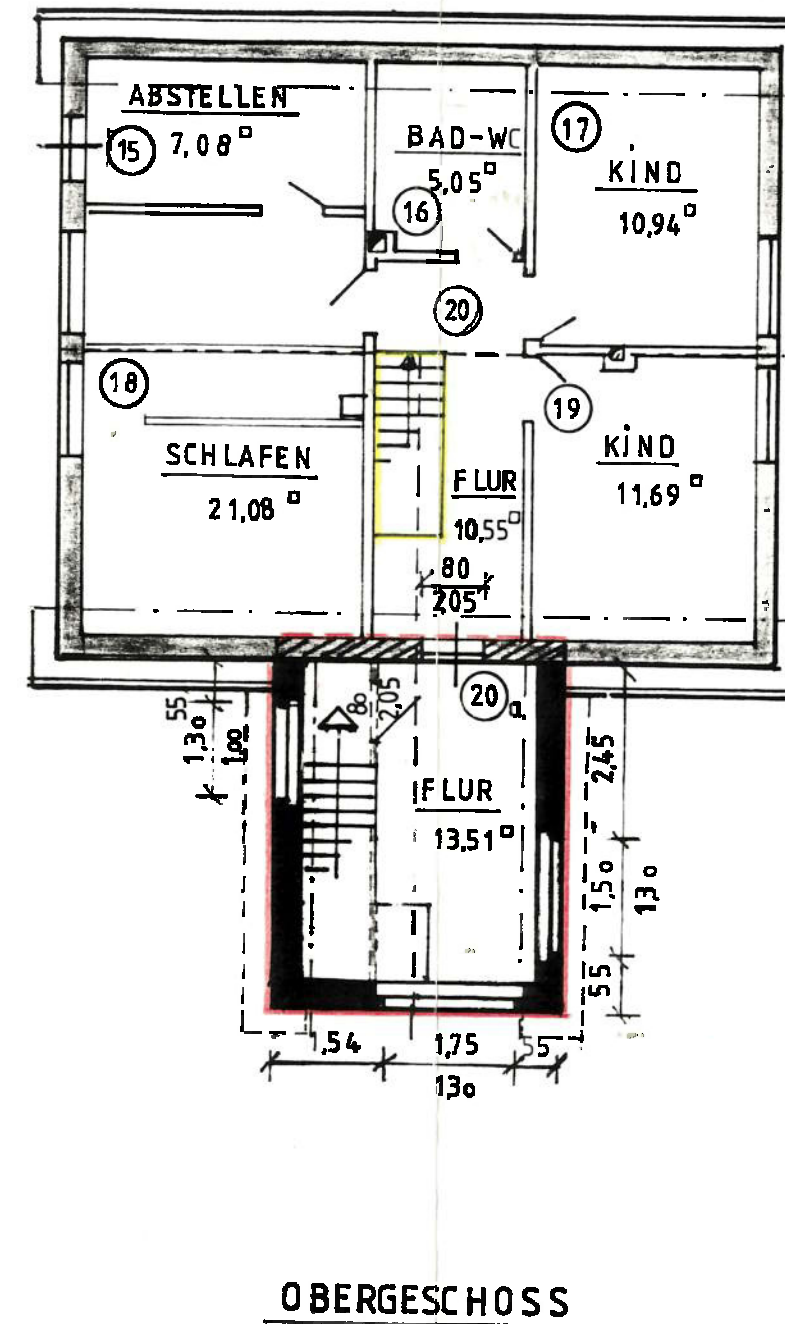


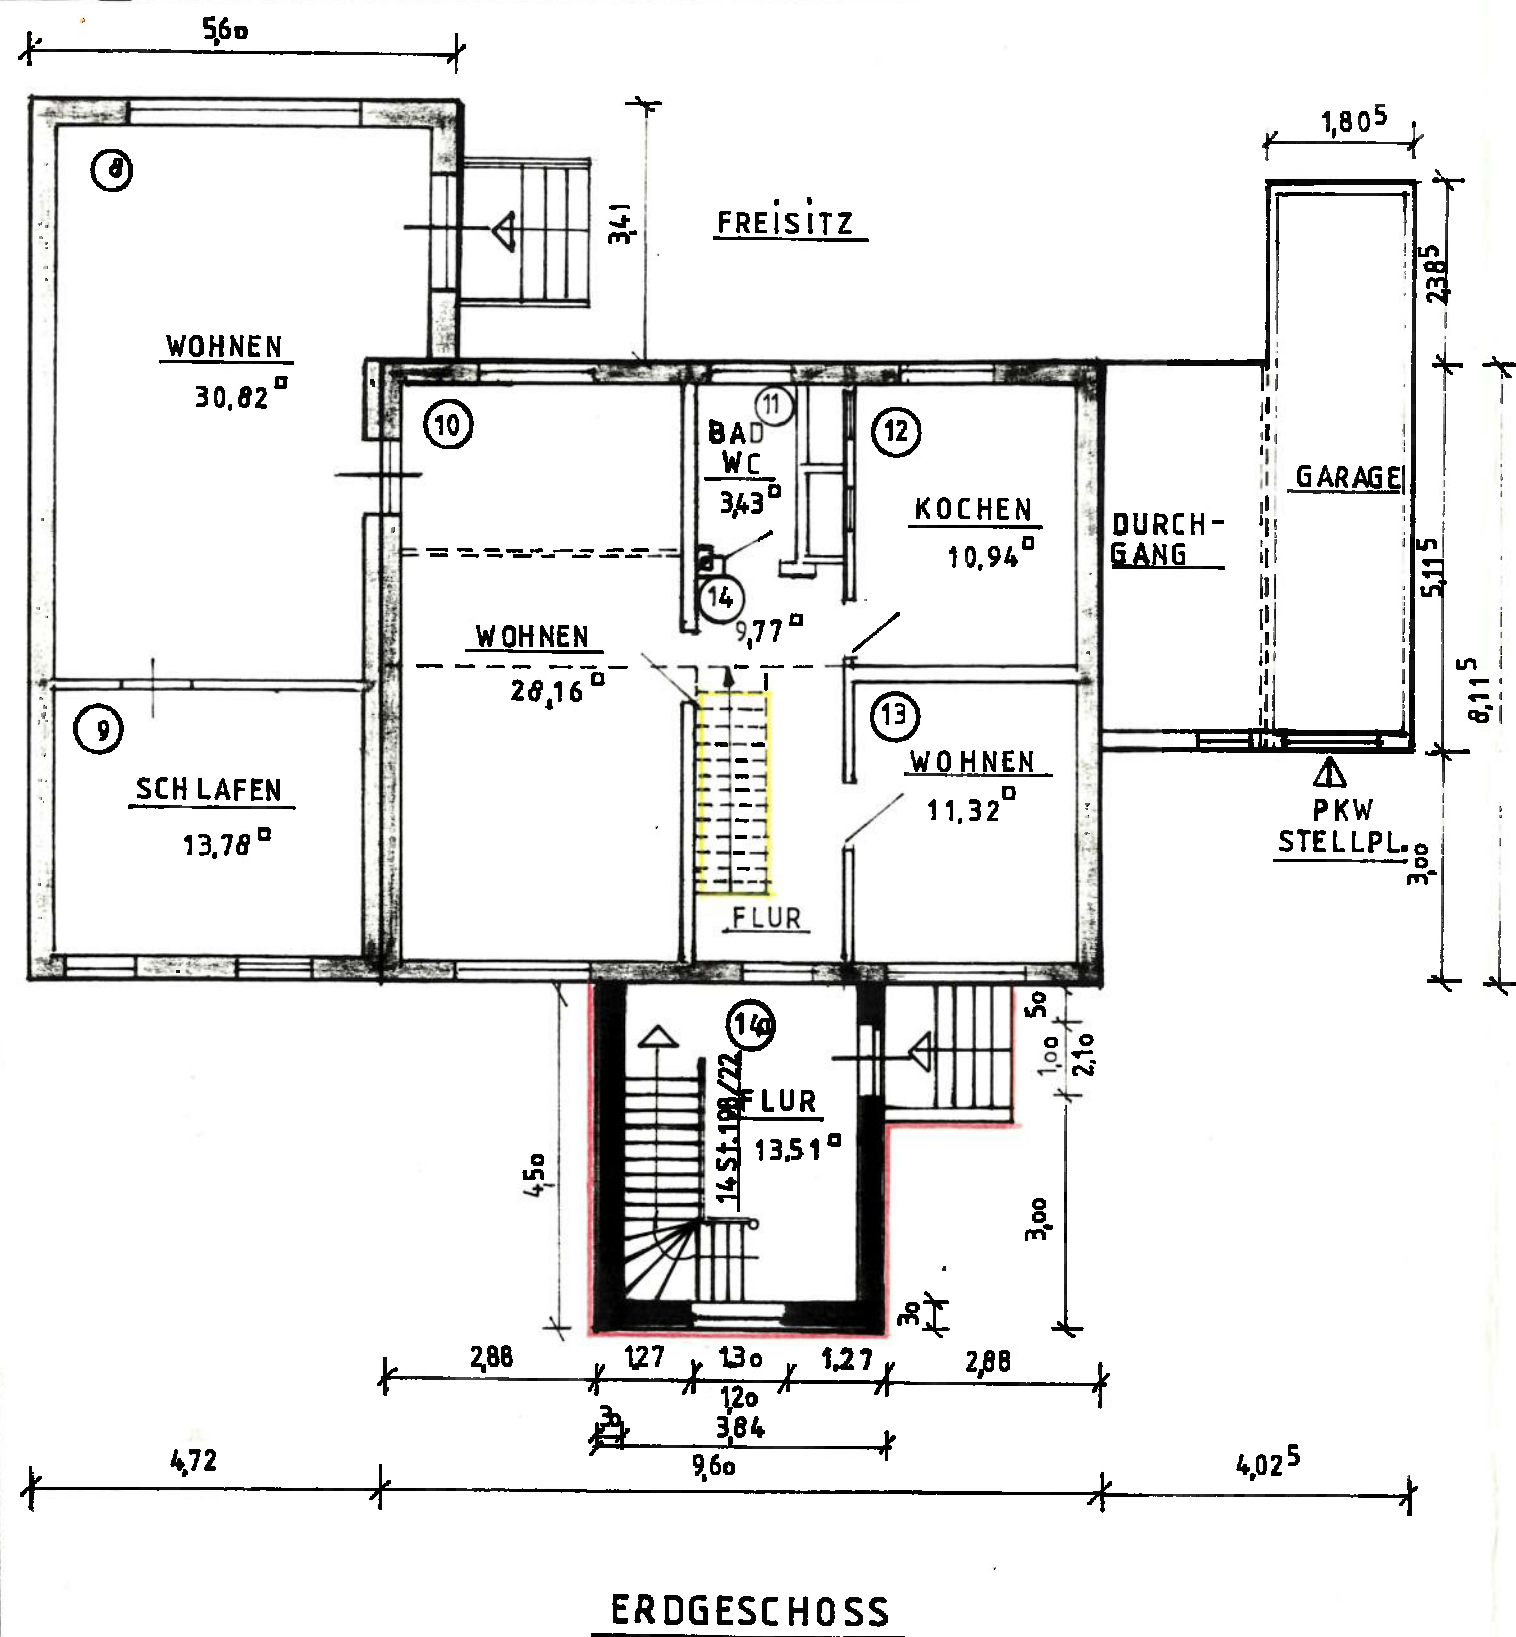

M.1:100

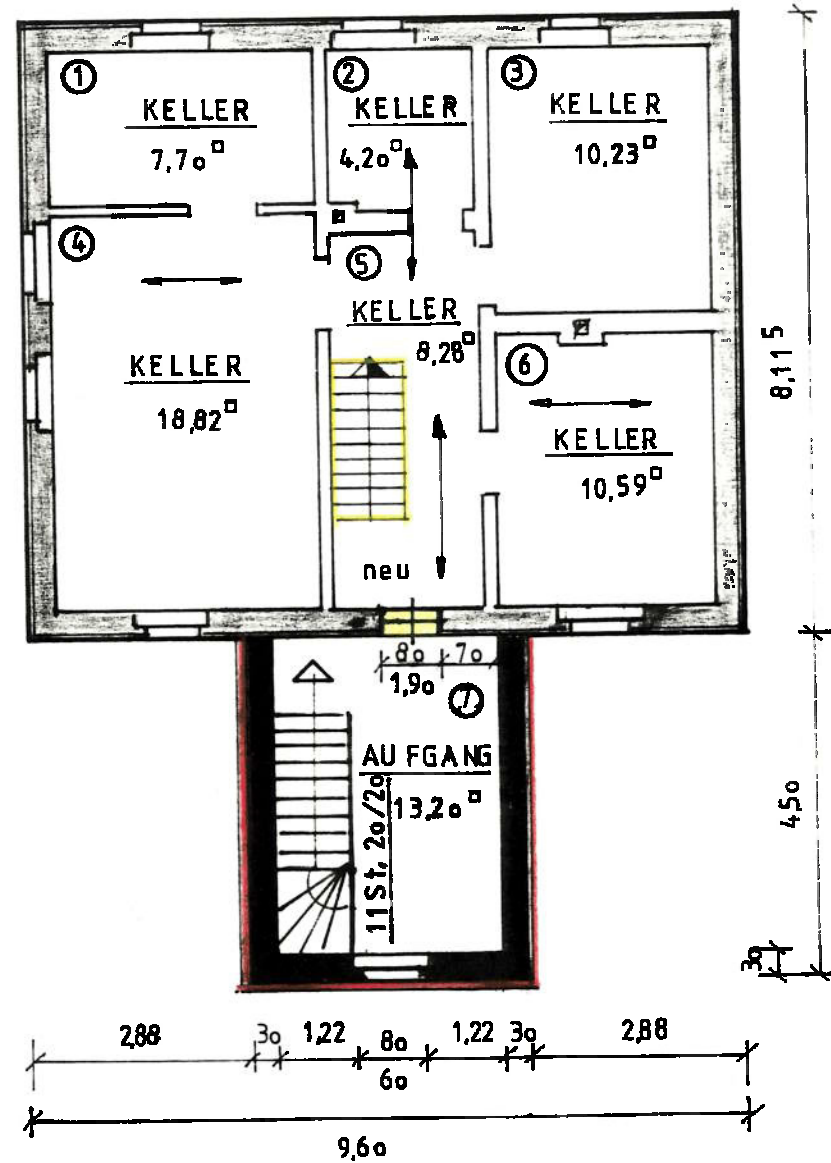

KELLERGESCHOSS