


V13 2150 V13 7600 2x110 V13 6900 V13

3450  
6900



5750  
6800  
20  
20  
20  
20  
110  
30  
1250  
1350  
V10  
115

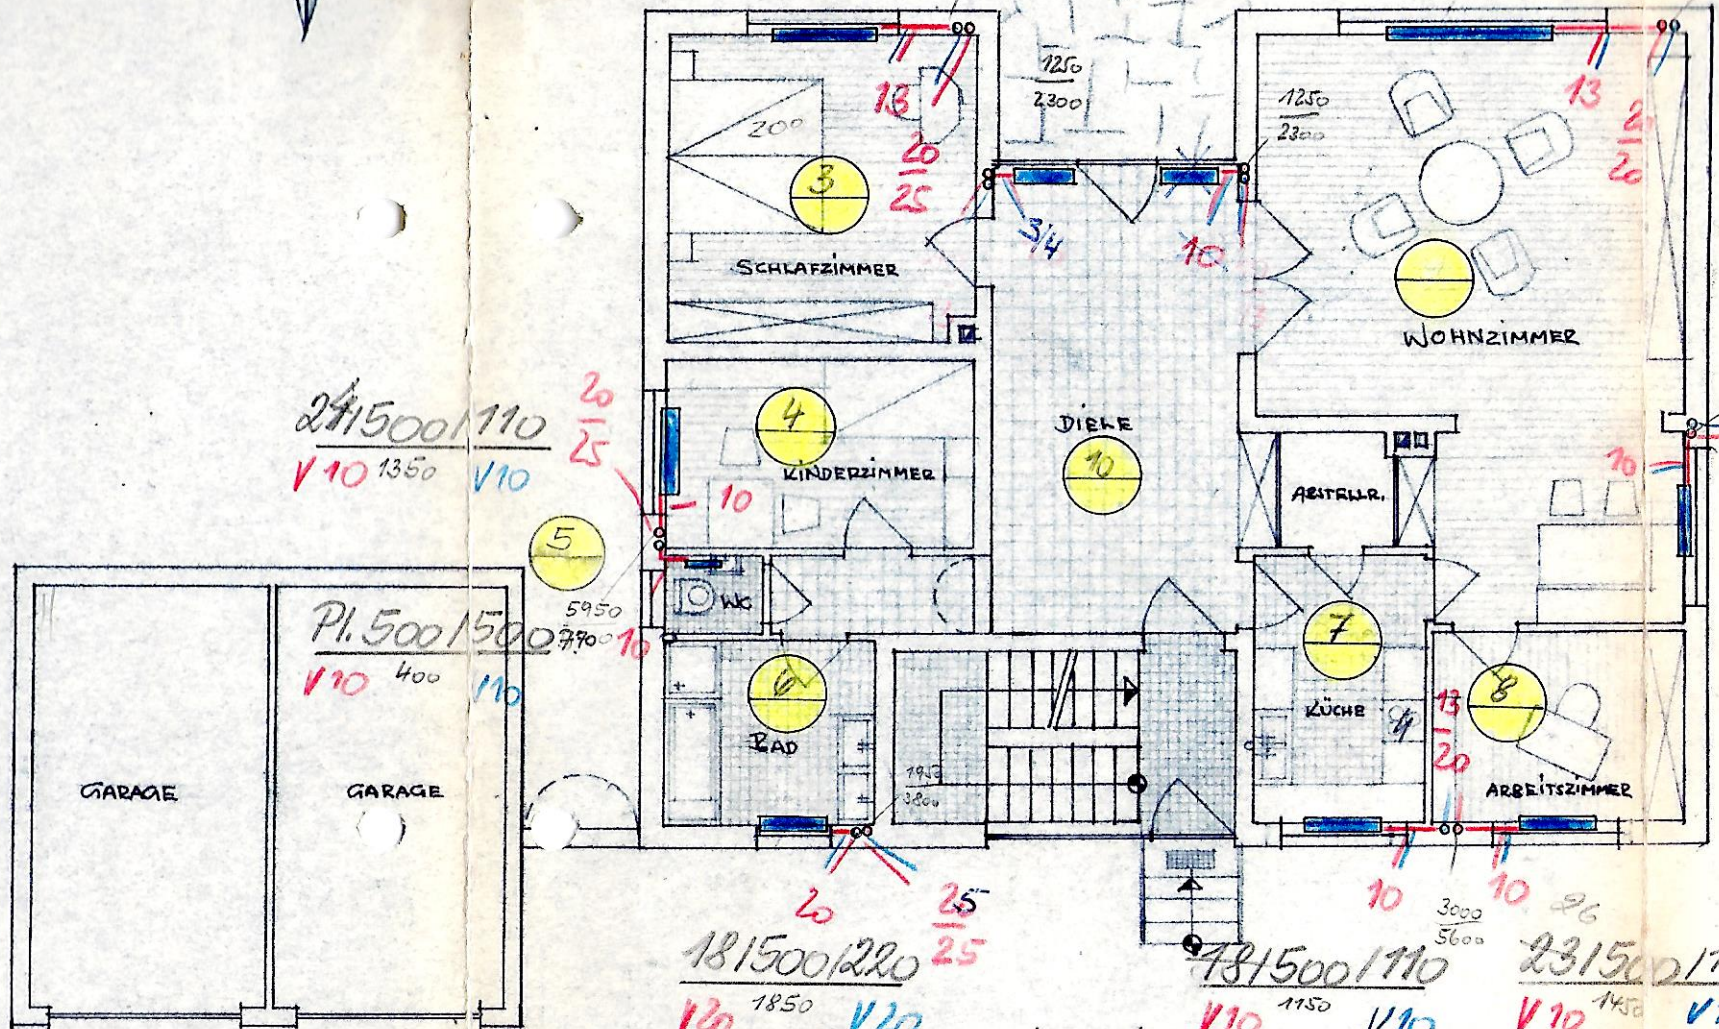