


11,008

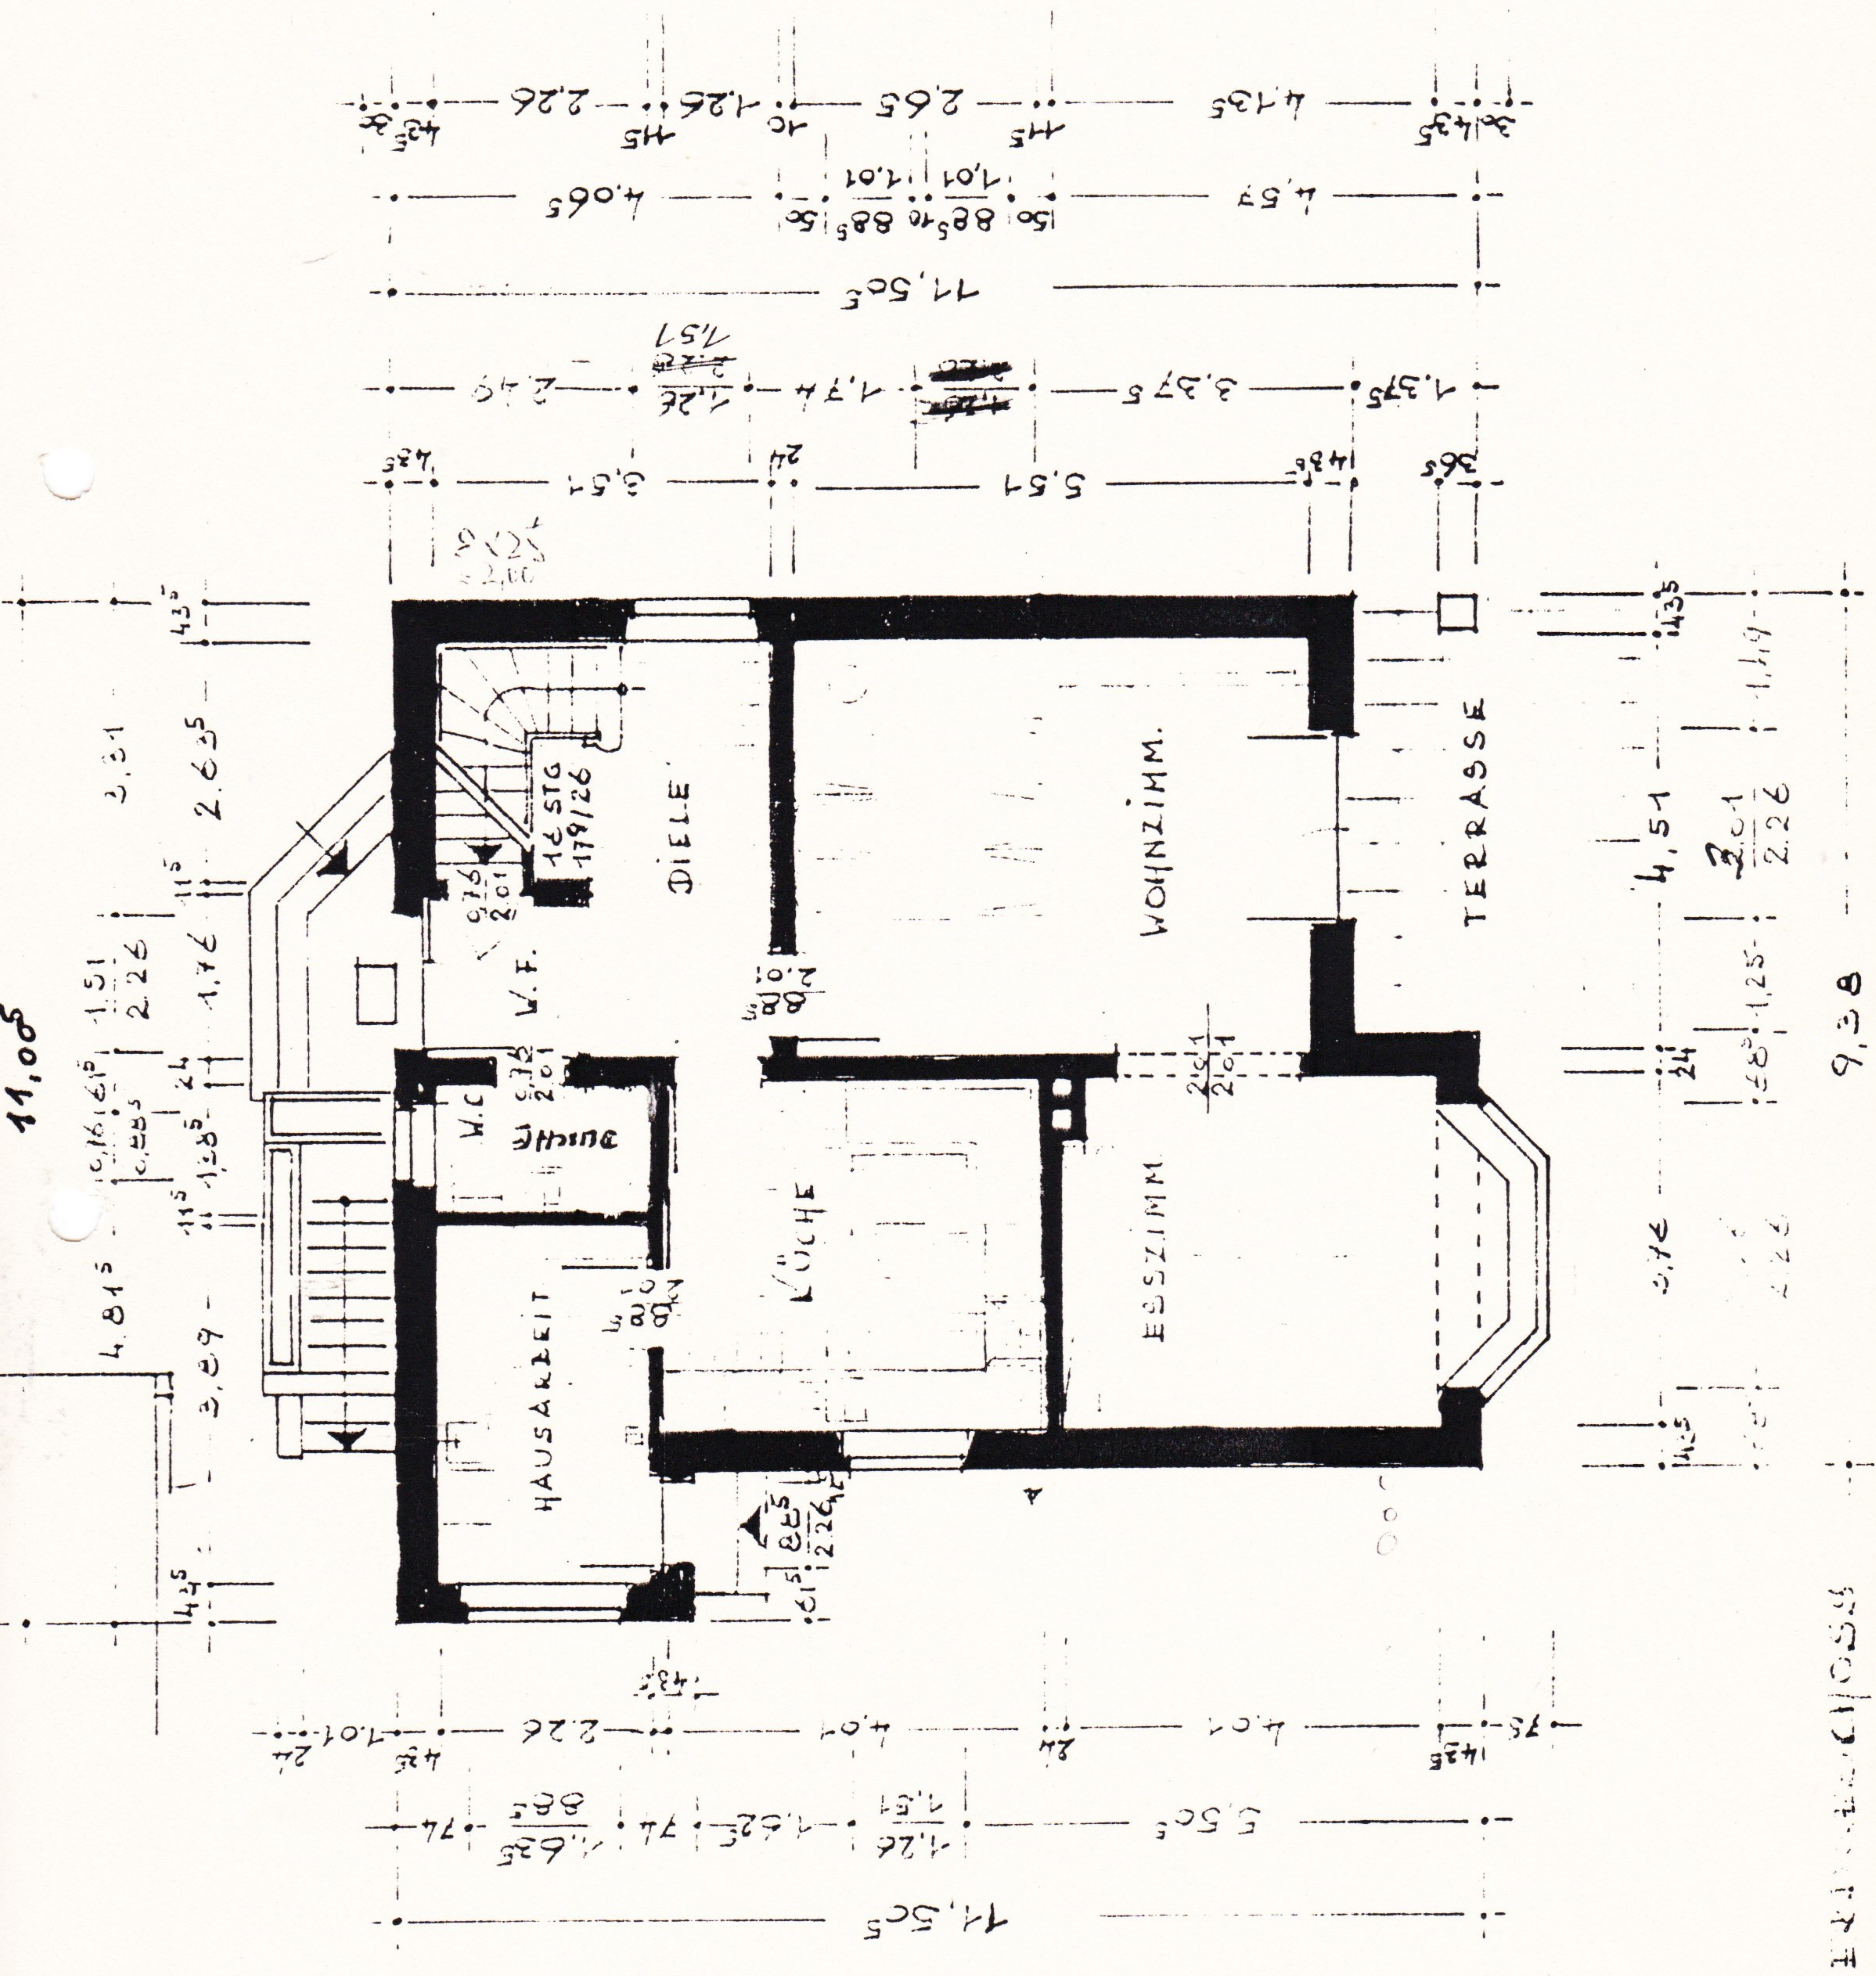

BRUNNEN

9,38