


W.F.L.I.E.R

1421 1205

11,505

75 5,73 80 49 80 1,62 1,01 1,05
 60 60 60 60 60 60
 365 49 3055 24 1,84 10 2,01 175 2,275 49 365
 49 365 + 07 4,025

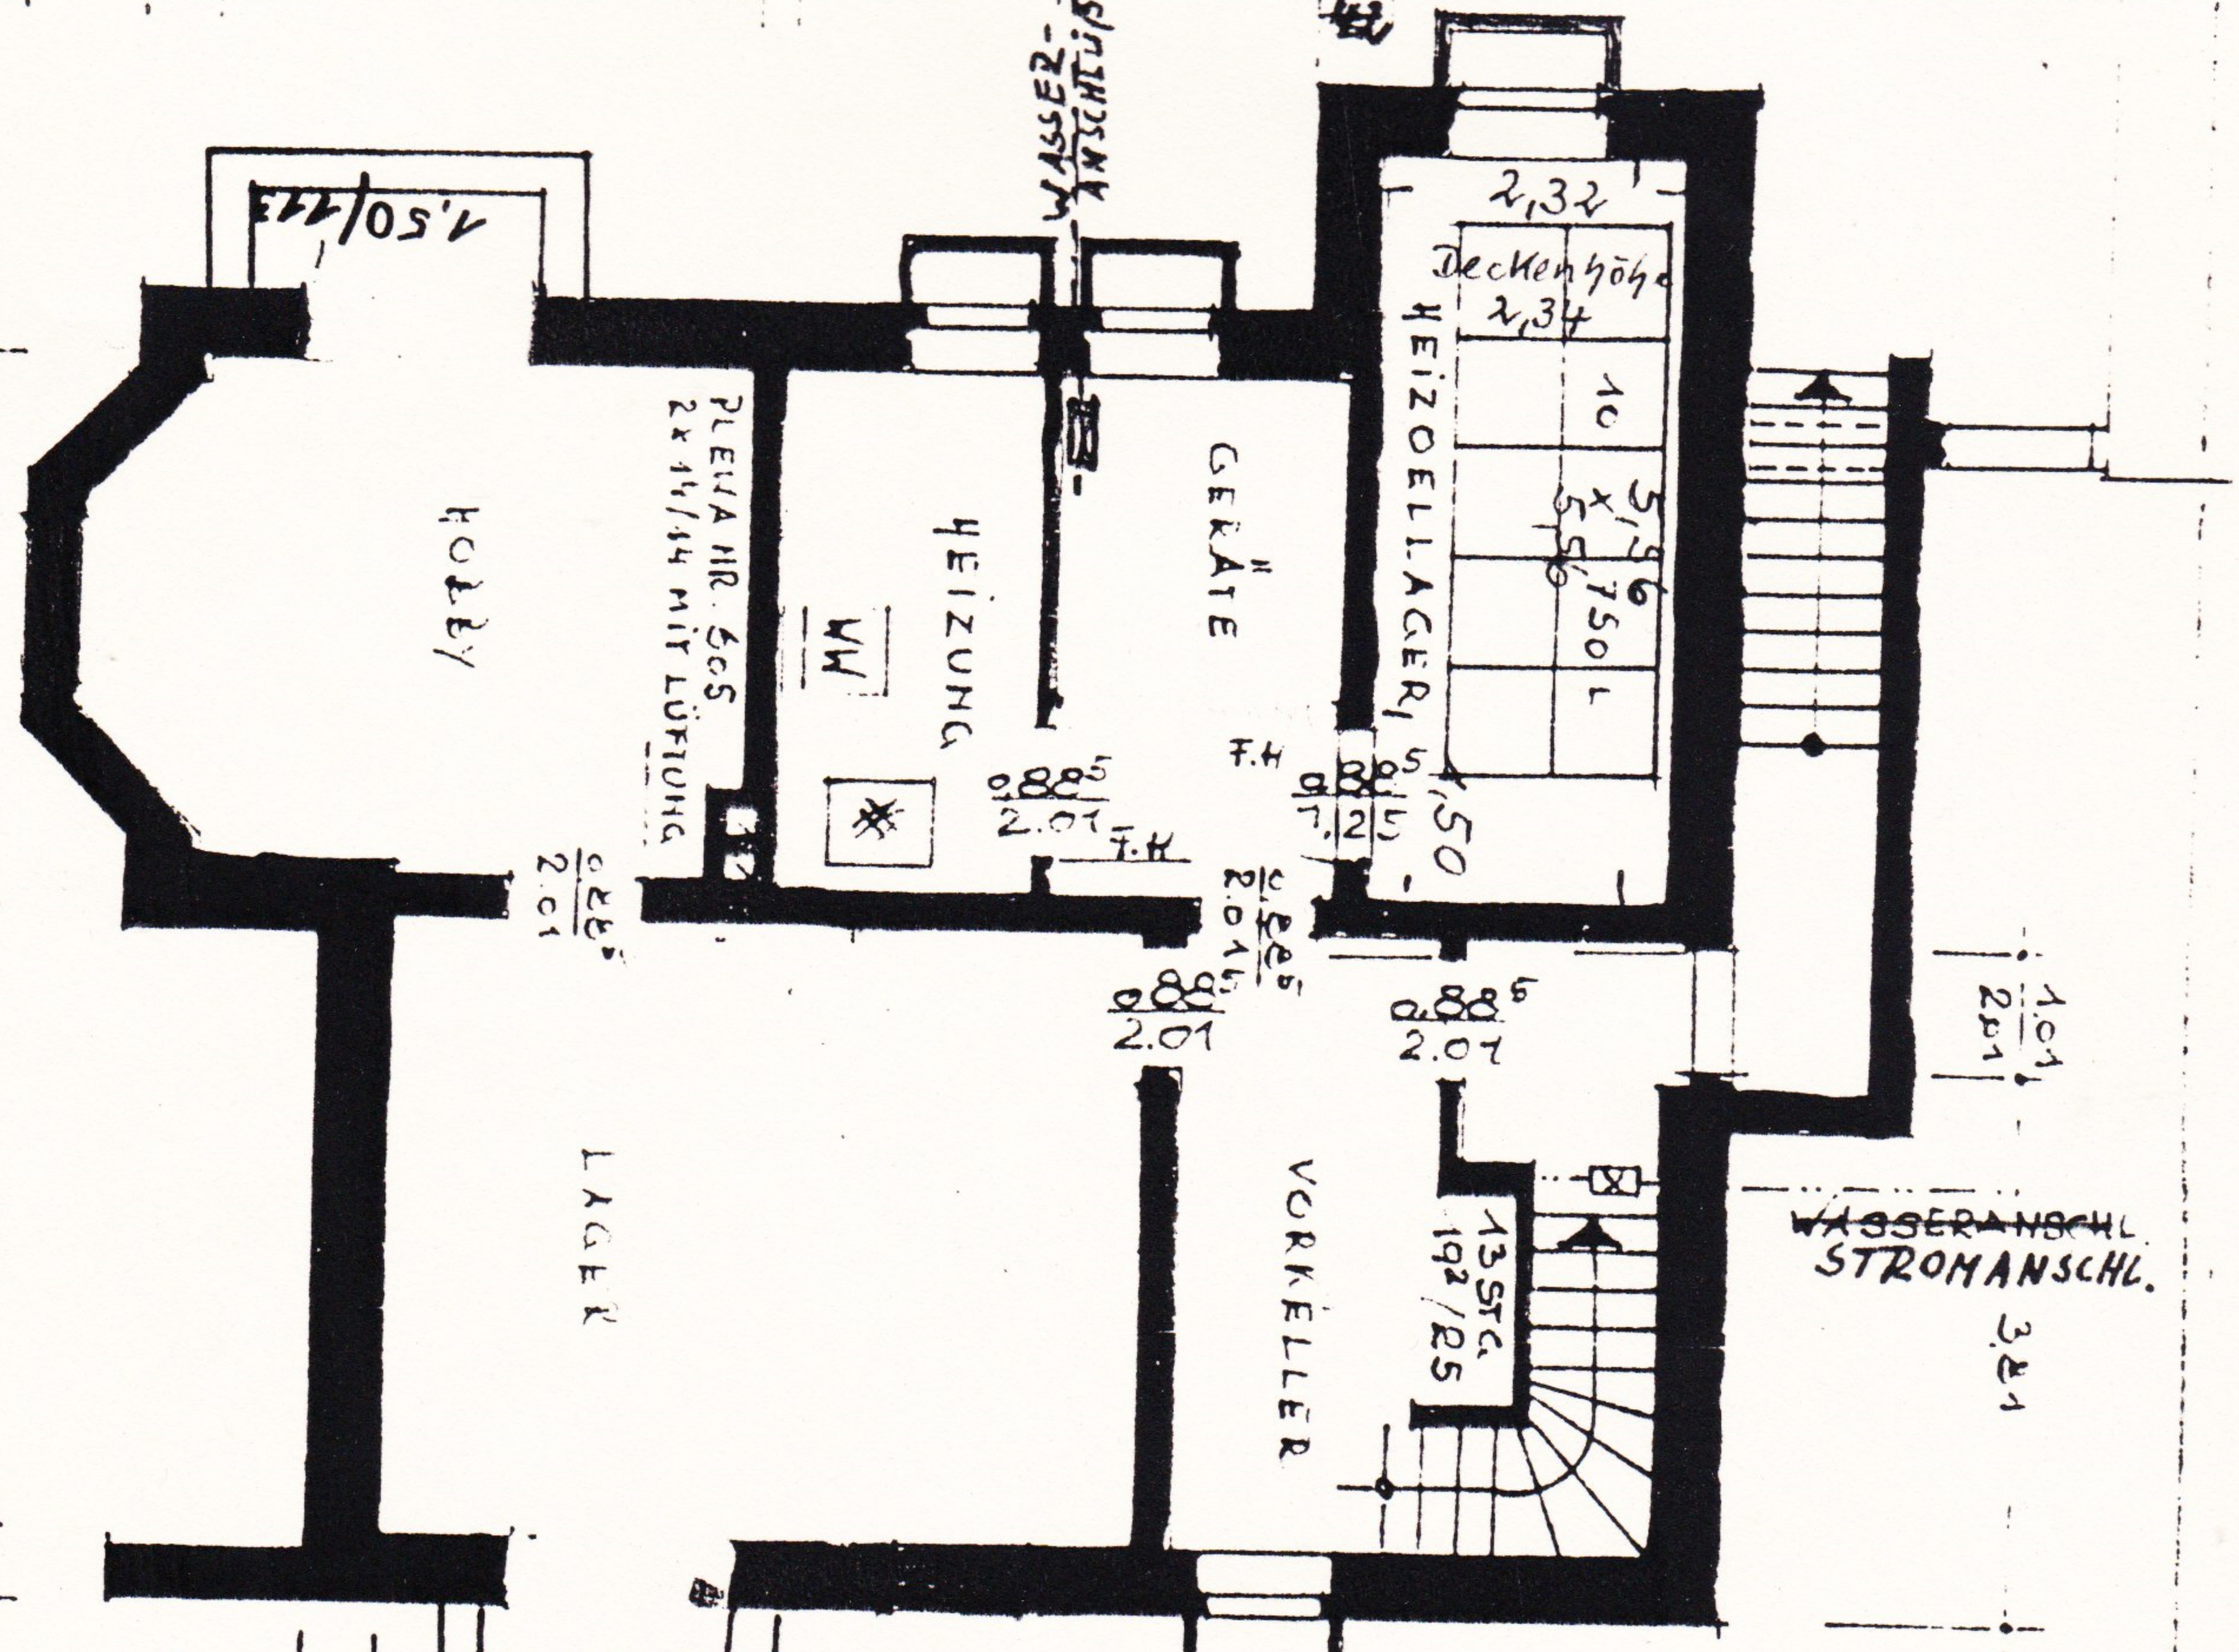

1,91 2,195 1,91 2,4 9,38
 1,51 1,91 2,4 1,51 1,91 2,4 1,51 1,91 2,4

525 1,525 4,285

42 49 365

1,375 36 42 49 3,258 10 2,00 24 3,458 365 49 1,01 24
 1,70/1,43 MEA 86
 3,195 1,615 80 1,325 80 272 60 60
 11,505

2,125 75 1,70 1,01