


4.22

6.00

4.87

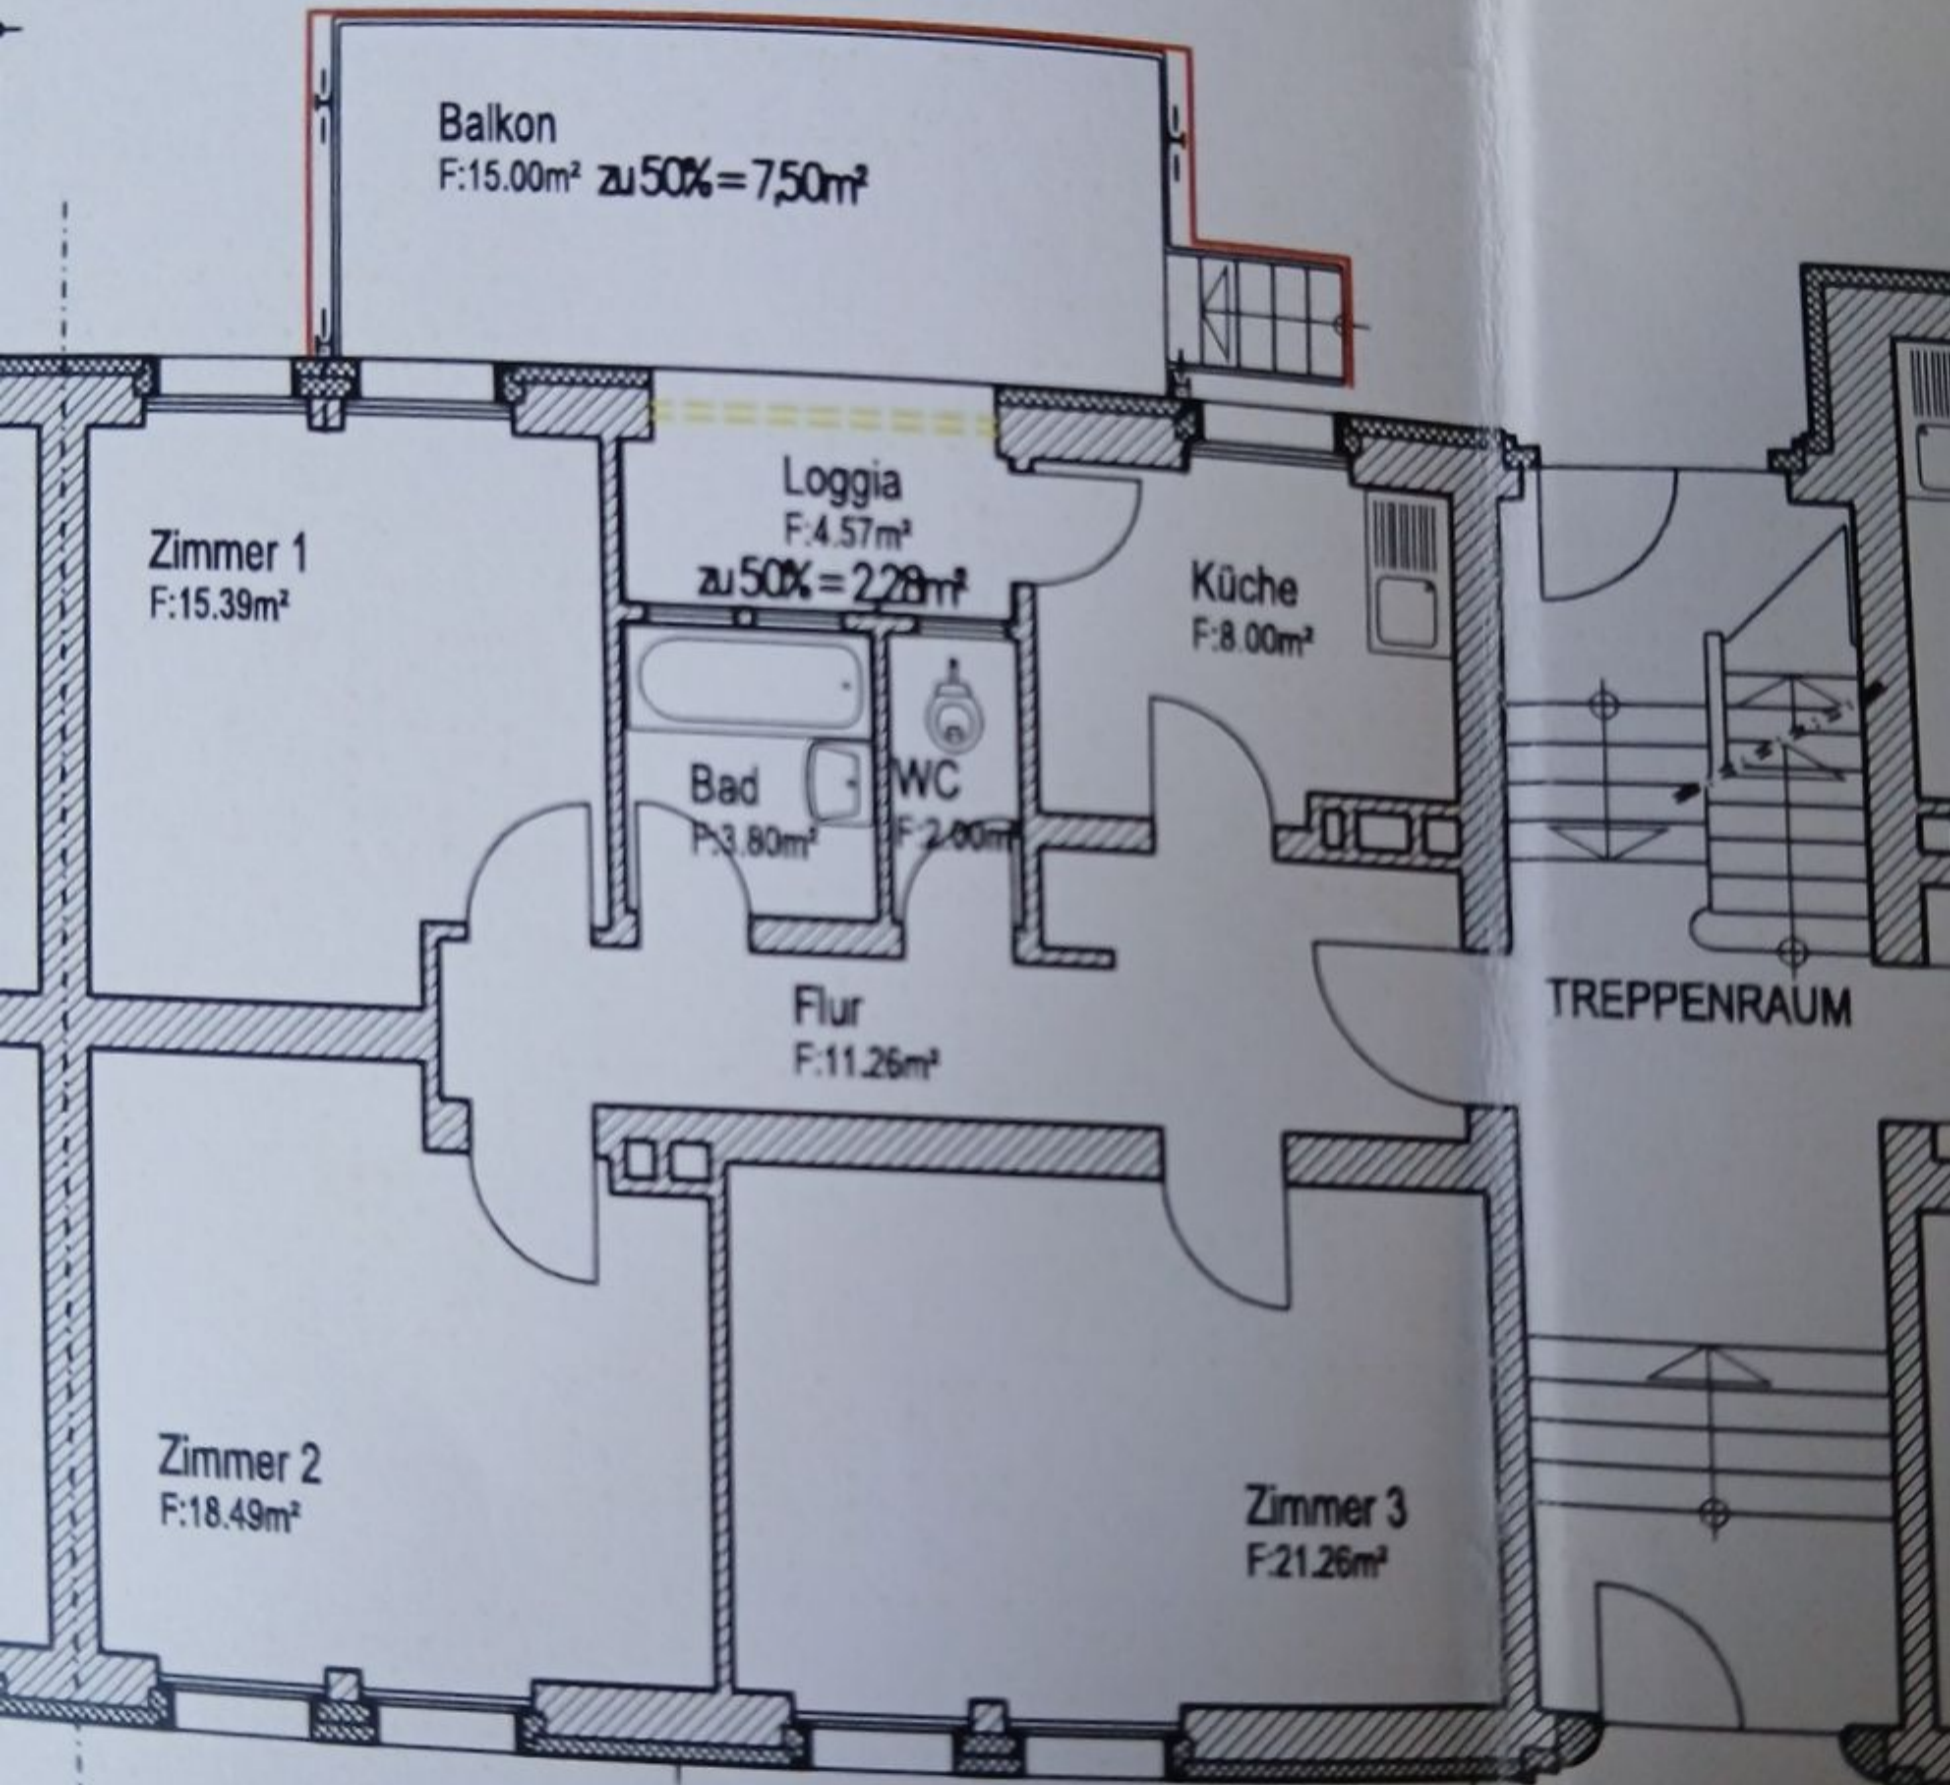

51.00