

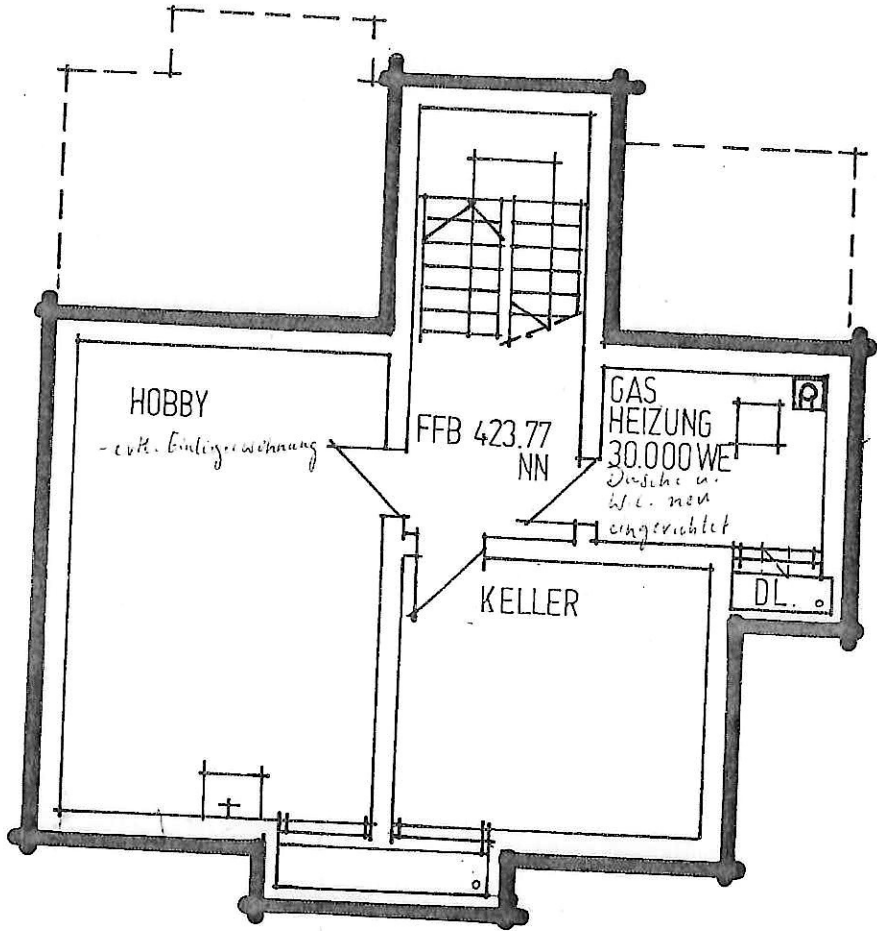




X unser Haus

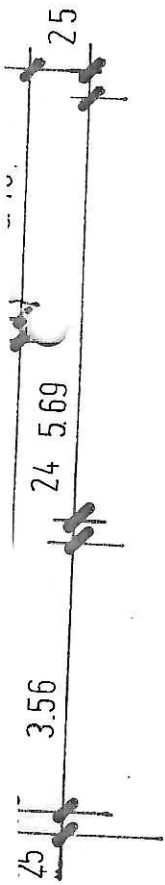

### HAUS 4 KELLERGESCHOSS

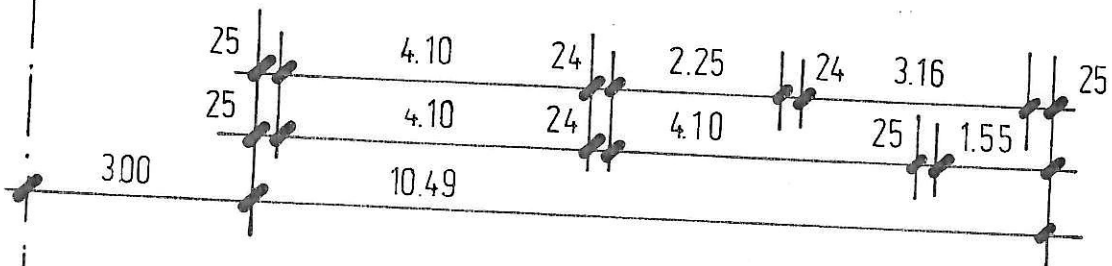


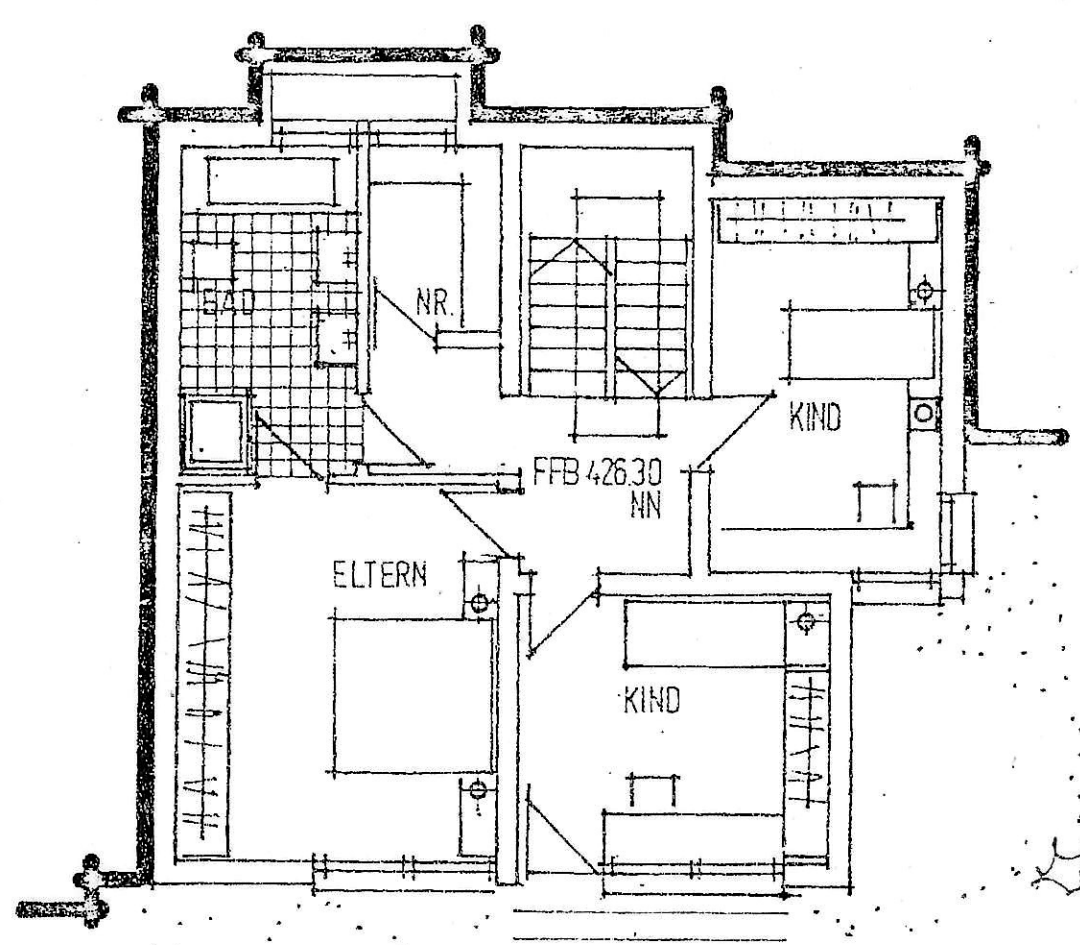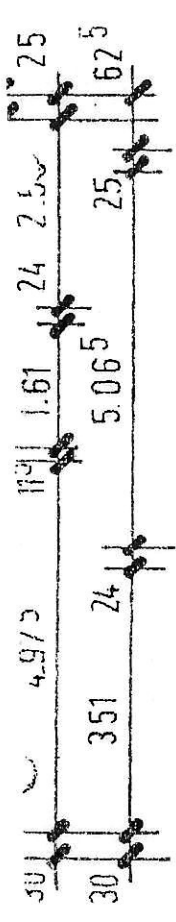

HAUS 4  
SCHLAFGESCHOSS

