


7.00

21.25

30 3.04 24 2.33⁵ 11⁵ 2.70 24 2.20 24
1.03 10 1.57

GRENZE

10.90
30
4.46
11⁵ 2.03⁵
10 1.11
24 1.10
24 1.45
30 1.43
1.52

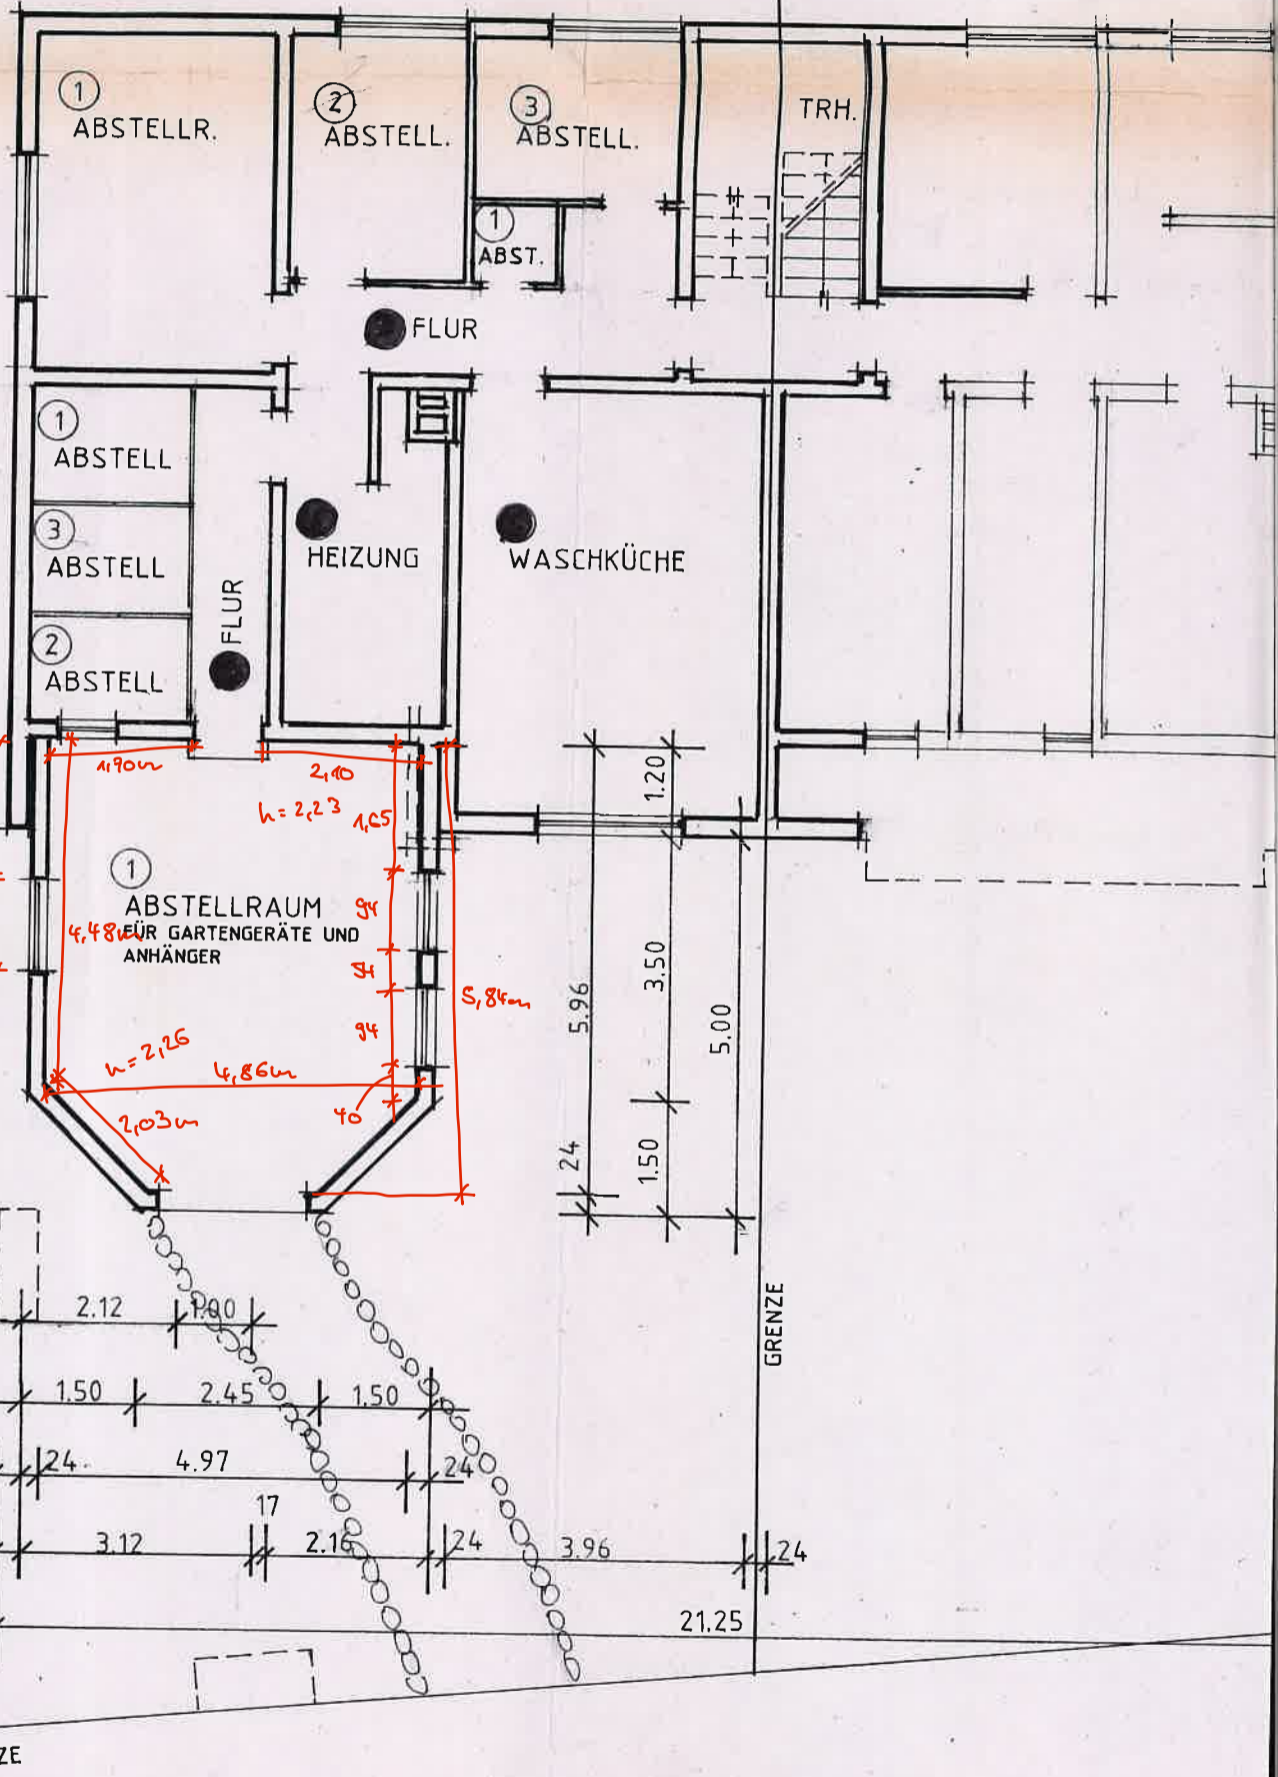

GRENZE

GRENZE

GRENZE

UNTERGESCHOSS