


11.99

1.00 | 1.25 | 1.00 | 1.25 | 1.00 | 1.74
0.60 | 0.60 | 0.60

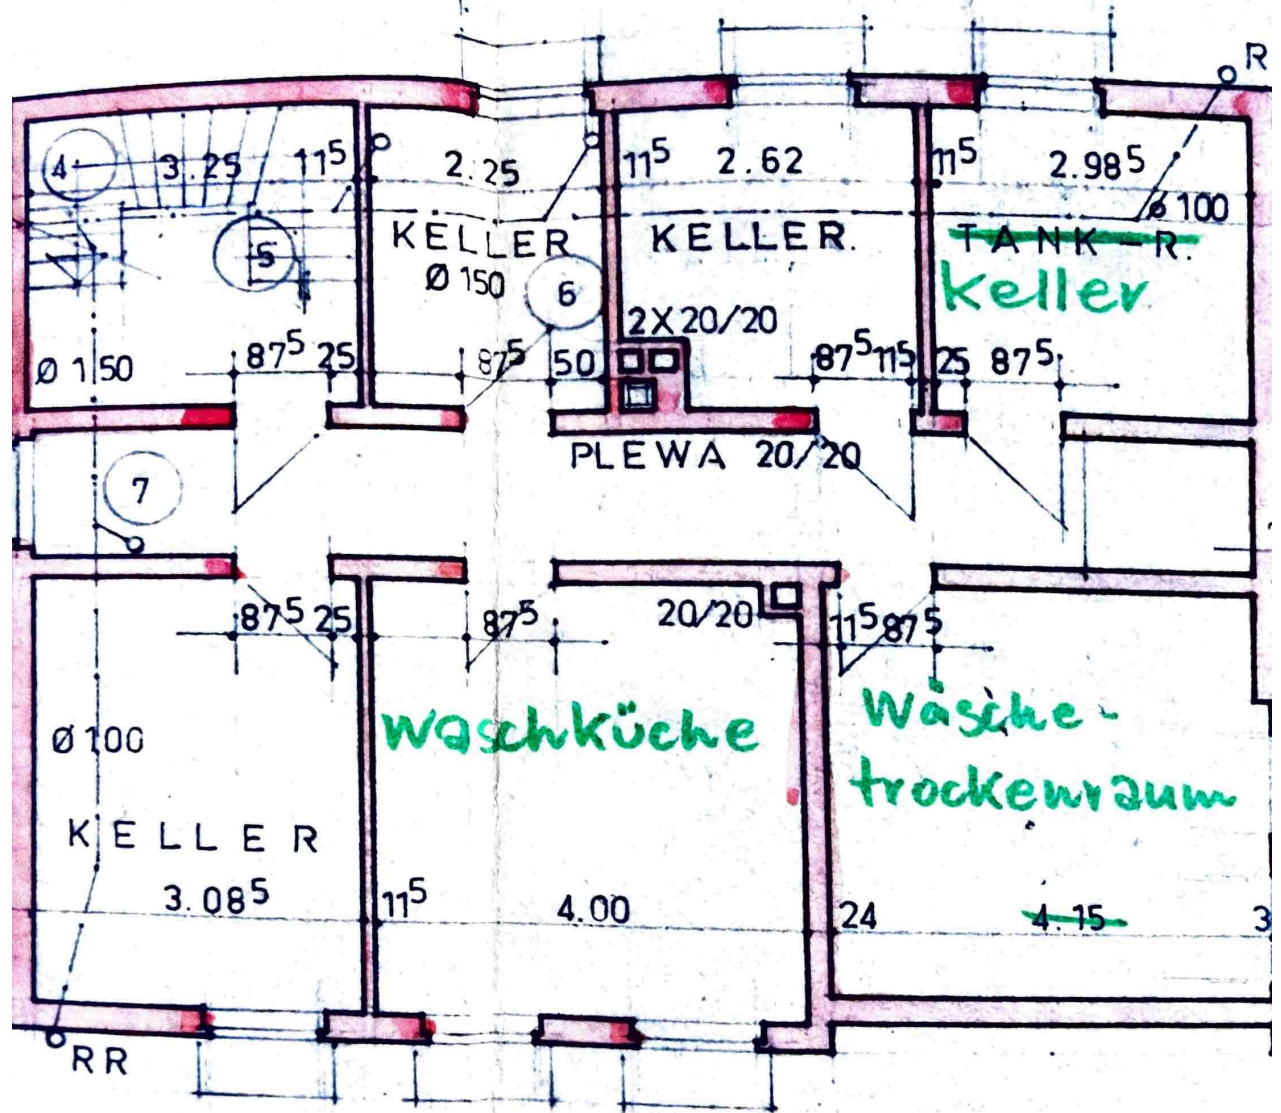

3.25 115 2.25 115 2.62 115 2.985
 KELLER Ø 150 6
 TANK R.
 Keller
 2X20/20
 Ø 150 875 25 875 50 875 115 25 875

7
 Ø 100
 PLEWA 20/20
 875 25 875 20/20 115 875

Waschküche
 Wäsche-trockerraum
 KELLER 3.085 115 4.00 24 4.15 3

2.00 | 1.00 | 1.00 | 1.00 | 1.00 | 1.00
0.60

11.99

~~12.19~~