



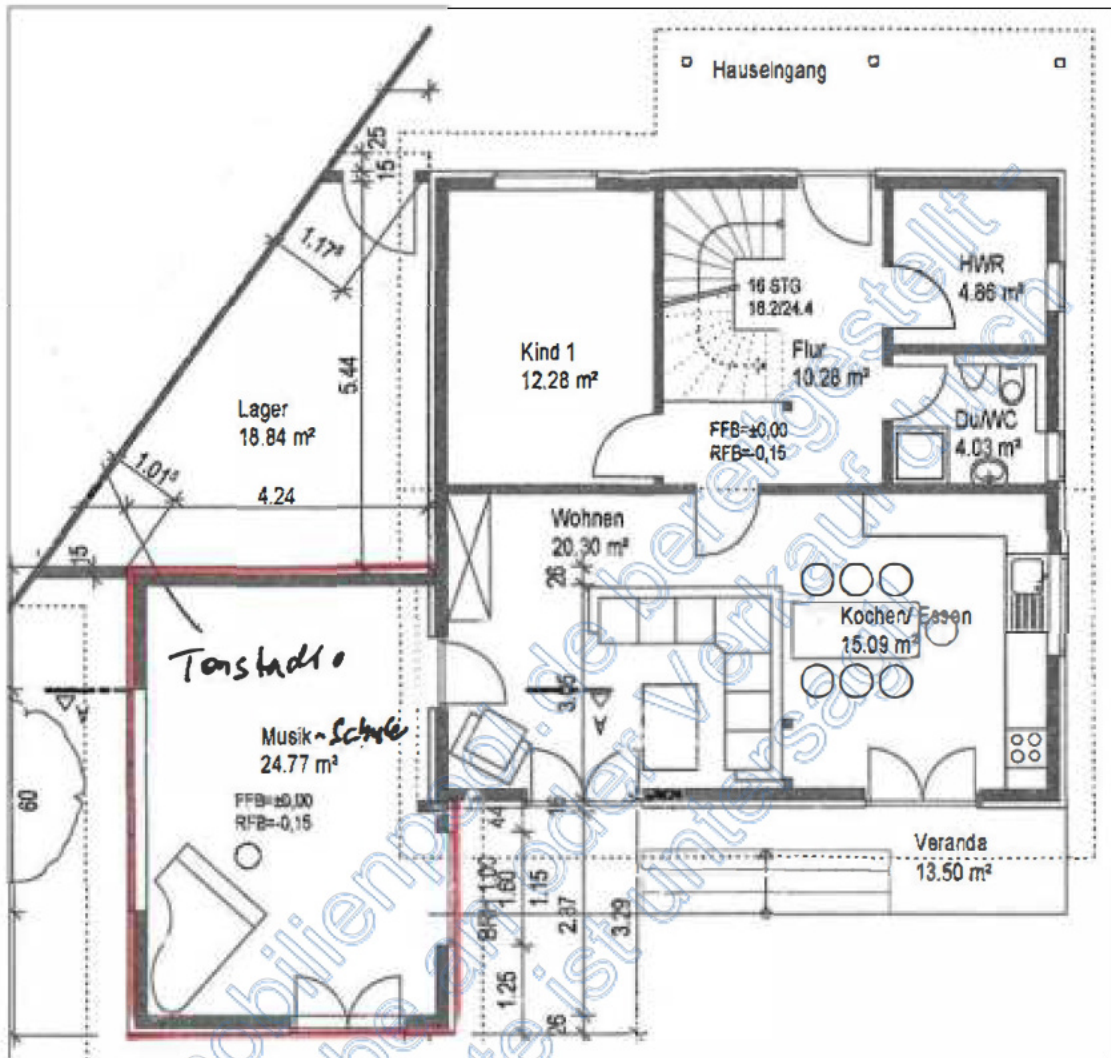

Grundriss 1 Erdgeschoss

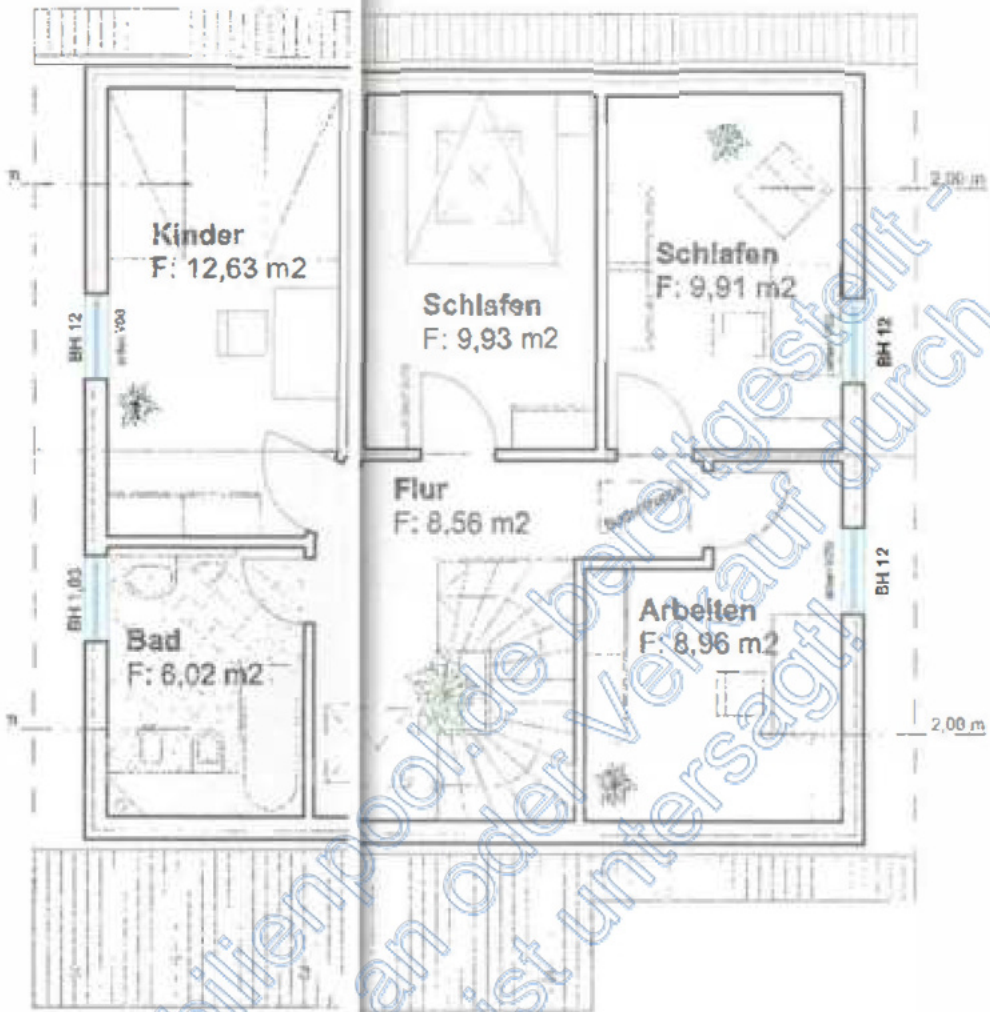

Grundriss 2 Dachgeschoss

Fläche

Erdgeschoss

Kochen/Essen	=	15,05 m ²
Wohnen	=	19,90 m ²
Kind 1	=	12,54 m ²
Flur	=	12,25 m ²
Dusche/WC	=	4,25 m ²
Hauswirtschaft	=	5,13 m ²
Musik	=	24,77 m ²

93,89 m²

Putzabschlag	3%	2,82 m ²
--------------	----	---------------------

91,07 m²

Veranda (50%)

6,75 m²

97,82 m²

Dachgeschoss

Kinder	=	12,63 m ²
Flur	=	9,93 m ²
Kind 2	=	9,91 m ²
Arbeiten	=	8,96 m ²
Flur	=	8,56 m ²
Bad	=	6,02 m ²

56,01 m²

Putzabschlag	3%	1,68 m ²
--------------	----	---------------------

54,33 m²

Summe 152,15 m²

gerundet 150 m²