


A										12,11 ⁵		B	
124	351	124	663 ⁵				24	475		24			
137	101	137	93	401	101	253 ⁵	201	201	151				
	126			186	201		126						

24	426	24
51	805	51
124	551	127
211 ⁵	151	201
	126	201
	286	101
		51
		101
		365

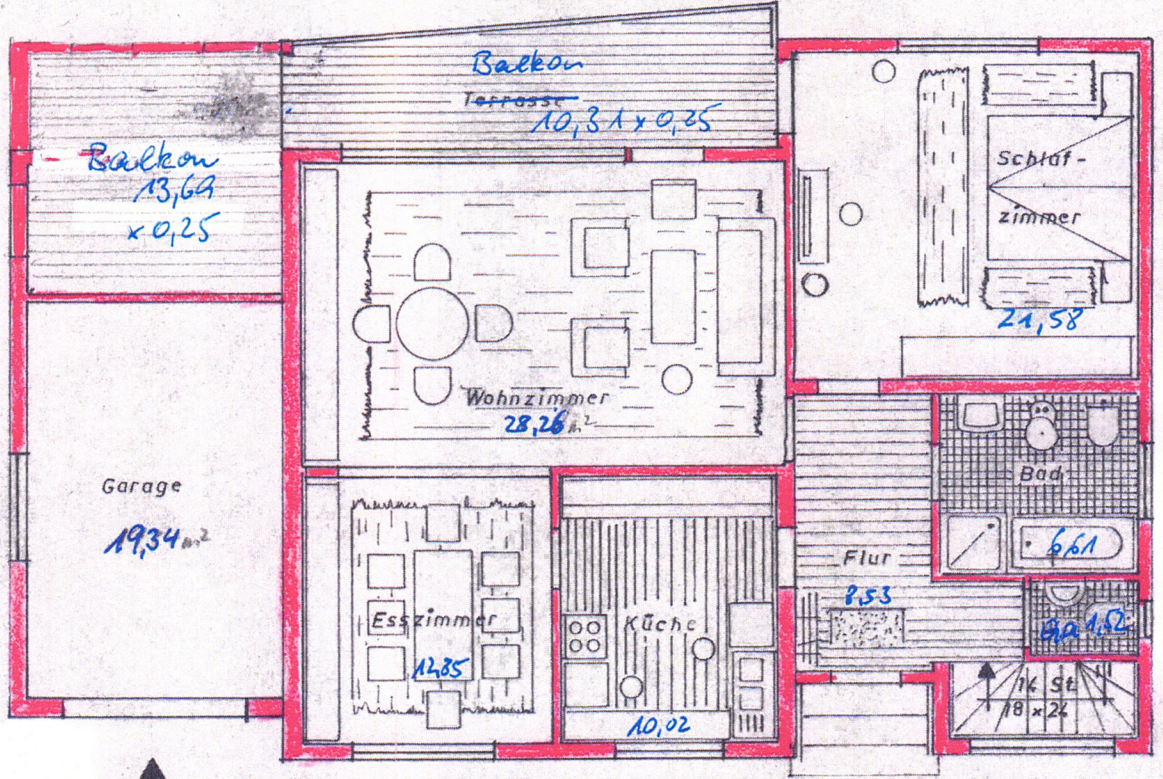

74	251	50	101	201	152 ⁵	151	151	101	101	201	51
	201			126		126		201		176	
124	351	124	351	11 ⁵	301	24	201	11 ⁵	101	11 ⁵	151
	375										
						12,11 ⁵					

A

12,11

