


9.11 3.1  
 18 112 4.63<sup>s</sup> 11<sup>s</sup> 3.76 12 18

1.25  
 5.43 4.61<sup>2</sup>  
 1.63<sup>s</sup>  
 5.43 4.61<sup>2</sup>  
 3.50 3.20

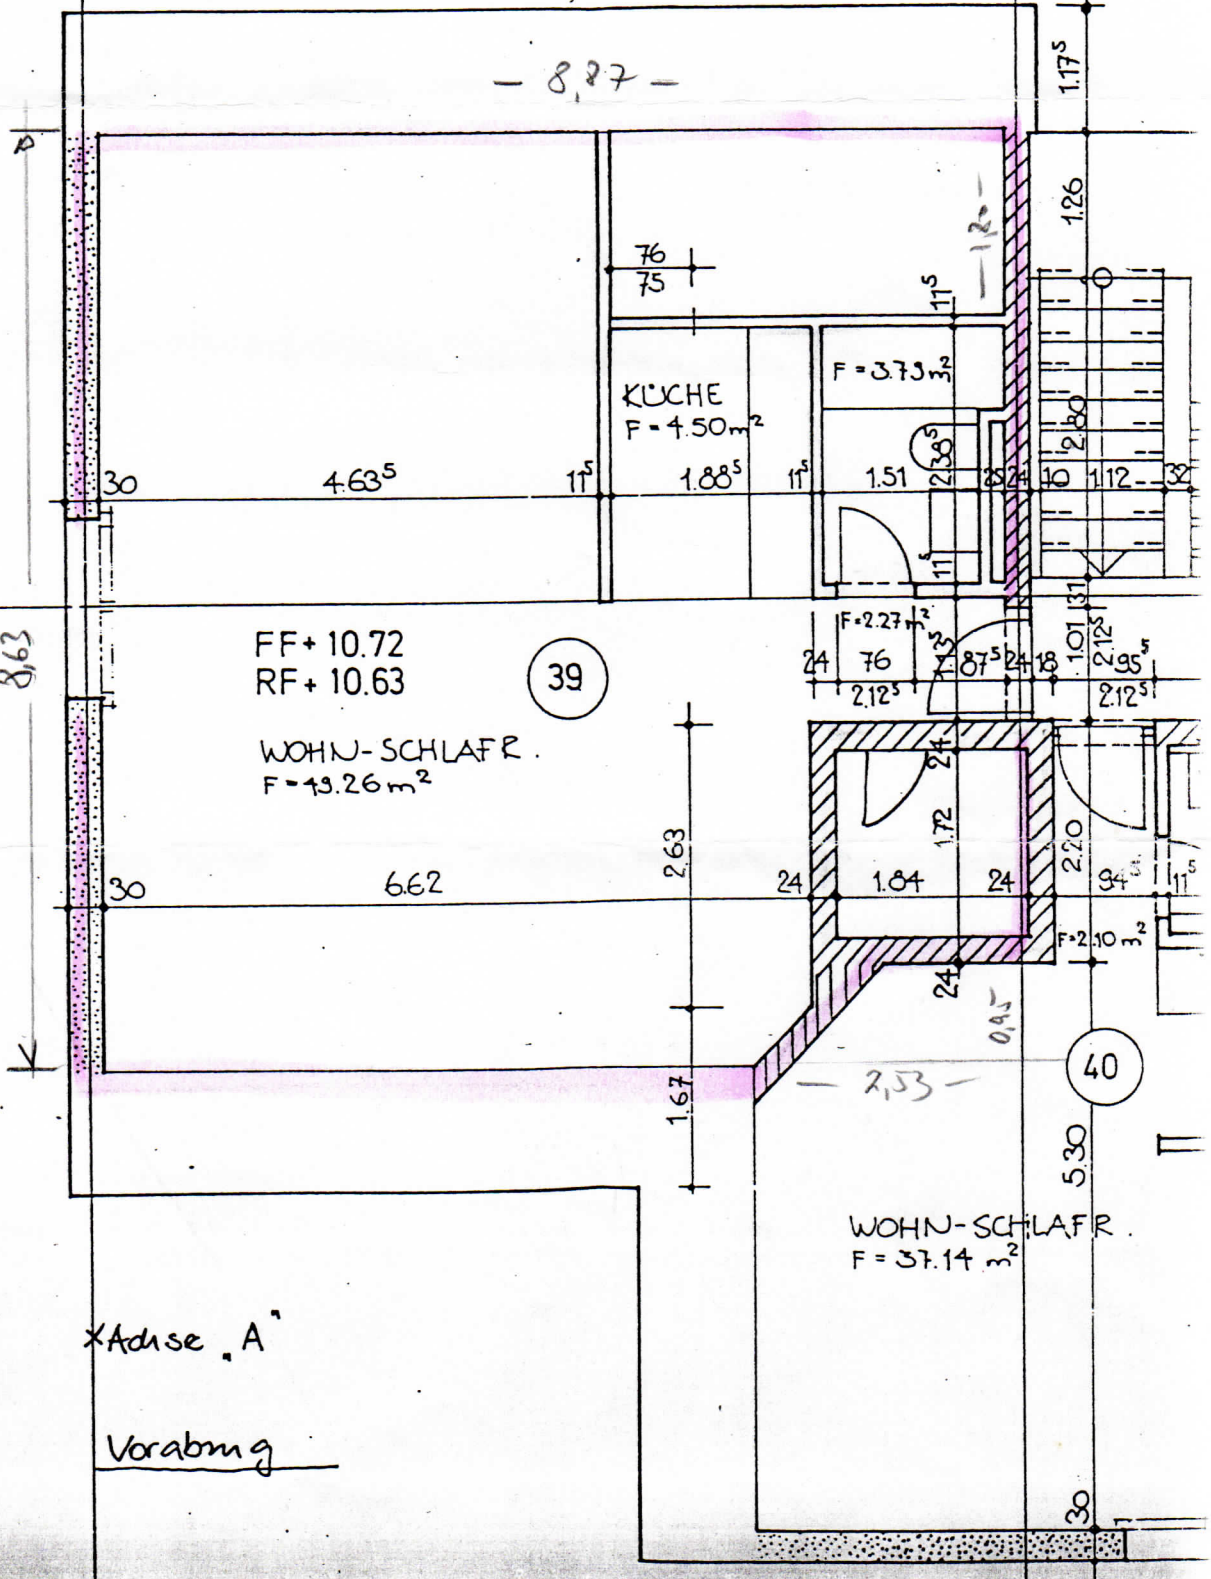

- 8,87 -

8,63

FF+ 10.72  
 RF+ 10.63

39

WOHN-SCHLAFR.  
 F=13.26 m<sup>2</sup>

F=3.73 m<sup>2</sup>

F=2.27 m<sup>2</sup>

WOHN-SCHLAFR.  
 F=37.14 m<sup>2</sup>

40

\*Adise 'A'

Vorabmg