
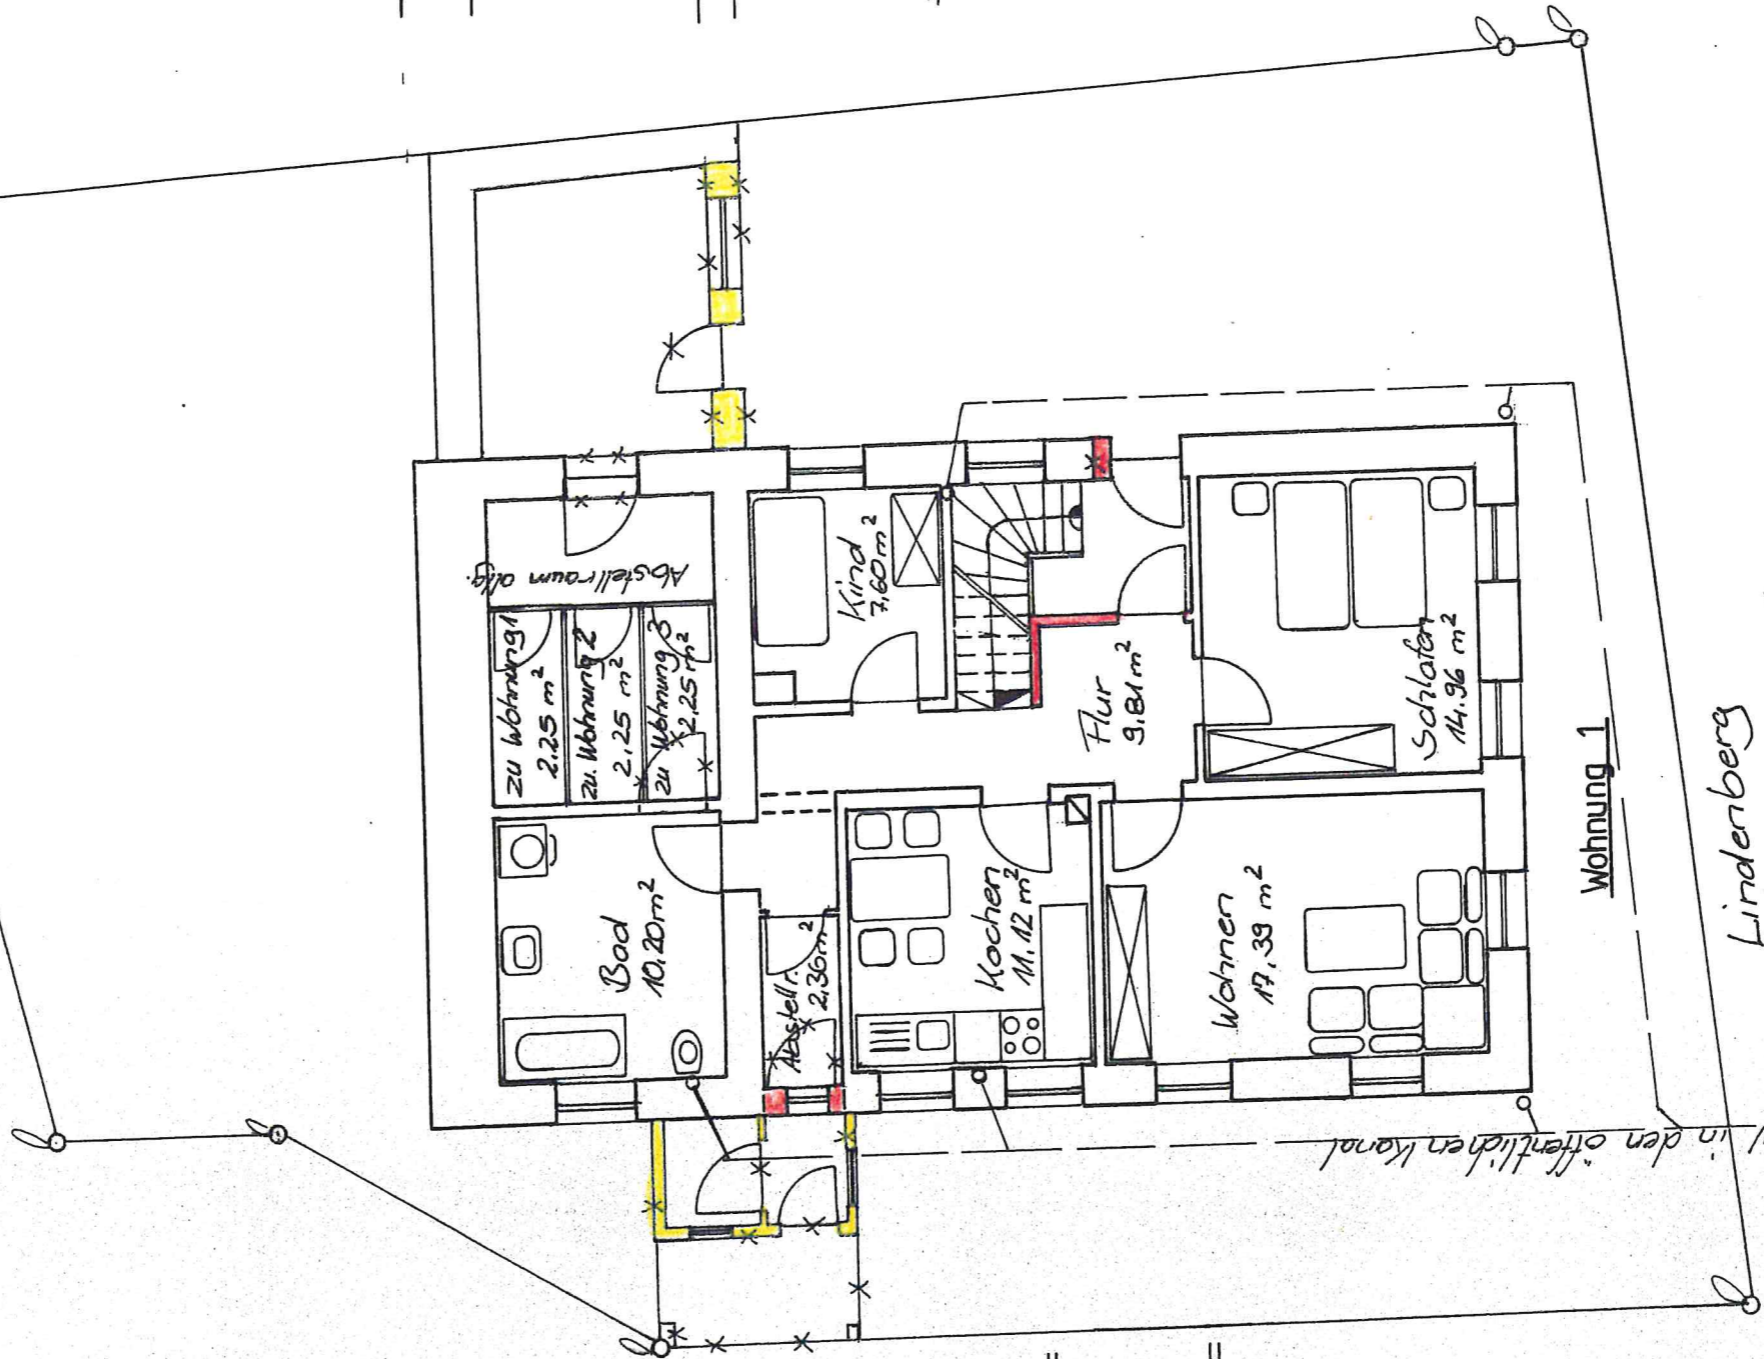
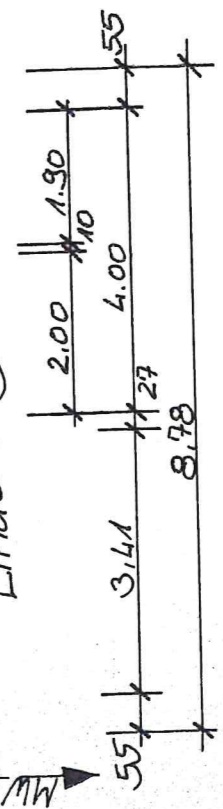
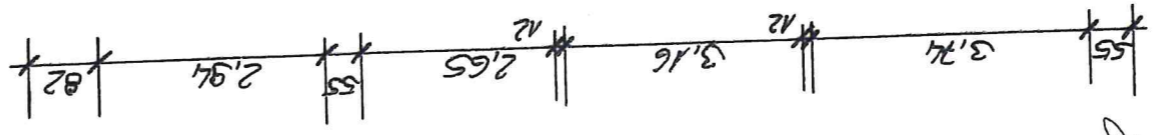
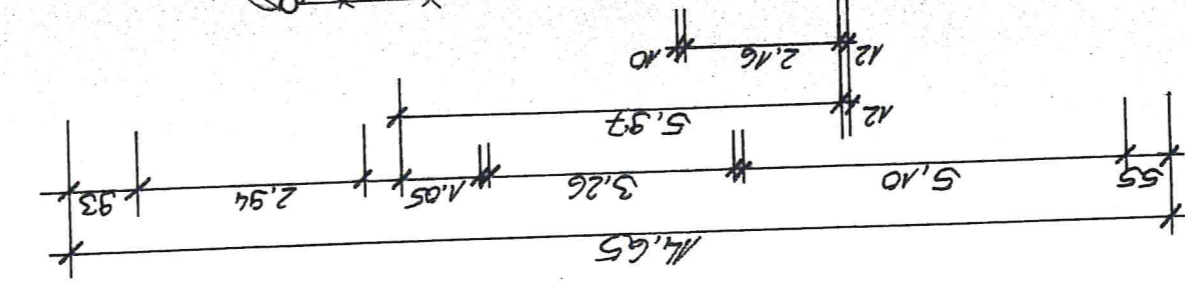


Erdgeschoss

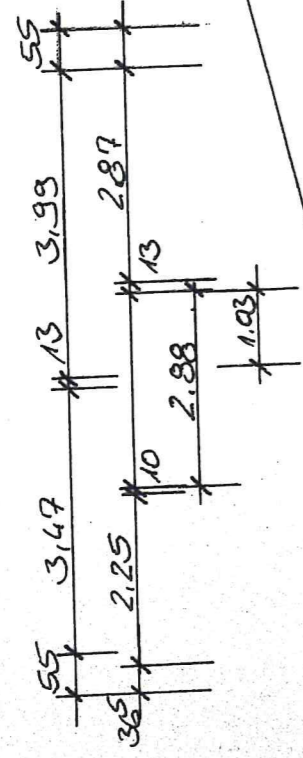

5/12
12 m 1,64 m 2,06 m 4,30