

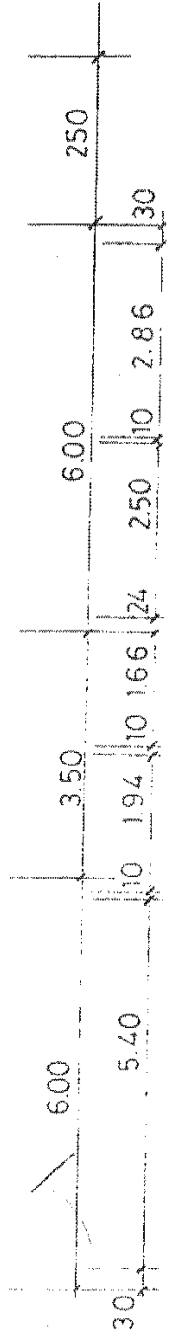


M 1:100

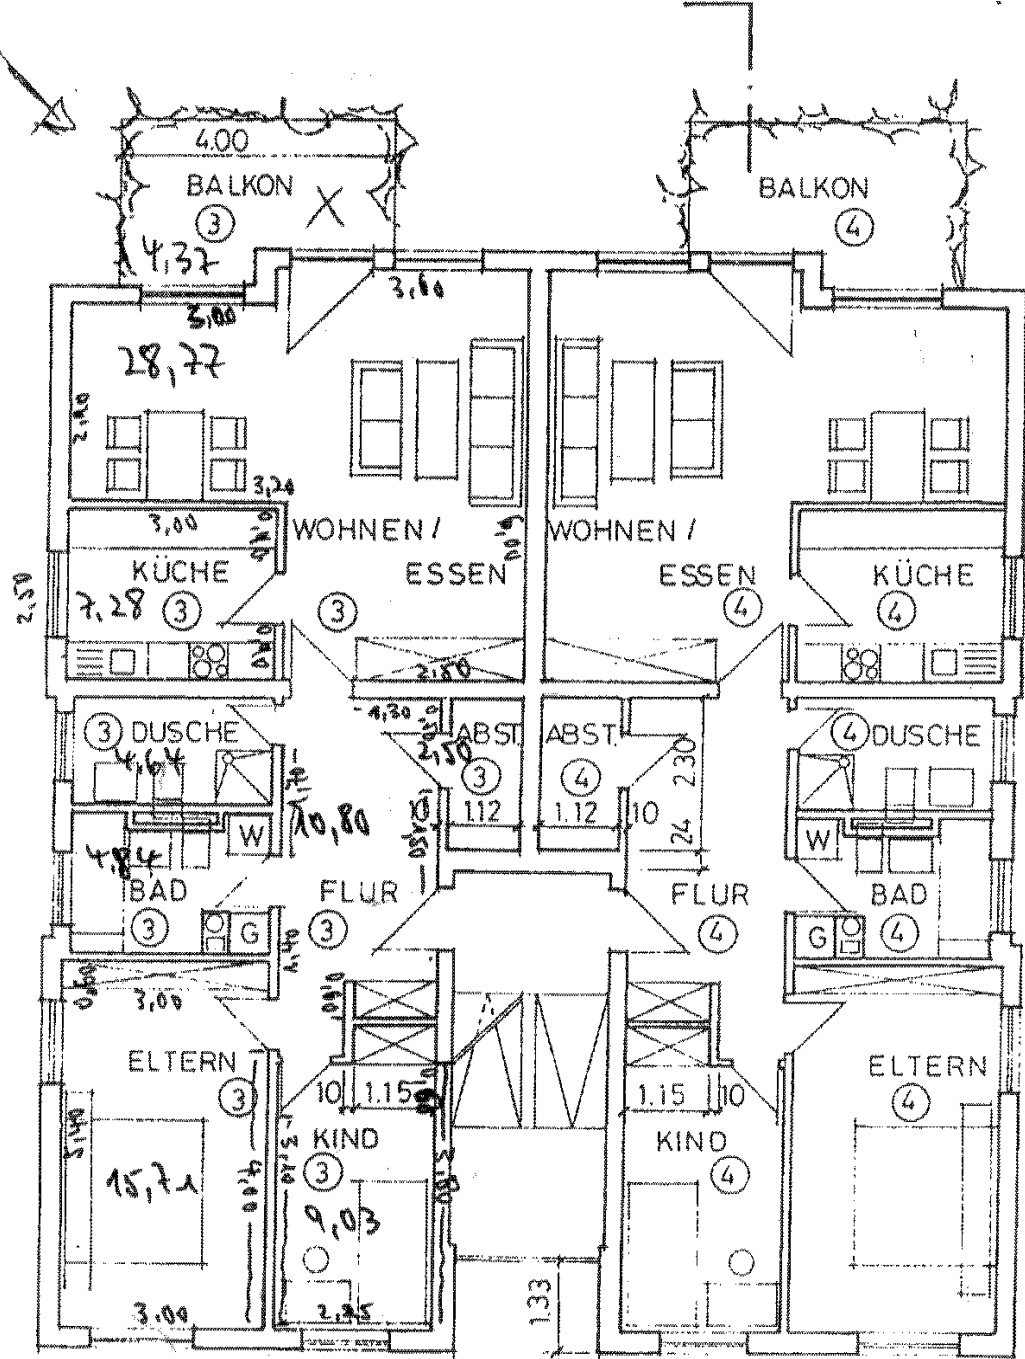

09

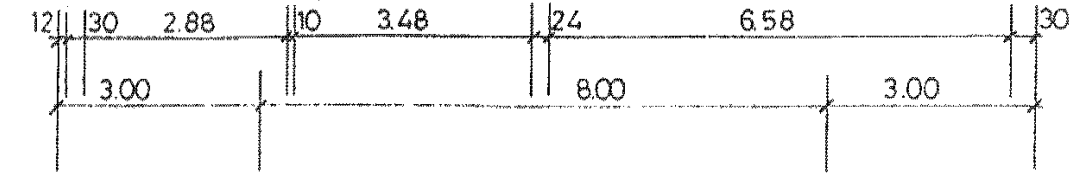