


HT //

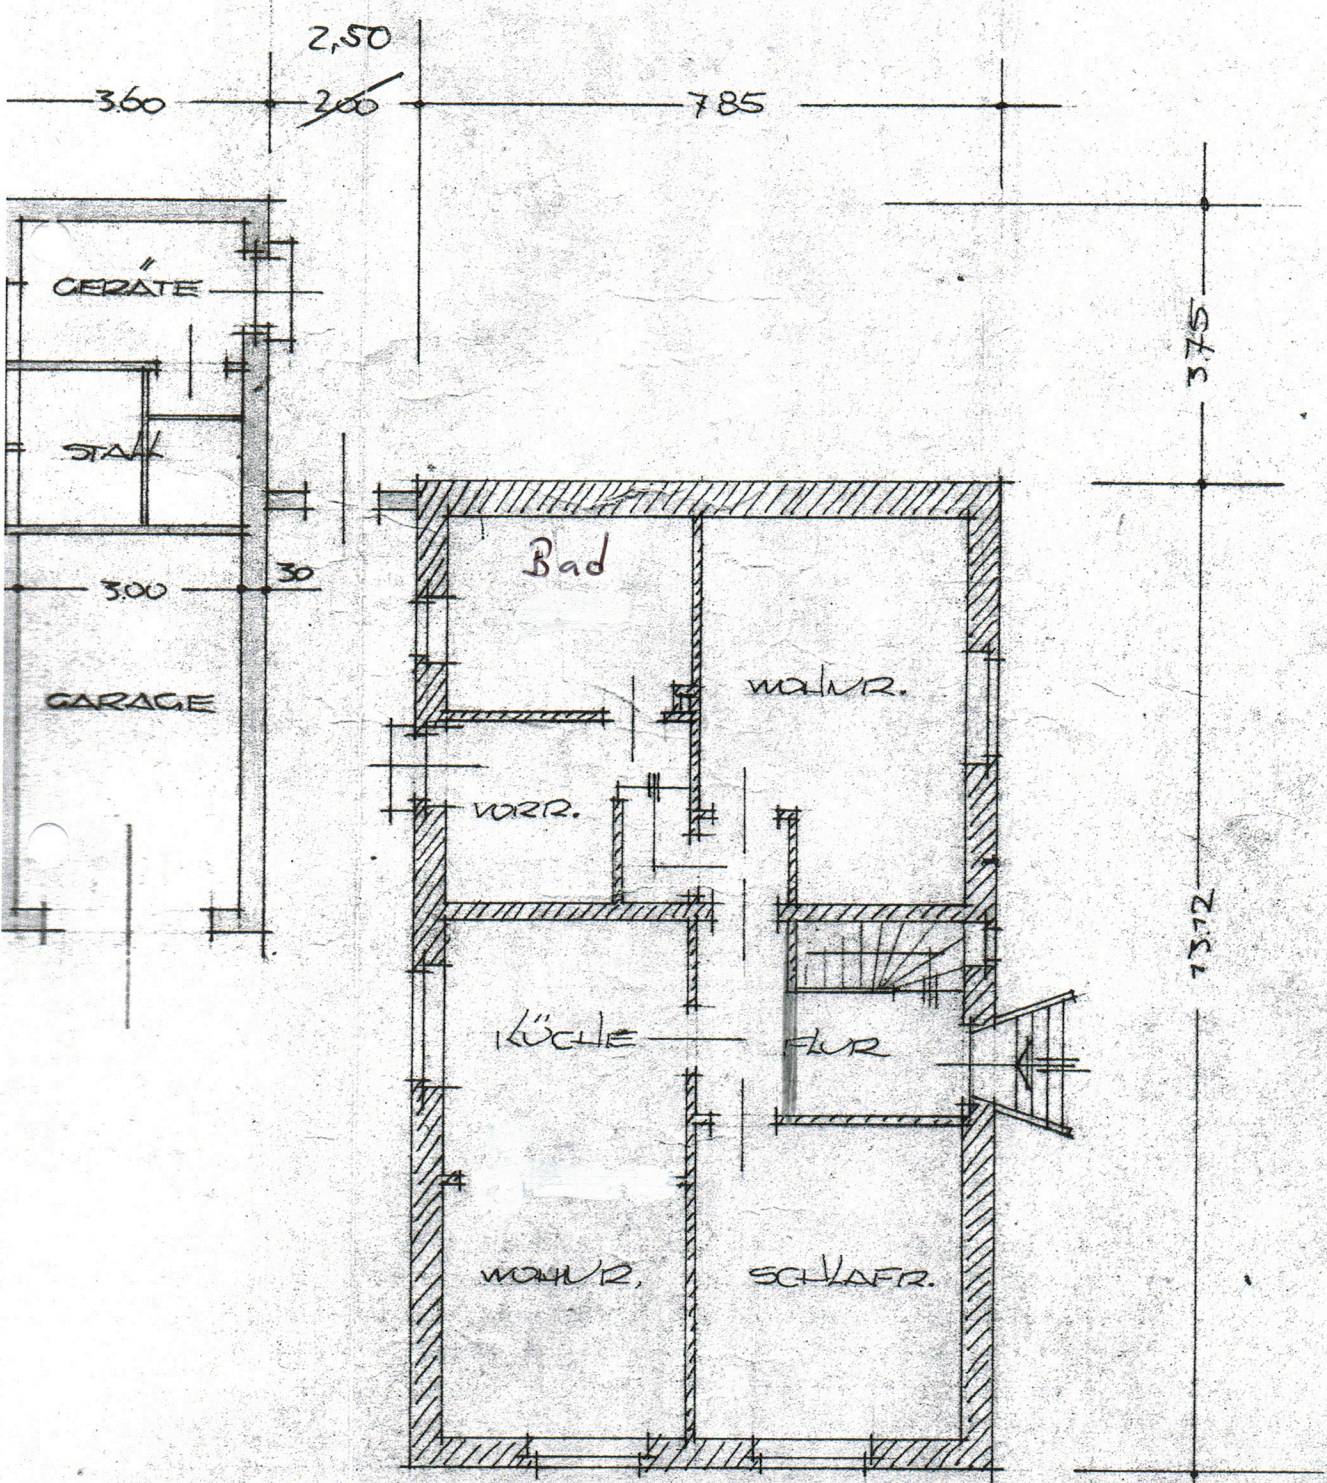

Hochst. 78 EG