




Westansicht M 1: 100

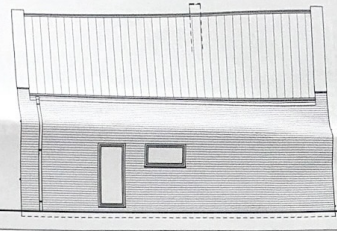


Nordansicht M 1: 100

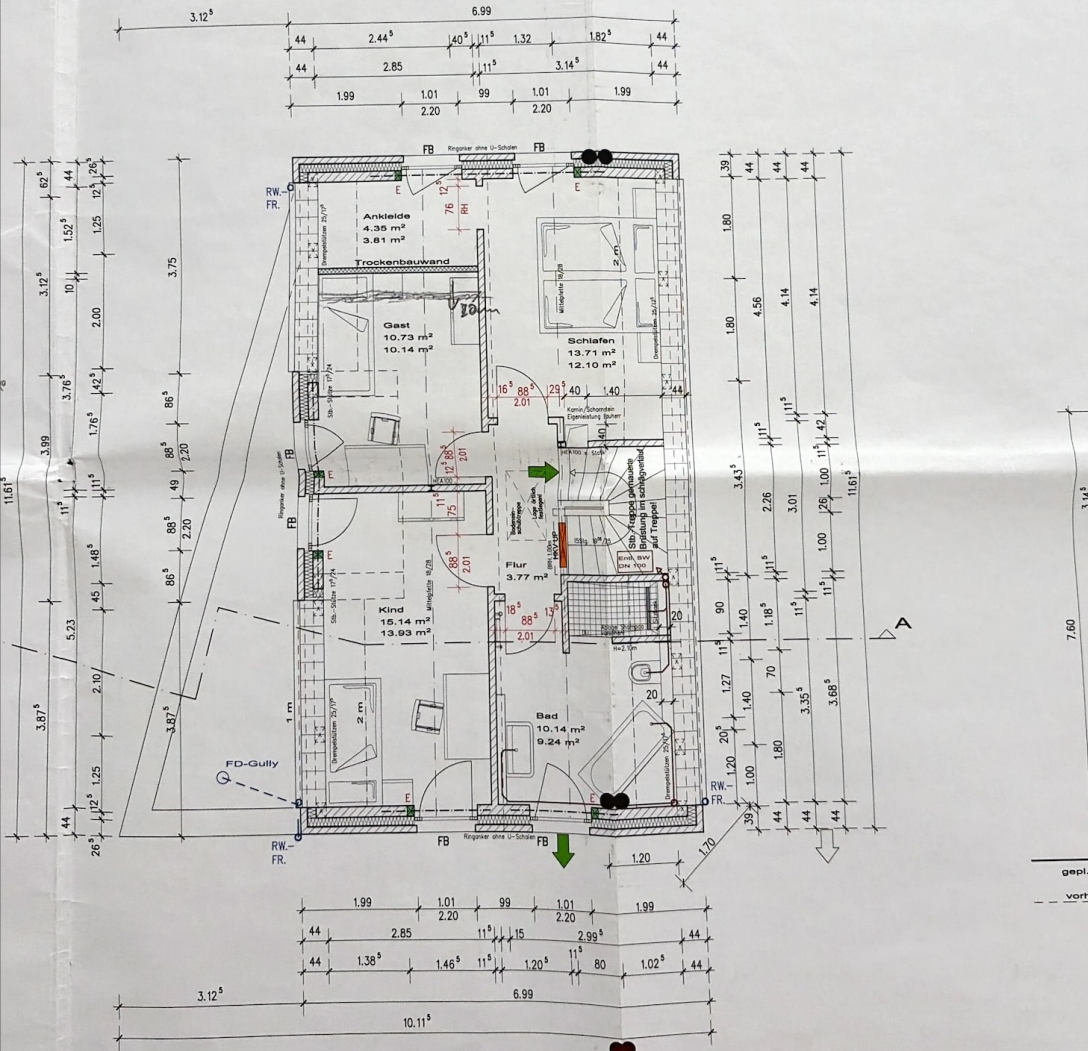

Dachgeschoss M 1: 50

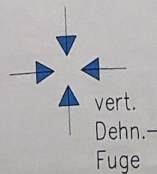

vert.  
Dehn.-  
Fuge

 

D 1

SW DN 100  
DD 15/15  
WS 15/15

D 5

DD 10/10  
für ELT.