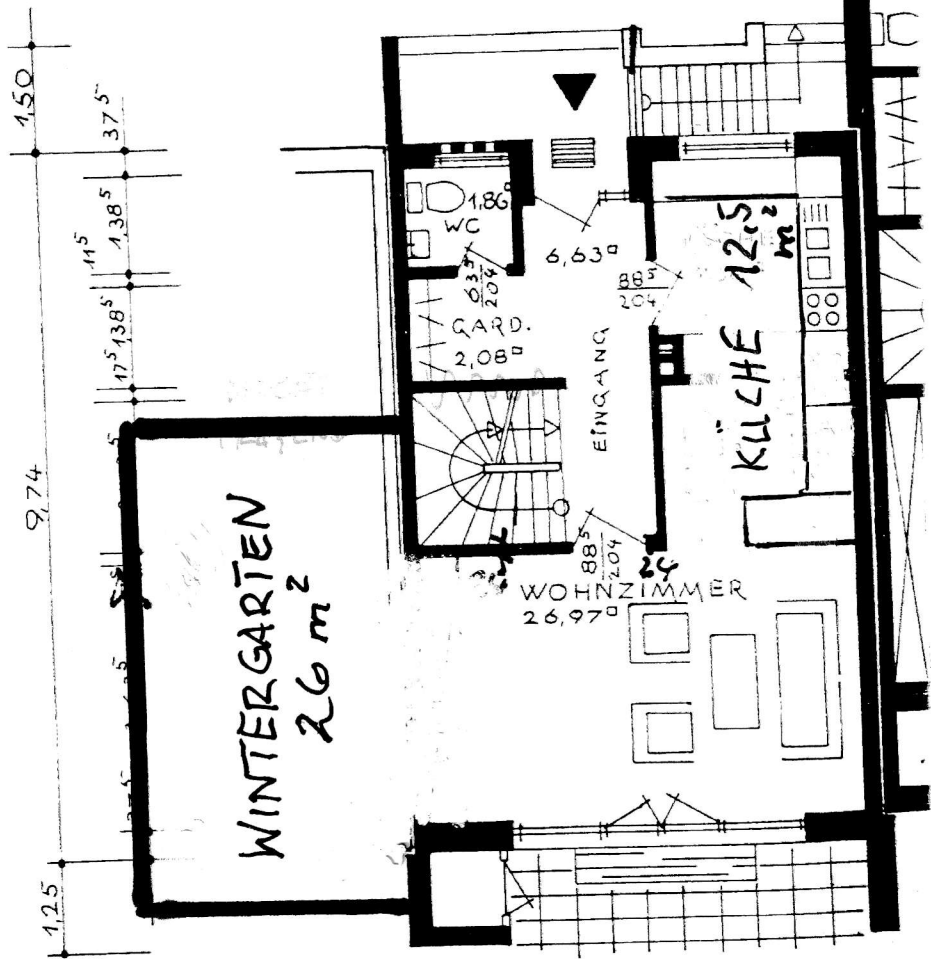
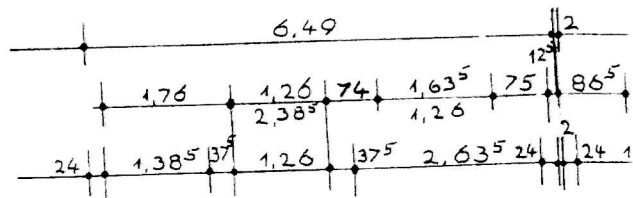
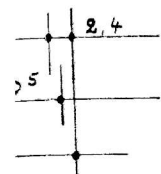
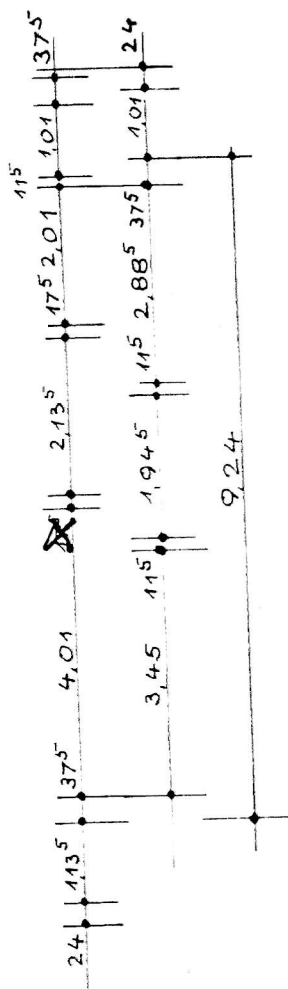
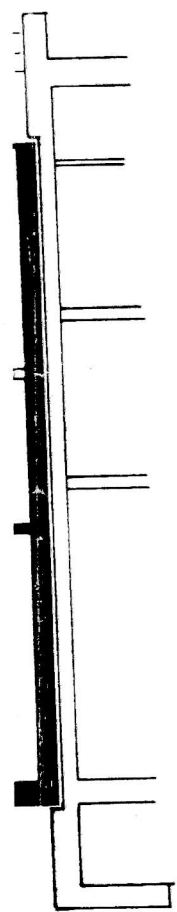


TYP B

T