


Keller / Garage

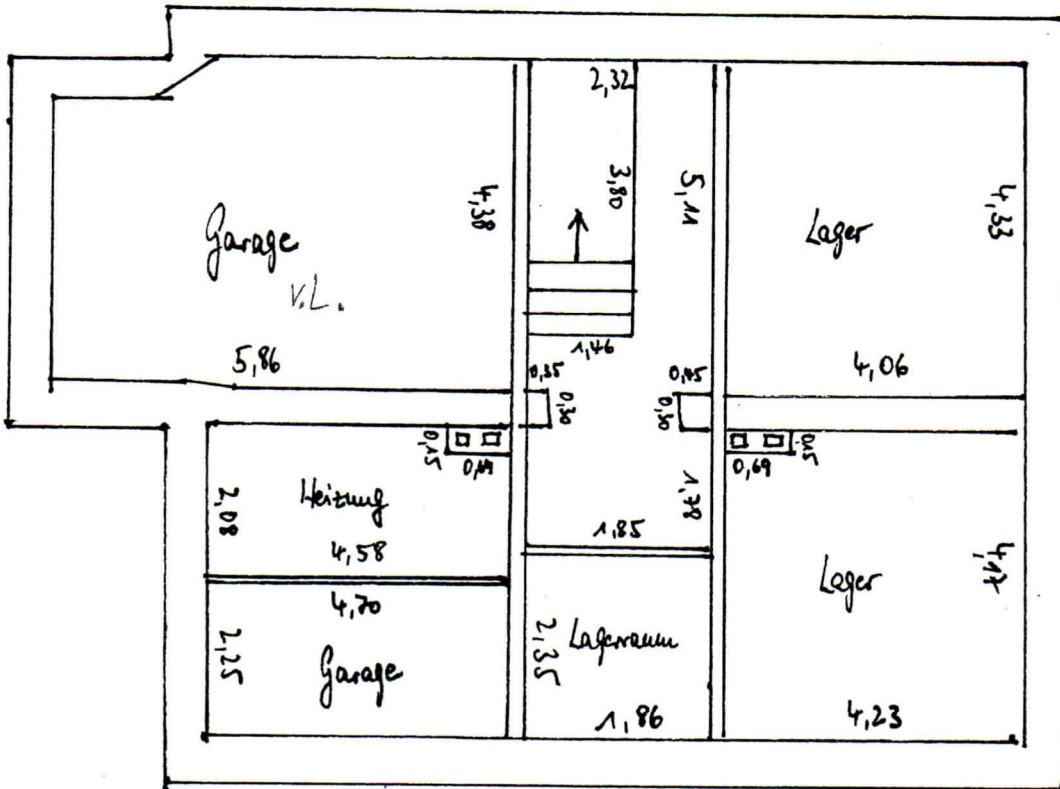

Erdgeschoss

